MAP OF SURVEY AND LOT SPLIT

PREPARED FOR

L.L.L. AND S. PARTNERS

SITUATED IN THE TOWNSHIP OF PITTSFIELD, COUNTY OF LORAIN, STATE OF OHIO AND BEING PART OF ORIGINAL PITTSFIELD TOWNSHIP LOT NUMBER 17.

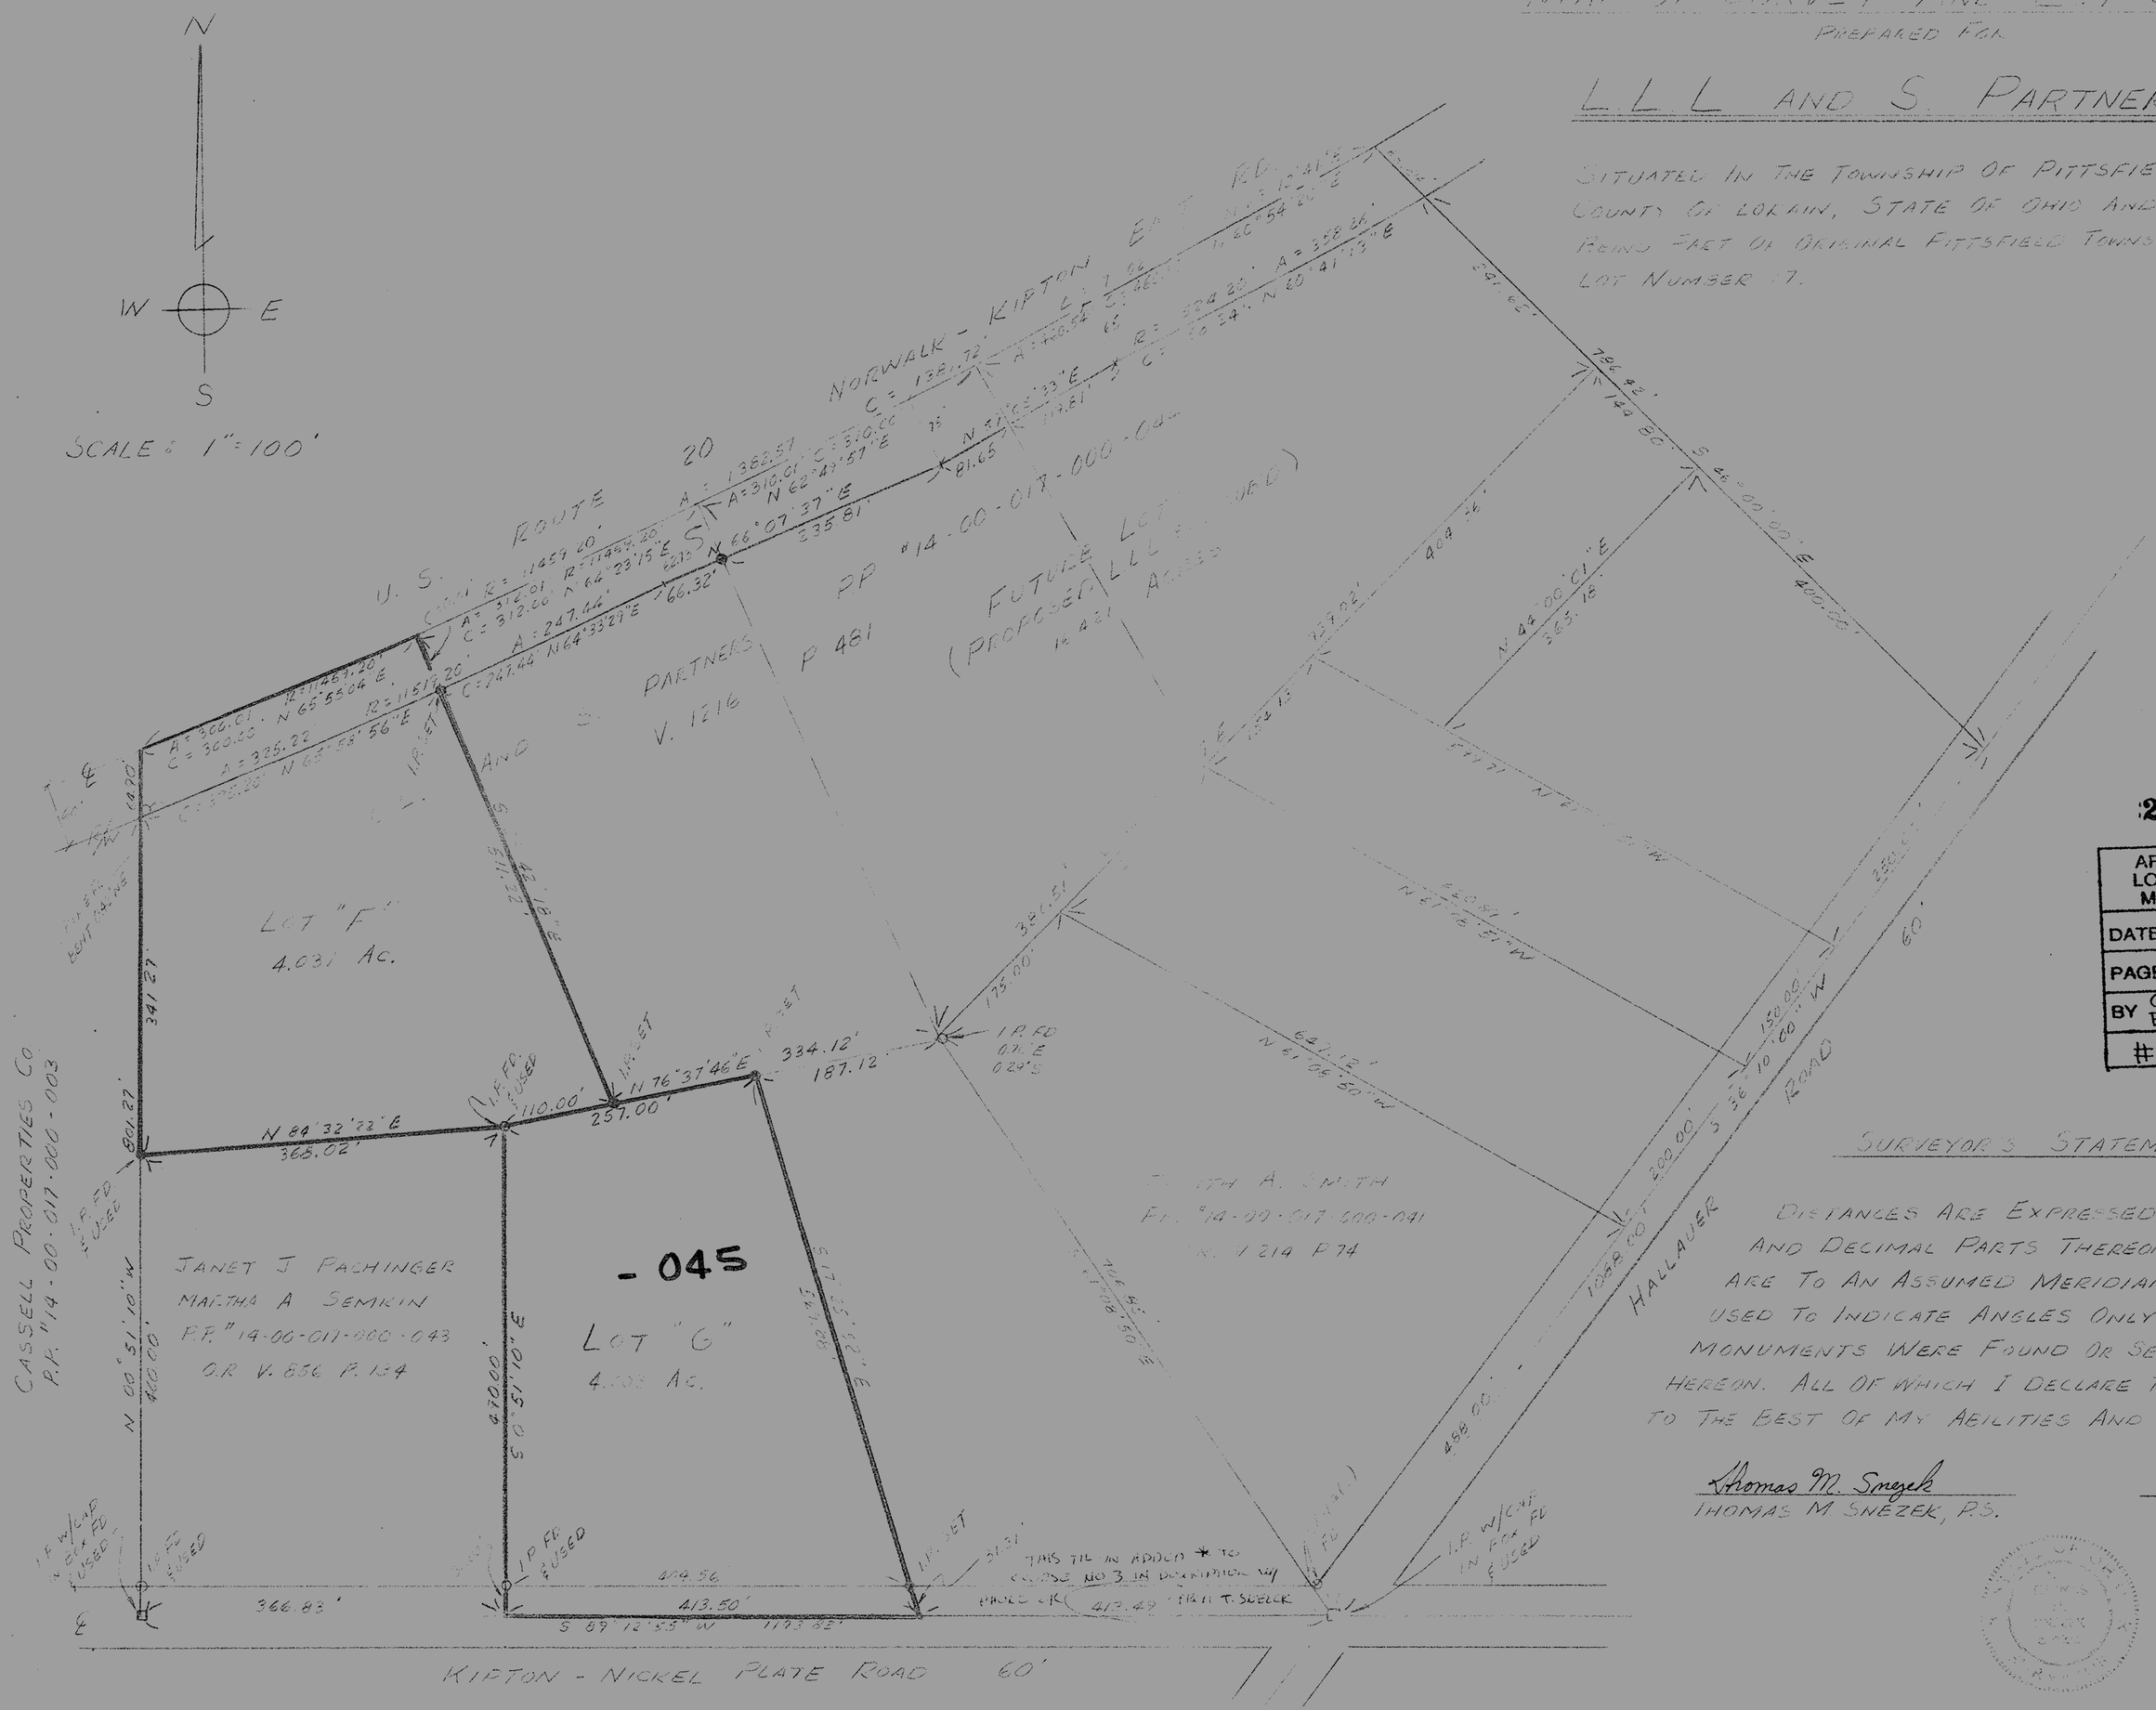

21298

APPROVED
LORAIN CO.
MAP DEPT
DATE 3-27-95
PAGE 14-C
BY CAROLYN FRANCIS
21298

SURVEYOR'S STATEMENT

DISTANCES ARE EXPRESSED IN FEET AND DECIMAL PARTS THEREOF. BEARINGS ARE TO AN ASSUMED MERIDIAN AND ARE USED TO INDICATE ANGLES ONLY. PERMANENT MONUMENTS WERE FOUND OR SET AS INDICATED HEREON. ALL OF WHICH I DECLARE TO BE CORRECT TO THE BEST OF MY ABILITIES AND BELIEF.

Thomas M. Snezek
THOMAS M. SNEZEK, P.S.

REV 2-3-15
12-6-94
DATE