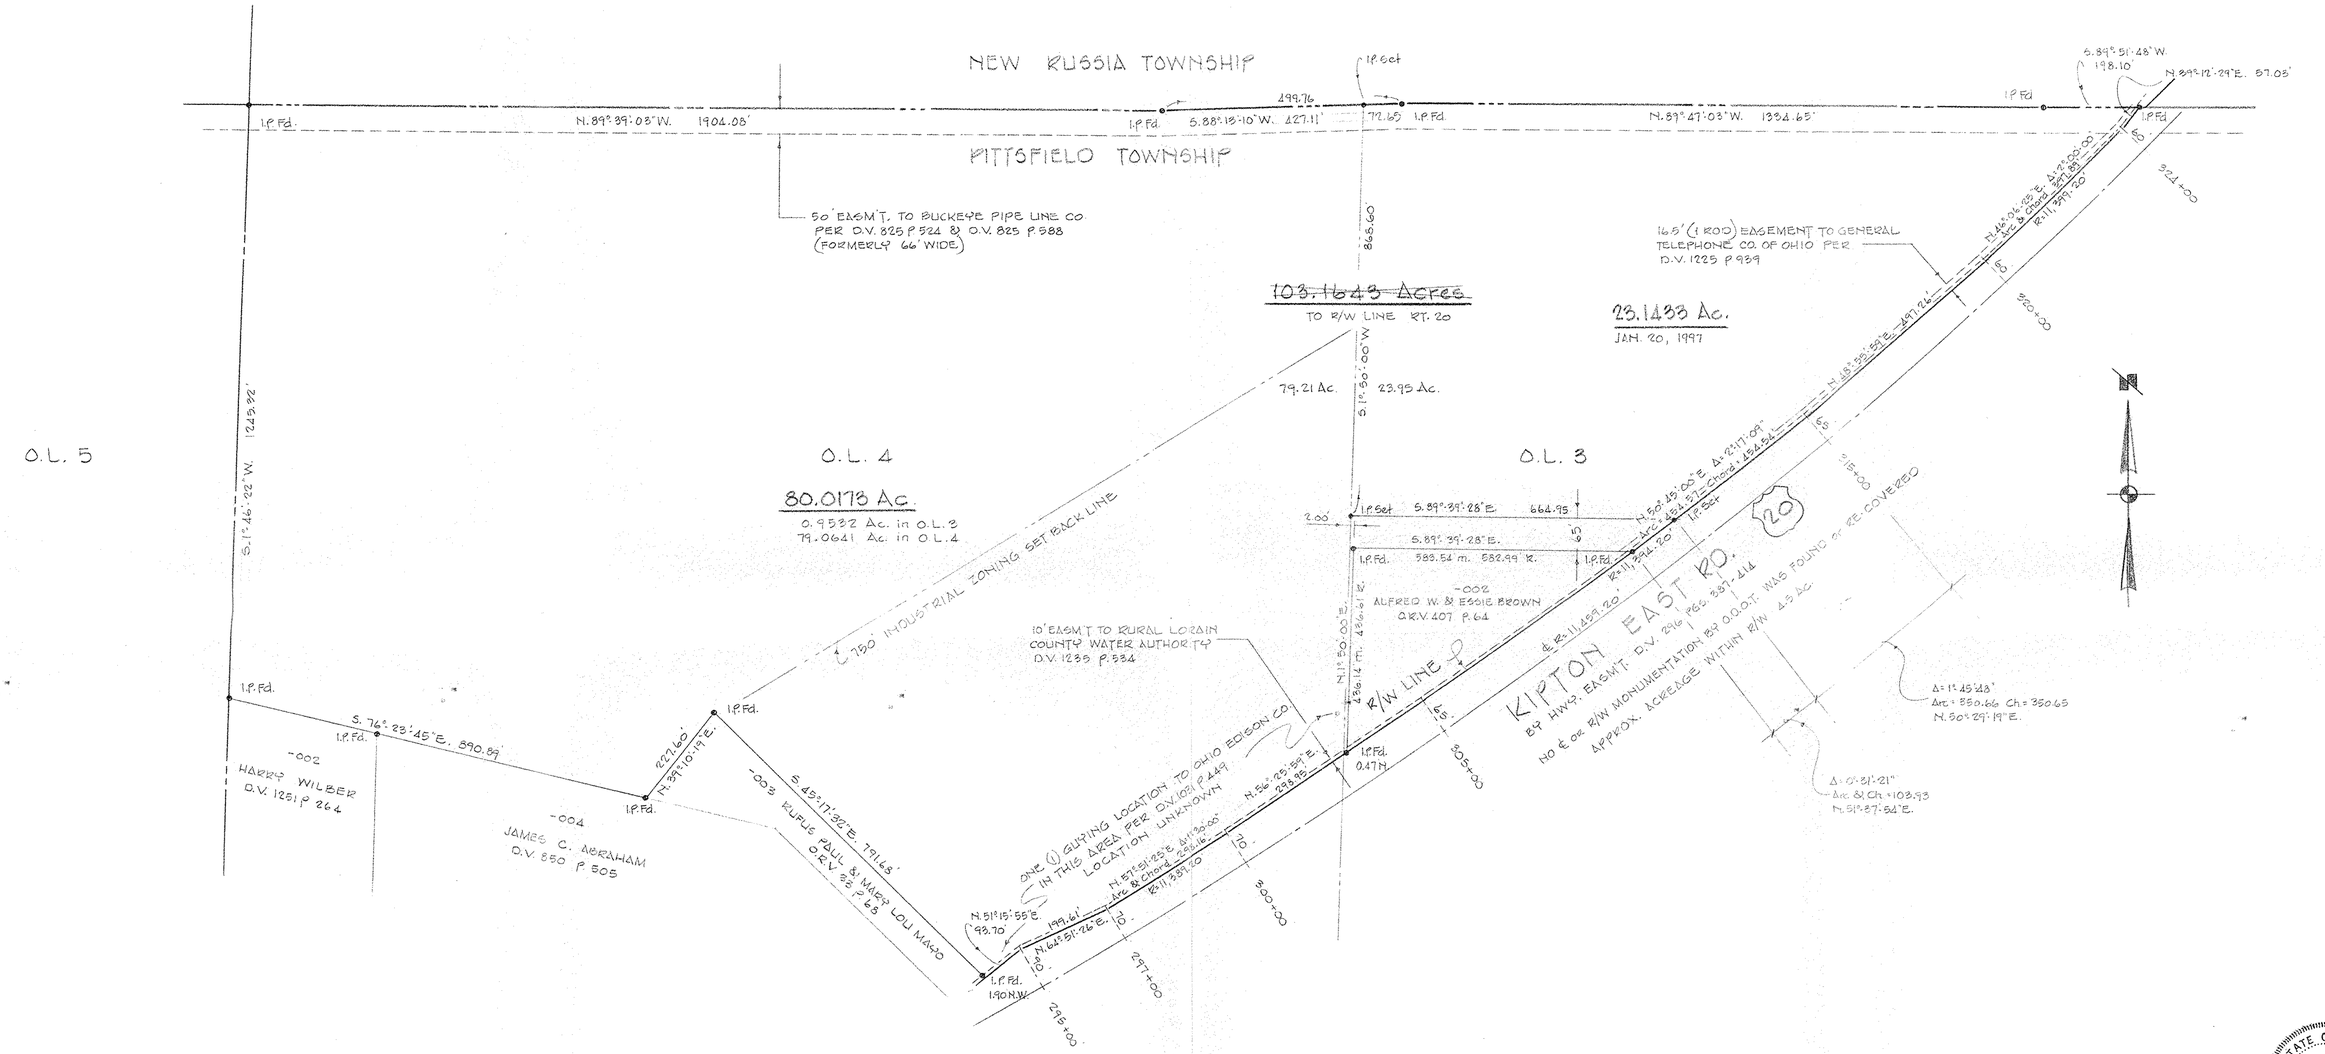

SURVEY FOR THE ESTATE OF

MELVIN C. HURST

PART OF O.L.s 2 & 4 — TOWNSHIP OF PITTSFIELD

COUNTY OF LORAIN — STATE OF OHIO

SCALE 1" = 150' — AUGUST 1996

LAUNDON • SIMON • CAHL & ASSOC.
PROFESSIONAL LAND SURVEYORS

JOB No. 96-2871 — F.B. 229 P. 41-43

REV. OCT. 7, 1997 Corr. dist. in N.R.
REV. JAN. 20, 1997 - 23.1433 Ac. REL.