MORRIS.DWG

| LINE | BEARING | DISTANCE |
|---|---|---|
| L1 | N 89°05'28" E | 24.58' |
| L2 | N 00°54'32" W | 52.08' |
| L3 | N 89°05'28" E | 19.18' |
| L4 | S 58°48'19" E | 9.08' |
| L5 | N 31°11'41" E | 70.00' |
| L6 | S 58°48'19" E | 30.34' |
| L7 | N 31°50'47" E | 142.11' |
| L8 | N 45°00'00" E | 116.14' |
| L9 | N 45°00'00" W | 100.00' |
| L10 | S 31°11'41" W | 258.71' |
| L11 | N 58°48'19" W | 157.08' |
| L12 | N 31°11'41" E | 19.17' |
| L13 | N 58°48'19" W | 60.00' |
| L14 | S 31°11'41" W | 19.17' |
| L15 | N 58°48'19" W | 159.58' |
| L16 | N 31°11'41" E | 170.00' |
| L17 | N 58°51'39" W | 107.95' |
| L18 | N 33°54'13" W | 156.10' |
| L19 | N 40°56'38" E | 15.96' |
| L20 | N 40°56'38" E | 60.00' |
| L21 | N 40°56'38" E | 15.95' |

| CURVE | RADIUS | ARC LENGTH | CHORD LENGTH | CHORD BEARING | DELTA ANGLE | TANGENT |
|---|---|---|---|---|---|---|
| C1 | 530.00' | 6.03' | 6.03' | S 58°28'46" E | 00°39'06" | 3.01' |
| C2 | 405.00' | 67.04' | 66.97' | N 45°41'10" E | 09°29'04" | 33.60' |
| C3 | 25.00' | 39.27' | 35.36' | N 85°56'38" E | 90°00'00" | 25.00' |
| C4 | 25.00' | 39.27' | 35.36' | N 04°03'22" W | 90°00'00" | 25.00' |
| C5 | 291.42' | 147.00' | 145.45' | N 26°29'36" E | 28°54'03" | 75.10' |
| C6 | 25.00' | 5.03' | 5.03' | N 25°25'34" E | 11°32'13" | 2.53' |
| C7 | 25.00' | 5.03' | 5.03' | S 36°57'47" W | 11°32'13" | 2.53' |

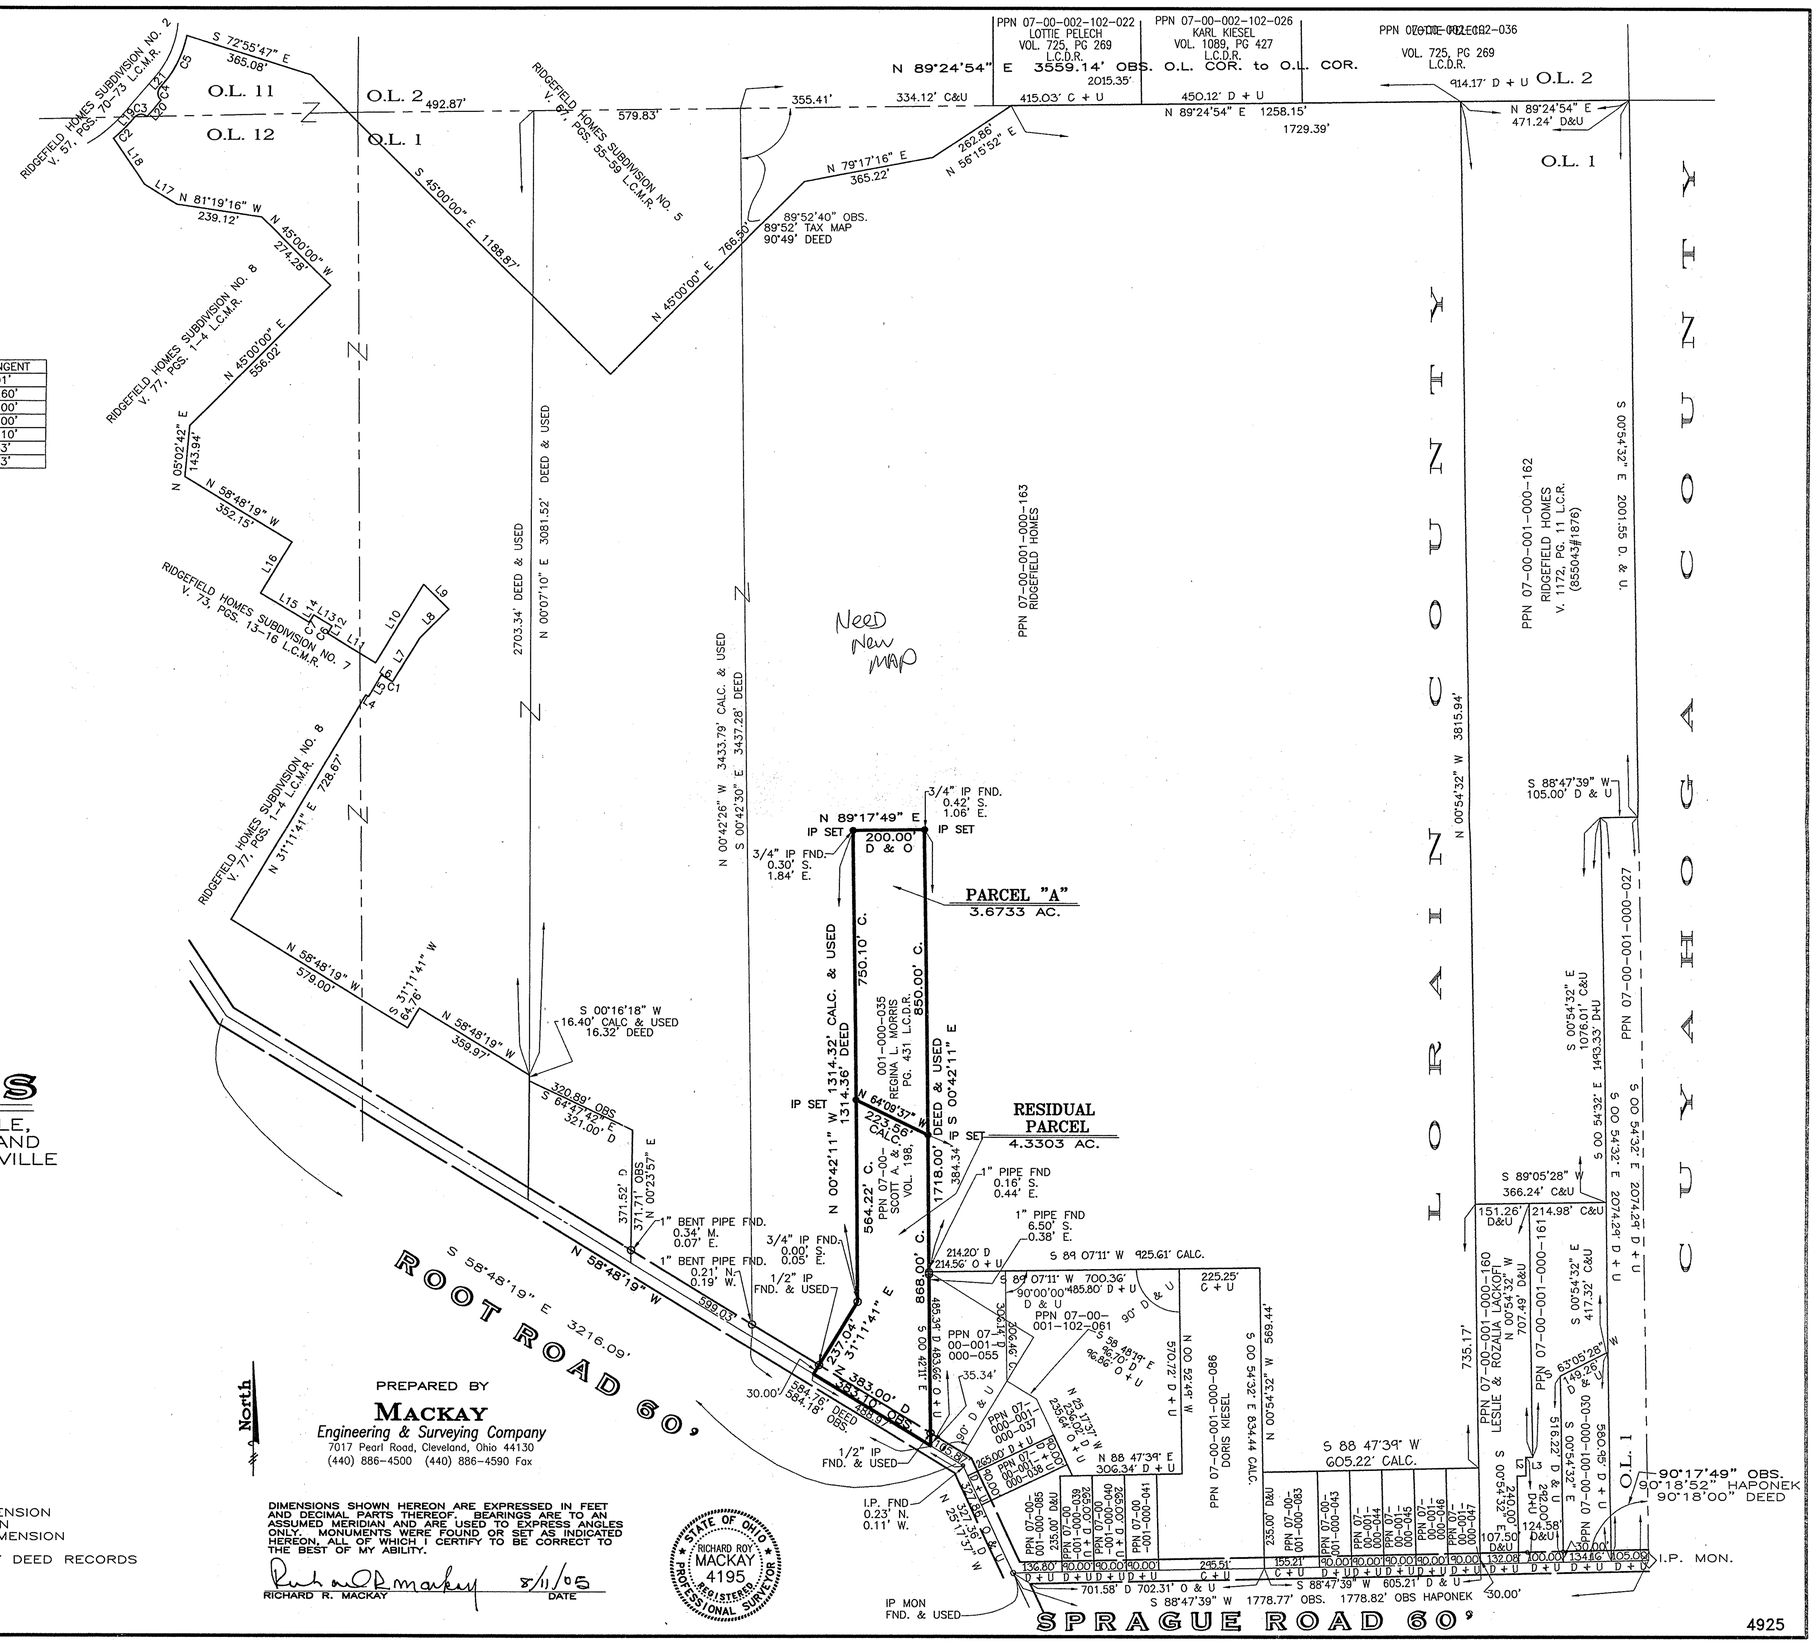
PPN 07-00-002-102-022
LOTTIE PELECH
VOL. 725, PG 269
L.C.D.R.
PPN 07-00-002-102-026
KARL KIESEL
VOL. 1089, PG 427
L.C.D.R.
PPN 07-00-002-102-036
VOL. 725, PG 269
L.C.D.R.
N 89°24'54" E 3559.14' OBS. O.L. COR. to O.L. COR.
2015.35'
415.03' C + U
450.12' D + U
N 89°24'54" E 1258.15'
1729.39'
914.17' D + U
O.L. 2
N 89°24'54" E
471.24' D&U
O.L. 1
334.12' C&U
355.41'
262.86'
N 56°15'52" E
N 79°17'16" E
365.22'
89°52'40" OBS.
89°52' TAX MAP
90°49' DEED
N 45°00'00" E 766.50'
S 45°00'00" E 1188.87'
579.83'
492.87'
O.L. 11
O.L. 12
O.L. 2
O.L. 1
S 72°55'47" E
365.08'
RIDGEFIELD HOMES SUBDIVISION NO. 2
V. 57, PGS. 70-73 L.C.M.R.
RIDGEFIELD HOMES SUBDIVISION NO. 5
V. 67, PGS. 55-59 L.C.M.R.
N 81°19'16" W
239.12'
N 45°00'00" W
274.28'
RIDGEFIELD HOMES SUBDIVISION NO. 8
V. 77, PGS. 1-4 L.C.M.R.
N 45°00'00" E
556.02'
N 05°02'42" E
143.94'
N 58°48'19" W
352.15'
RIDGEFIELD HOMES SUBDIVISION NO. 7
V. 73, PGS. 13-16 L.C.M.R.
RIDGEFIELD HOMES SUBDIVISION NO. 8
V. 77, PGS. 1-4 L.C.M.R.
N 31°11'41" E 728.67'
N 58°48'19" W
579.00'
S 31°11'41" W
64.76'
N 58°48'19" W
359.97'
S 00°16'18" W
16.40' CALC. & USED
16.32' DEED
320.89' OBS.
S 64°47'42" E
321.00' D
371.52' D
371.71' OBS.
N 00°23'57" E
1" BENT PIPE FND.
0.34' N.
0.07' E.
1" BENT PIPE FND.
0.21' N.
0.19' W.
N 58°48'19" W
592.03'
S 58°48'19" E 3216.09'
ROOT ROAD 60'
2703.34' DEED & USED
N 00°07'10" E 3081.52' DEED & USED
N 00°42'26" W 3433.79' CALC. & USED
S 00°42'30" E 3437.28' DEED
Need New MAP
PPN 07-00-001-000-163
RIDGEFIELD HOMES
N 89°17'49" E
IP SET
200.00'
D & O
3/4" IP FND.
0.30' S.
1.84' E.
3/4" IP FND.
0.42' S.
1.06' E.
IP SET
PARCEL "A"
3.6733 AC.
750.10' C.
850.00' C.
1718.00' C.
868.00' C.
564.22' C.
PPN 07-00-001-000-035
REGINA L. MORRIS
PG. 431 L.C.D.R.
PPN 07-00-
SCOTT A. & LORI
VOL. 198,
N 00°42'11" W 1314.32' CALC. & USED
1314.36' DEED
N 64°09'37" W
223.56' CALC.
S 00°42'11" E
384.34'
IP SET
RESIDUAL PARCEL
4.3303 AC.
1" PIPE FND
0.16' S.
0.44' E.
1" PIPE FND
6.50' S.
0.38' E.
214.20' D
214.56' O + U
S 89°07'11" W 925.61' CALC.
S 89°07'11" W 700.36'
485.80' D + U
90°00'00"
D & U
PPN 07-00-001-102-061
225.25'
C + U
PPN 07-00-001-000-055
PPN 07-00-001-000-037
PPN 07-00-001-000-086
DORIS KIESEL
570.72' D + U
N 00°52'49" W
N 00°54'32" W 569.44'
S 00°54'32" W
N 88°47'39" E
306.34' D + U
S 88°47'39" W
605.22' CALC.
N 00°54'32" W 3815.94'
S 00°54'32" E 2015.55' D. & U.
S 88°47'39" W
105.00' D & U
PPN 07-00-001-000-027
S 00°54'32" E
1076.01' C&U
1493.33' D+U
S 00°54'32" E
417.32' C&U
S 00°54'32" E 2074.29' D + U
S 89°05'28" W
366.24' C&U
151.26'
D&U
214.98' C&U
PPN 07-00-001-000-160
LESLIE & ROZALIA LACKOFI
N 00°54'32" W
707.49' D&U
PPN 07-00-001-000-161
735.17'
PPN 07-00-001-000-030
S 63°05'28" W
149.28' D&U
S 00°54'32" E
515.62' D & U
S 00°54'32" E
292.00' D + U
107.50'
D&U
124.58'
D&U
30.00'
90°17'49" OBS.
90°18'52" HAPONEK
90°18'00" DEED
I.P. MON.
30.00'
S 88°47'39" W 605.21' D & U
701.58' D 702.31' O & U
S 88°47'39" W 1778.77' OBS. 1778.82' OBS HAPONEK
IP MON
FND. & USED
SPRAGUE ROAD 60'
LORAIN COUNTY
YONKOF
1" PIPE FND
0.16' S.
0.44' E.
3/4" IP FND.
0.00' S.
0.05' E.
1/2" IP
FND. & USED
30.00'
584.78' DEED
584.18'
OBS.
1/2" IP
FND. & USED
I.P. FND
0.23' N.
0.11' W.
N 31°11'41" E
383.00' D
383.10' OBS.
S 00°42'11" E
456.97' D 456.66' O + U
N 00°42'11" W
S 31°11'41" W
237.04'
