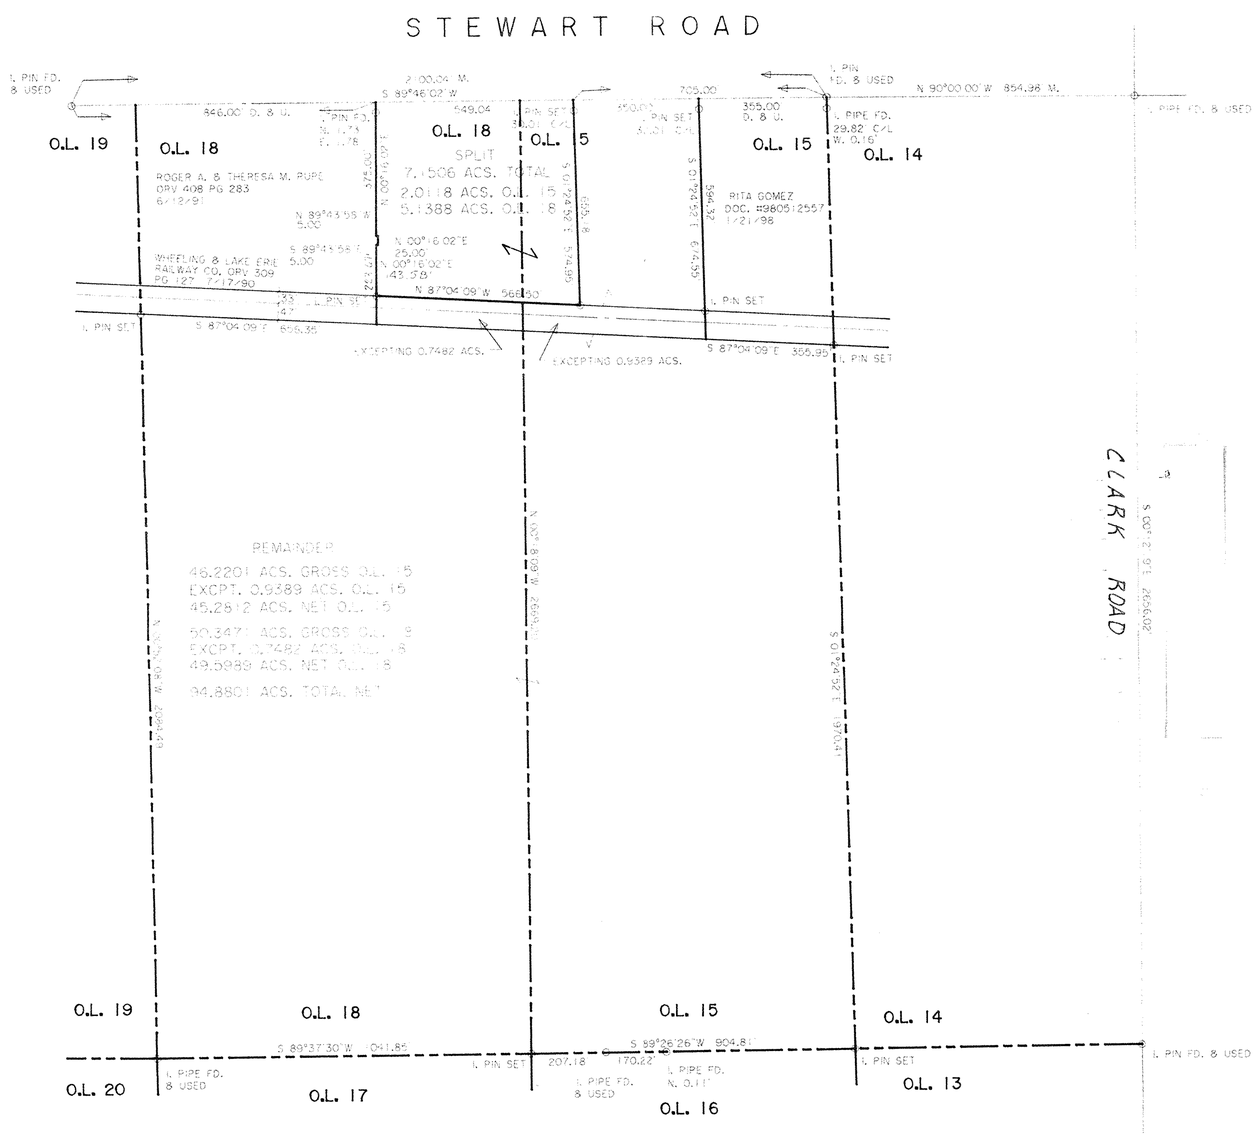

DIMENSIONS SHOWN ON THIS PLAT ARE EXPRESSED IN FEET AND DECIMAL PARTS THEREOF. ALL BEARINGS ARE TO AN ASSUMED MERIDIAN AND ARE USED TO INDICATE ANGLES ONLY. PERMANENT MONUMENTS WERE FOUND OR SET AT ALL POINTS INDICATED HEREON. ALL OF WHICH I CERTIFY TO BE CORRECT.

STATE OF OHIO
THOMAS A. SIMON
S-7775
REGISTERED
PROFESSIONAL SURVEYOR

THOMAS A. SIMON
REG. PROFESSIONAL SURVEYOR
NO. S-7775

BASIS OF BEARINGS IS THE CENTERLINE OF STEWART ROAD (NORTH 90°00'00" WEST). IRON PINS SET ARE 5/8" DIAMETER 30" LONG WITH PLASTIC CAPS "T. SIMON, S-7775".

PLAT OF SURVEY
FOR
JAMES AND FRANCES ROLLIN

BEING KNOWN AS PARTS OF ORIGINAL LOT NOS. 15 AND 18
TRACT 2, HUNTINGTON TOWNSHIP

COUNTY OF LORAIN STATE OF OHIO

MAY, 2002 SCALE: 1" = 200'

No 02038
DATE 11-2-05
PAGE 21-E
BY J Hatfield
05-02038

THOMAS SIMON & ASSOCIATES, INC.
PROFESSIONAL LAND SURVEYORS

COBBLESTONE CORNER PROFESSIONAL CENTER
38049 CENTER RIDGE ROAD
NORTH RIDGEVILLE, OHIO 44039
(440) 327-2925
FAX 327-2964

REV. 7/14/2005 7.1506 S