DIMENSIONS SHOWN ON THIS PLAT ARE EXPRESSED IN FEET AND DECIMAL PARTS THEREOF, ALL BEARINGS ARE TO AN ASSUMED MERIDIAN AND ARE USED TO INDICATE ANGLES ONLY. PERMANENT MONUMENTS WERE FOUND OR SET AT ALL POINTS INDICATED HEREON, ALL OF WHICH I CERTIFY TO BE CORRECT.

STATE OF OHIO
THOMAS A. SIMON
S-7775
REGISTERED
PROFESSIONAL SURVEYOR

THOMAS A. SIMON
REG. PROFESSIONAL SURVEYOR
NO. S-7775

200 0 200 400 600
GRAPHIC SCALE - FEET

BASIS OF BEARINGS IS THE CENTERLINE OF HAWLEY ROAD (NORTH 04°39'00" EAST). IRON PINS SET ARE 5/8" DIAMETER, 30" LONG WITH PLASTIC CAPS "T. SIMON, S-7775".

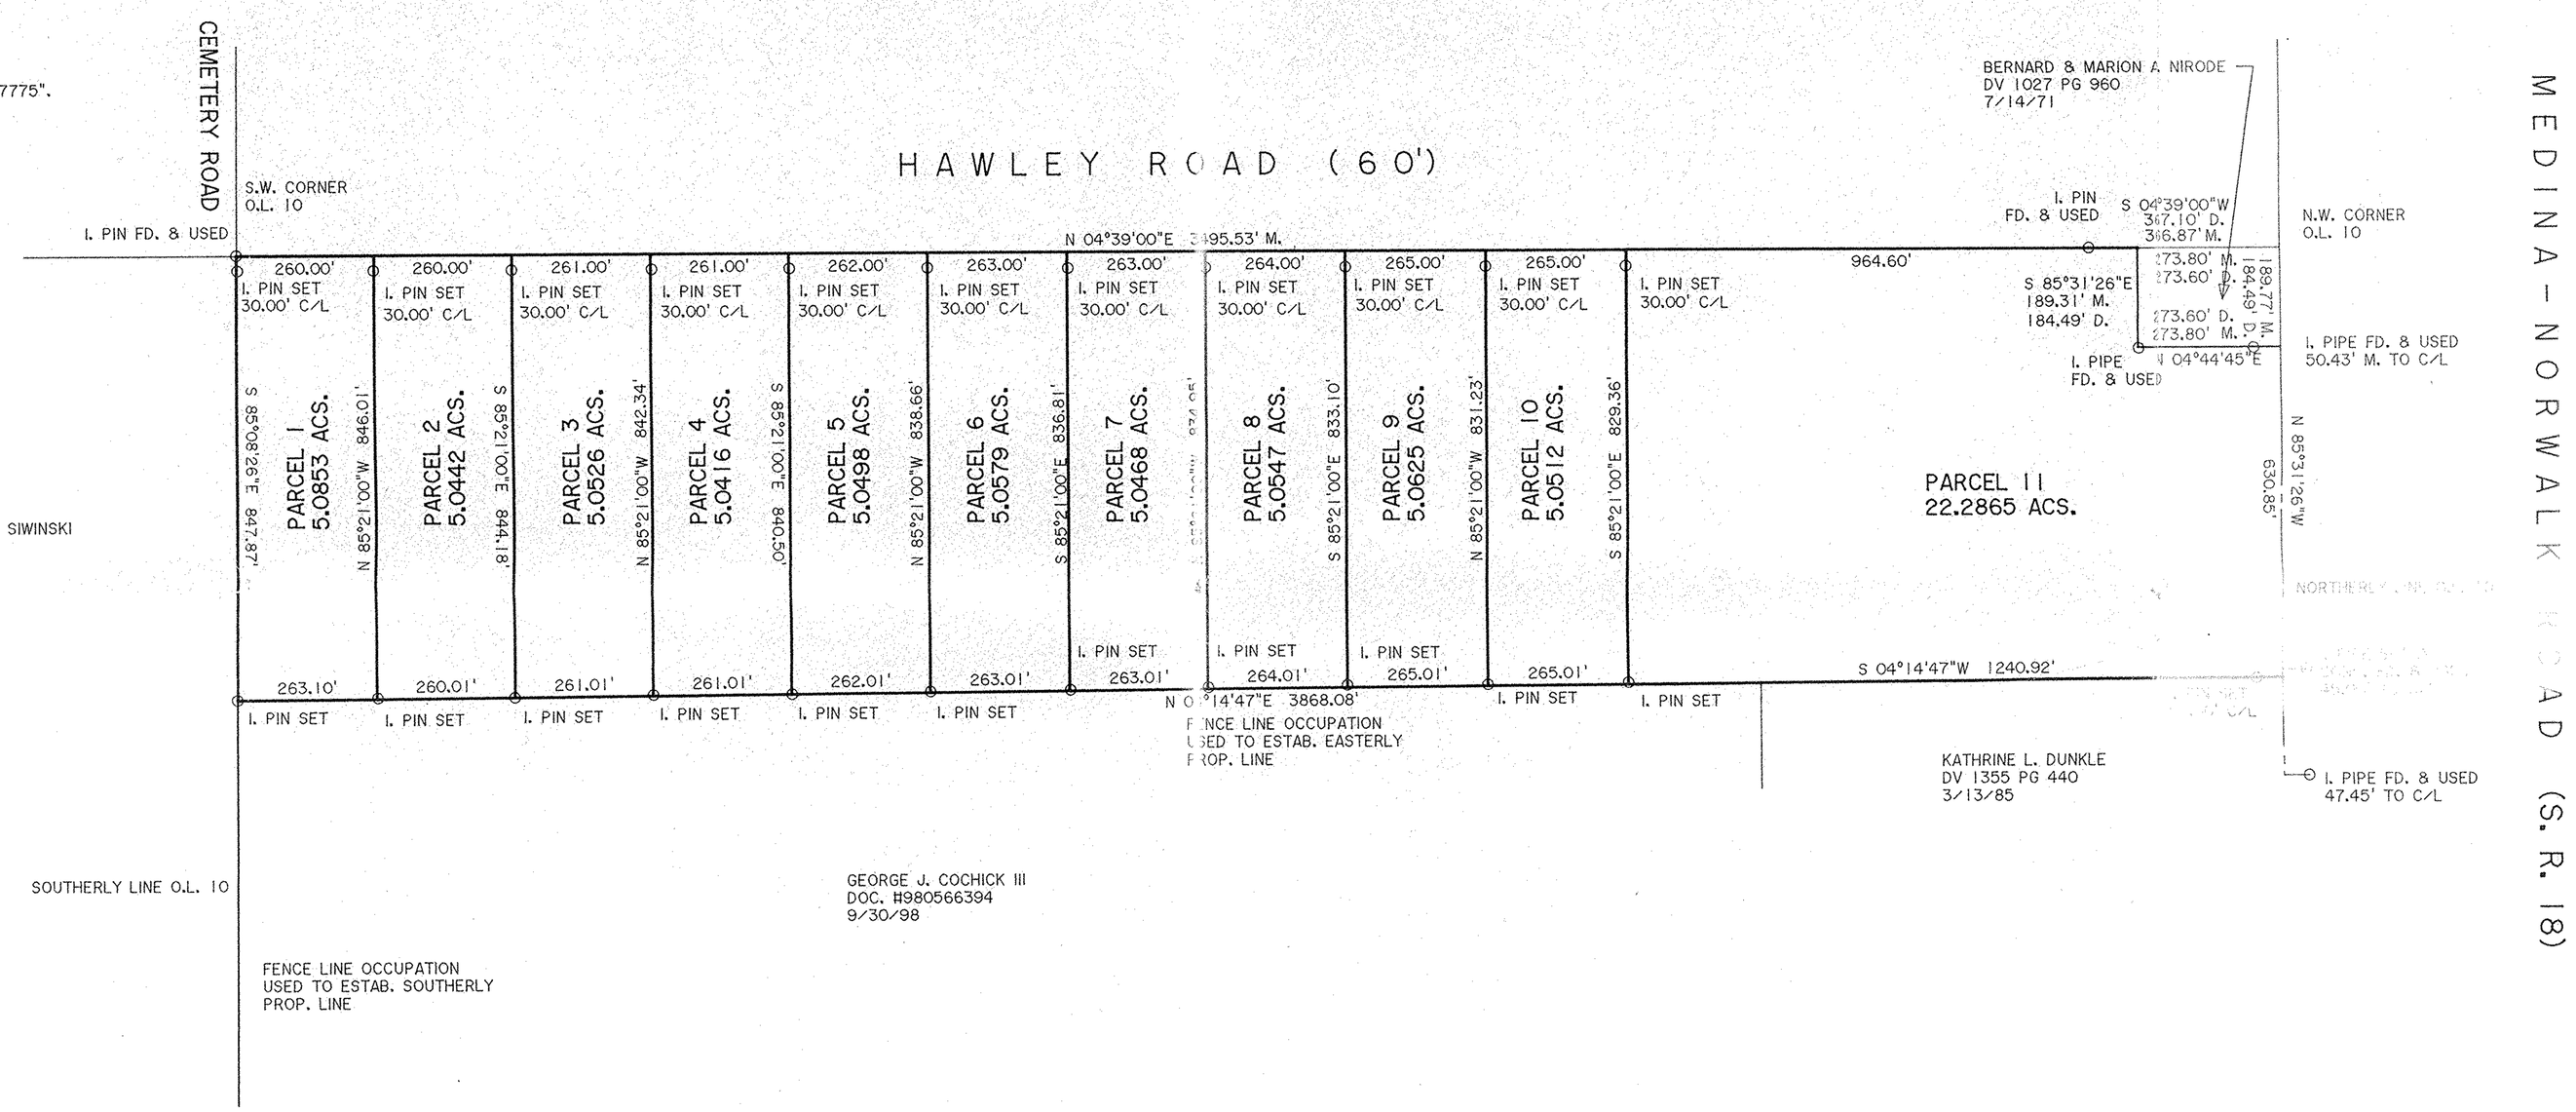

APPROVED
LORAIN CO.
MAP DEPT.
DATE 11-9-05
PAGE 18 00004
BY JMHaefeld
#05-0240

#02040

THOMAS SIMON & ASSOCIATES, INC.
PROFESSIONAL LAND SURVEYORS

COBBLESTONE CORNER PROFESSIONAL CENTER
39049 CENTER RIDGE ROAD
NORTH RIDGEVILLE, OHIO 44039
(440) 327-2925
FAX 327-2964

PLAT OF SURVEY AND SPLIT

FOR

CHARLENE K. NEPTUNE, TR.

BEING KNOWN AS PART OF WELLINGTON TOWNSHIP
ORIGINAL LOT NO. 10

COUNTY OF LORAIN STATE OF OHIO
JULY, 2000 SCALE: 1" = 200'

JOB NO. 2000-039