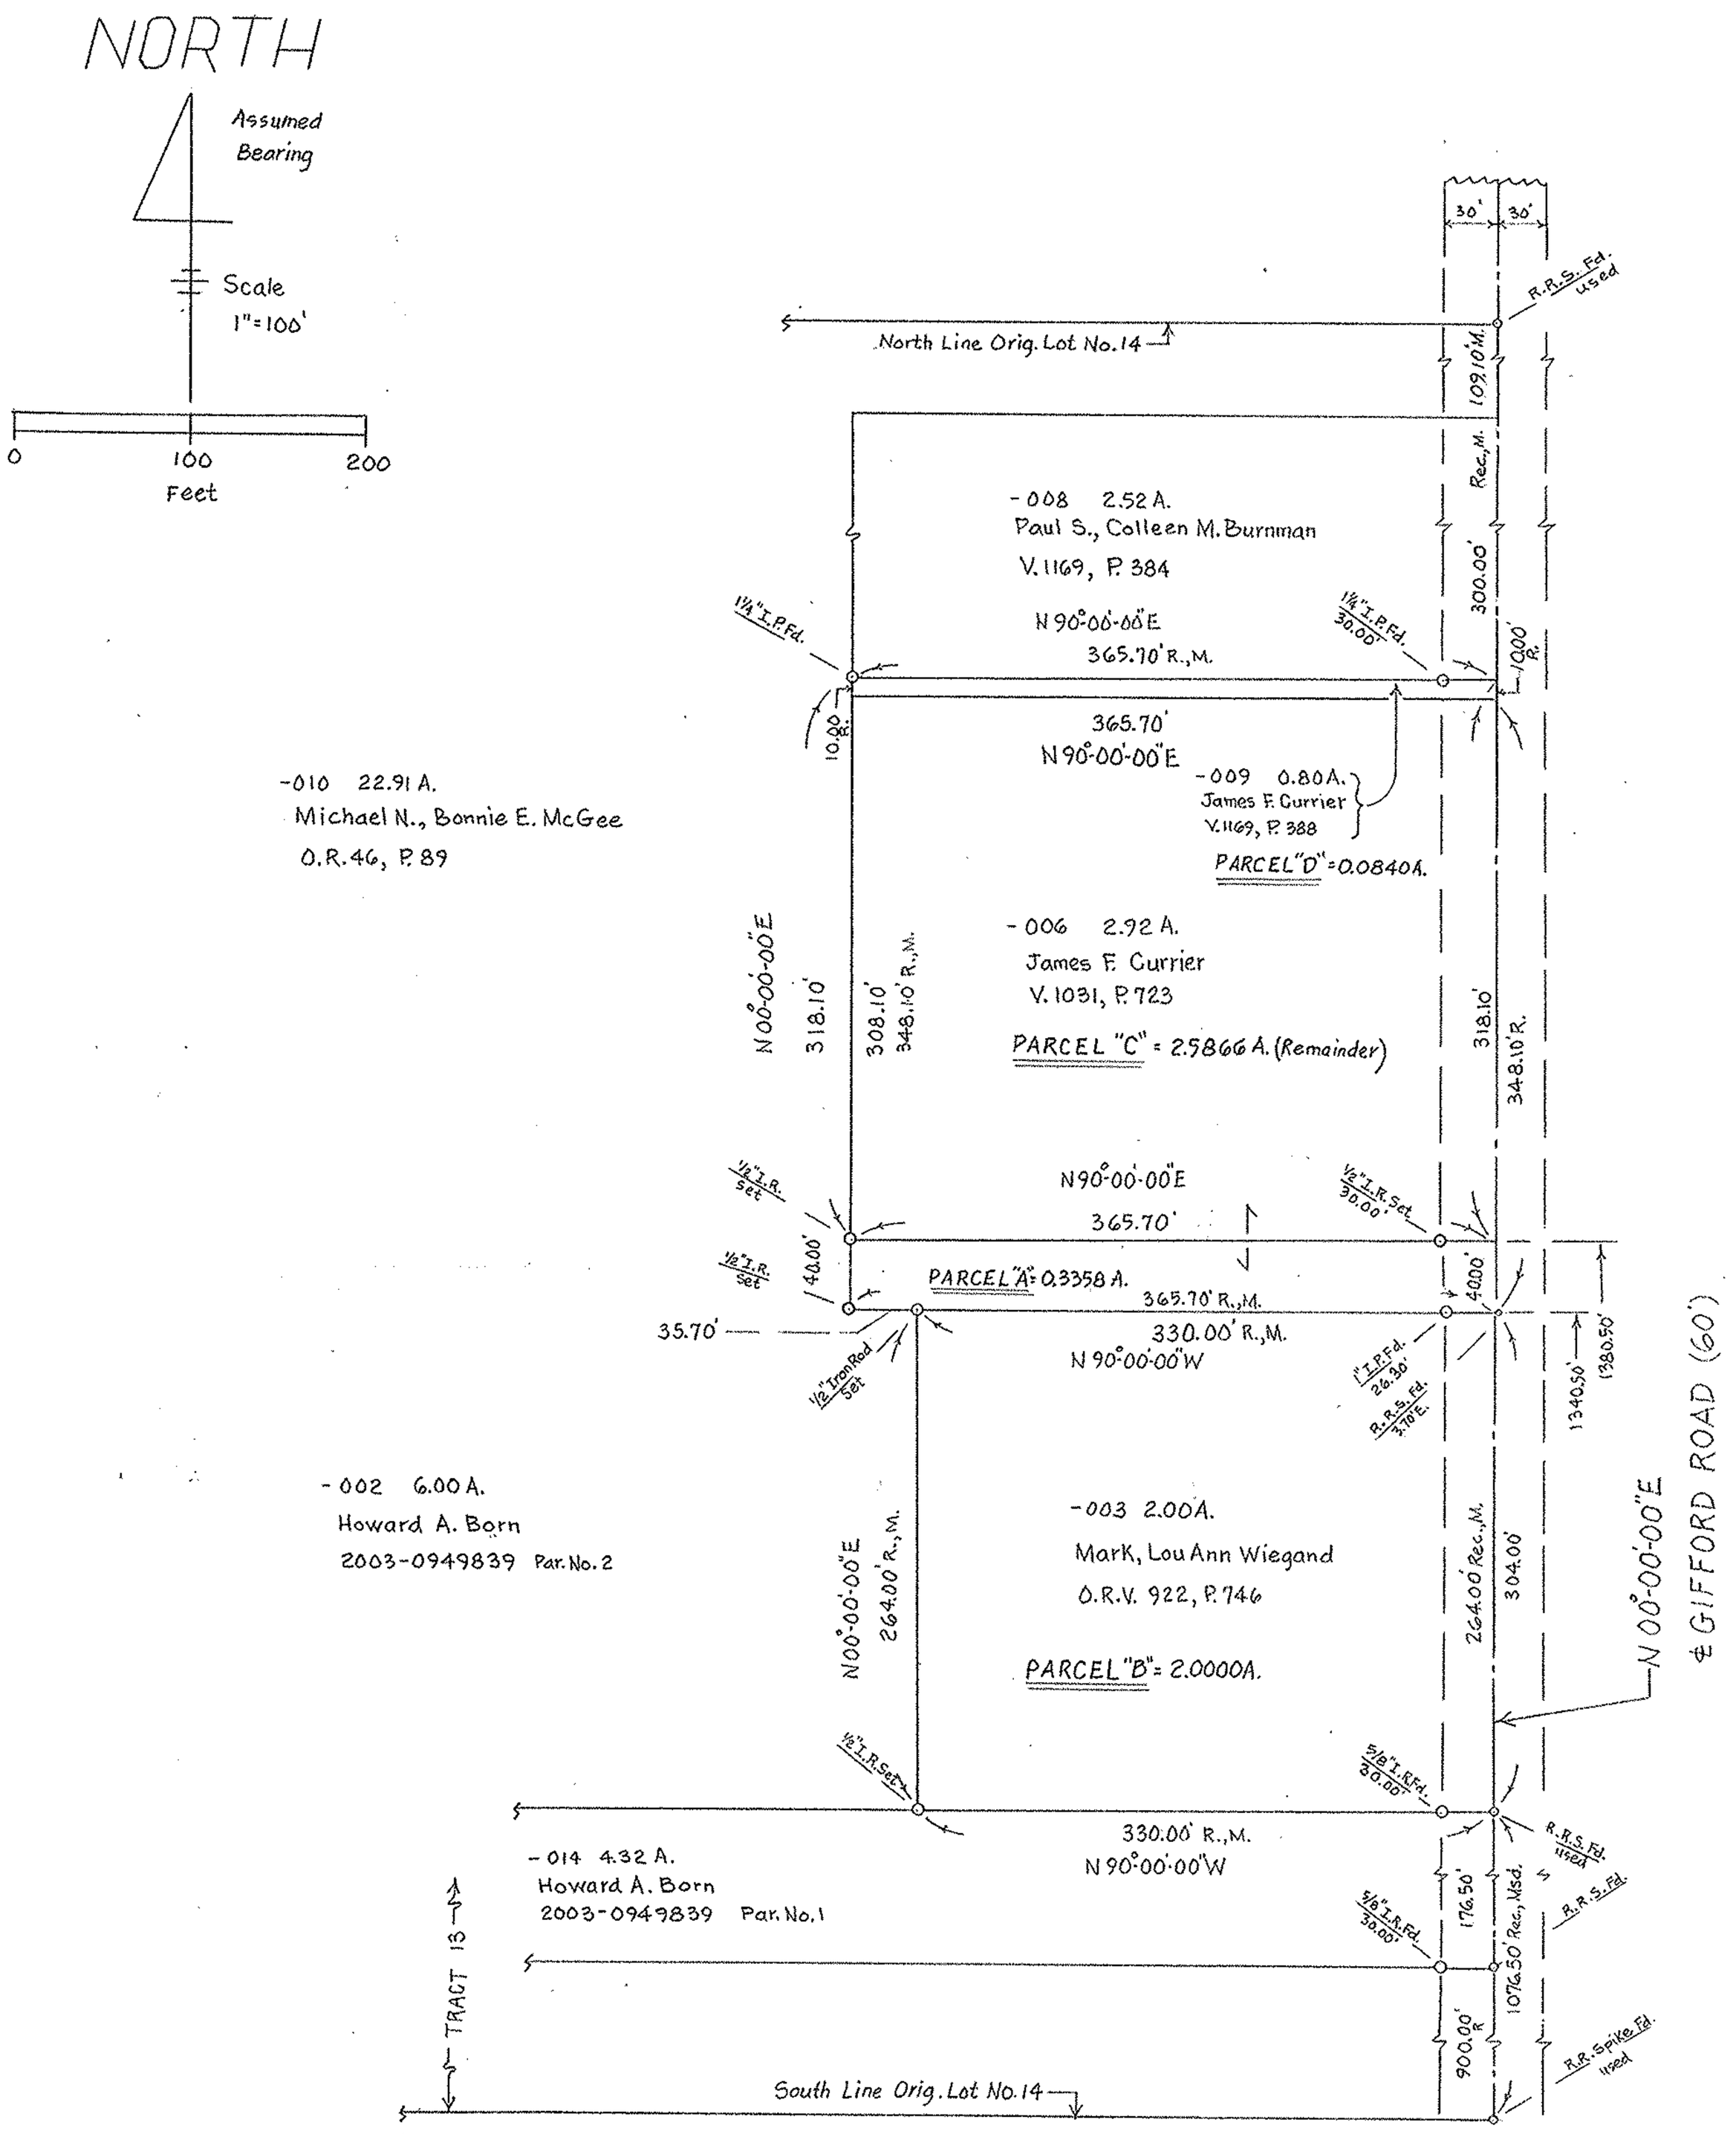

#2062

Charles P. Waryu November 21, 2005
Charles P. Waryu
Registered Surveyor No. 5029

MAP OF SURVEY MADE
Part of Original Lot No. 14;
Tract 13, Henrietta Township,
Lorain County, Ohio.
For Mark Wiegand Nov. 2005