



**DANE A. HAPONEK**

5444 Stoney Ridge Road North Ridgeville, Ohio 44039 (440) 327-4776  
Registered Surveyor S6211

S/L 8  
CENTER GATE

DATE: OCT. 2005  
SCALE: 1"=30'

MILLS SUBN.

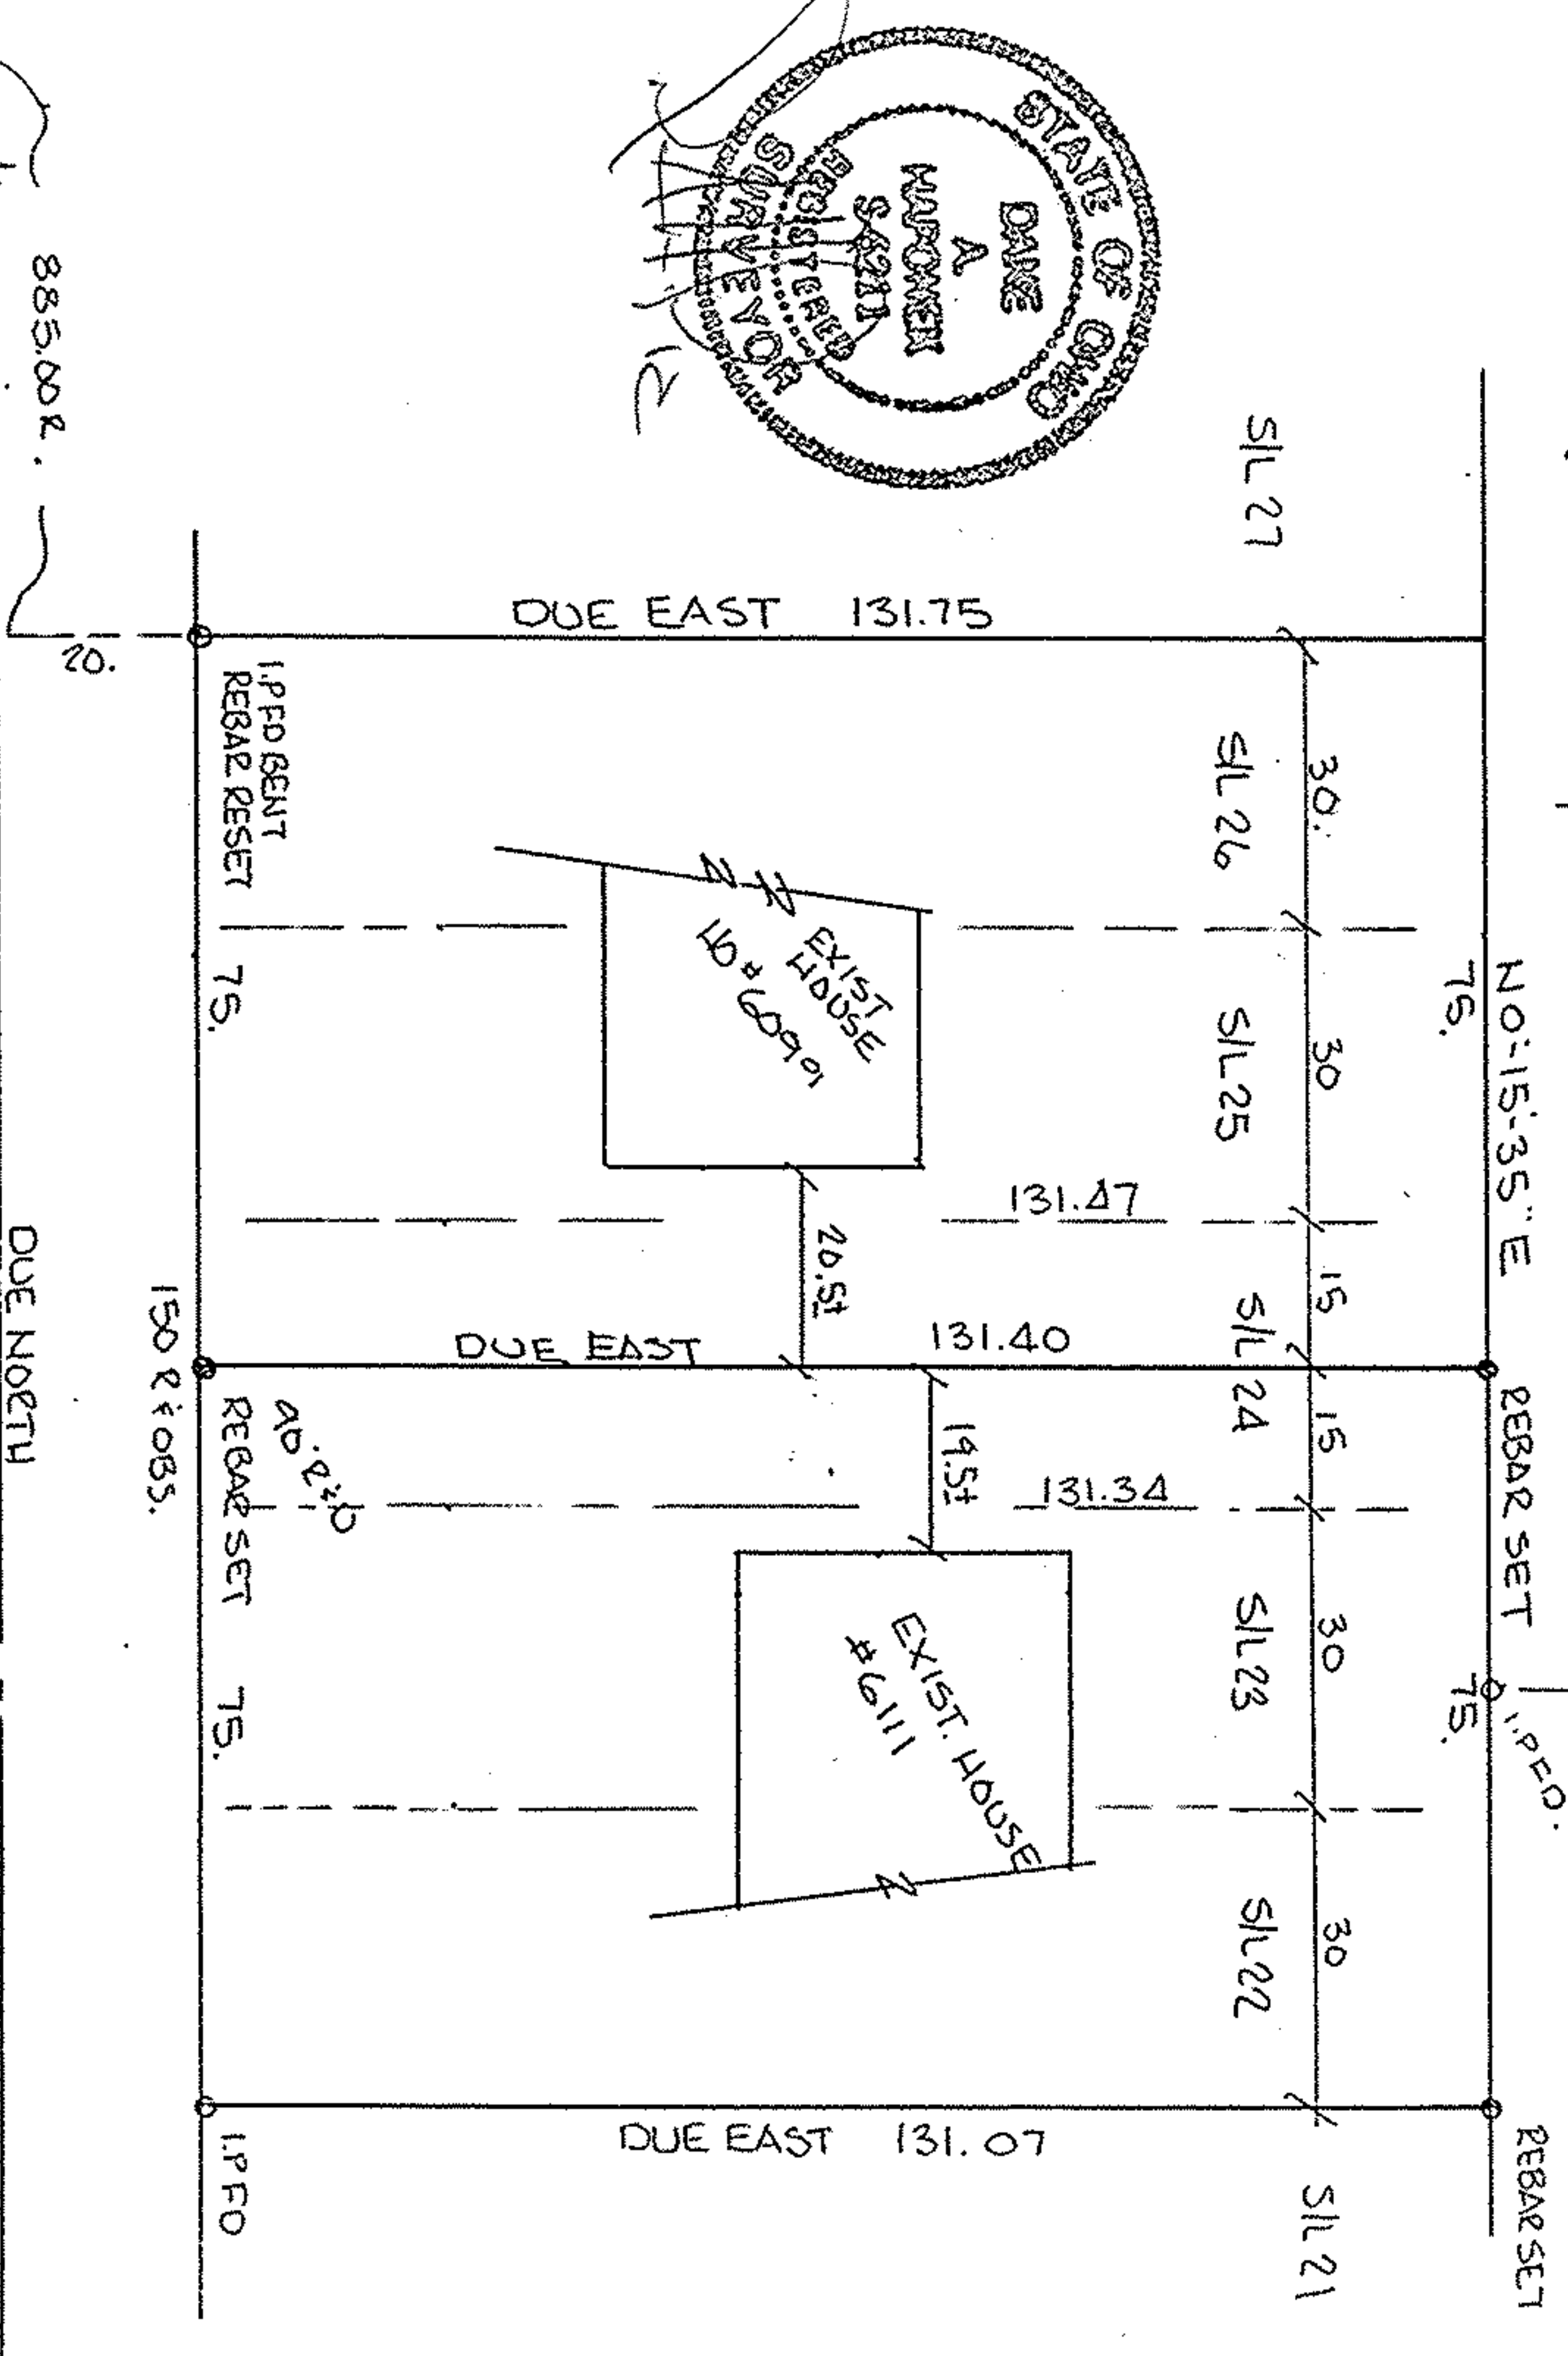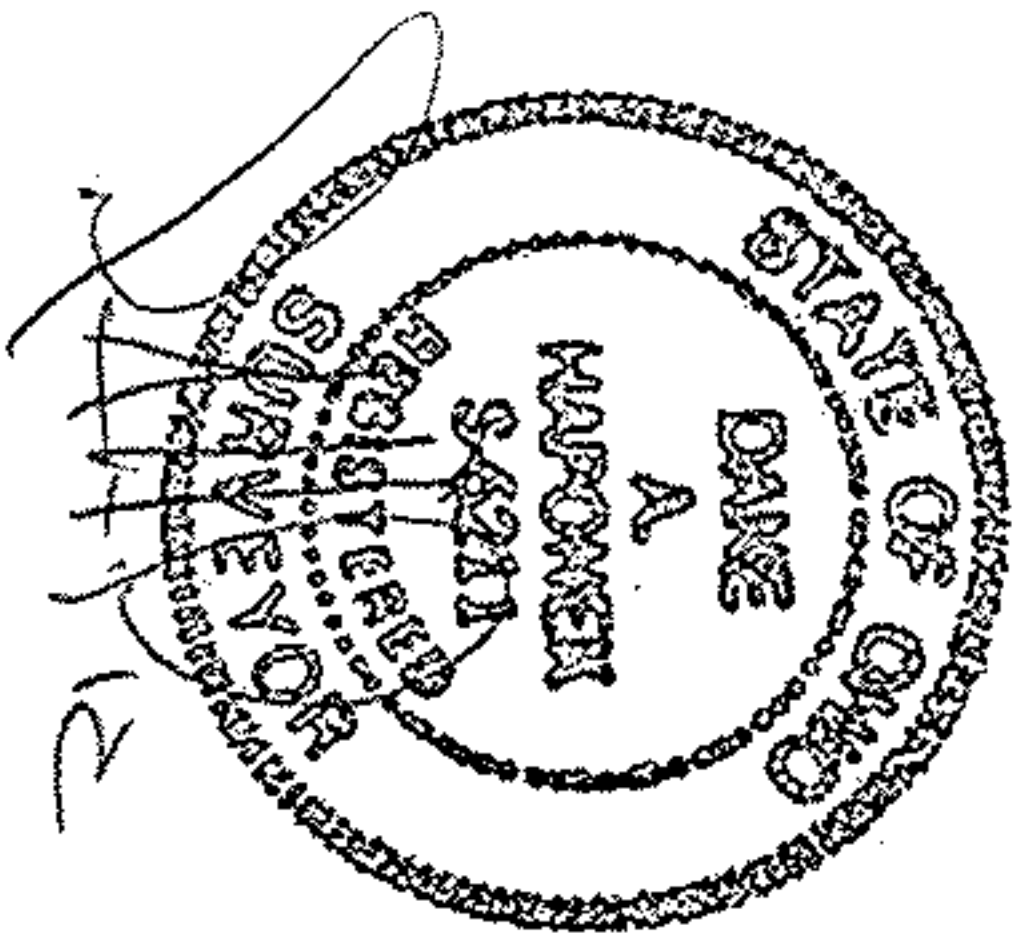

CORNELL AVE 40'

**SURVEY**  
OF

SUBLOTS 22 THRU 26 BLVD  
CLEVELAND ROAD HOMESITE  
PLAT VOL 10 PAGES 27-28  
CITY OF N. RIDGEVILLE

APPROVED  
LORAIN CO.  
MAINT DEPT

DATE 12-28-05

PAGE 7-00-017-D

BY UHAFIELD

# 05-02070

PREPARED FOR  
DOROTHY MILAN  
6111 CORNELL AVE.  
N. RIDGEVILLE, OH

AND  
BILL SHAEFER  
6099 CORNELL AVE.  
N. RIDGEVILLE, OH