CERTIFICATION

THIS PLAT IS A TRUE REPRESENTATION OF A SURVEY PERFORMED ON 8 AUGUST 1997 UNDER MY DIRECTION. DIMENSIONS SHOWN ARE EXPRESSED IN FEET AND DECIMAL PARTS THEREOF, BEARING GIVEN ARE BASED LEGAL DESCRIPTIONS AND ARE TO AN ASSUMED MERIDIAN AND ARE TO INDICATE ANGLES ONLY. ALL PERMANENT MONUMENENTS WERE FOUND OR SET AS INDICATED HEREON.

STATE OF OHIO
LOUISE A. VEVERKA 7513
REGISTERED PROFESSIONAL SURVEYOR

Louise A Veverka 11/18/05
Louise A. Veverka, P.S. 7513

PREPARED BY

L.V. Surveying, Inc.
15145 LORAIN AVENUE
CLEVELAND, OHIO 44111
216-251-6972 FAX:216-251-7685

● I.P. SET – INDICATES 5/8" IRON PIN SET w/ CAP #7513
PRIOR SURVEY IN 1997

N

MAP OF SURVEY for MYRON BREMKE

SITUATED IN THE TOWNSHIP OF RUSSIA, COUNTY OF LORAIN AND STATE OF OHIO AND KNOWN AS BEING PART OF ORIGINAL RUSSIA TOWNSHIP LOT NUMBER 15.

0' 100' 200' 300'

SCALE 1" = 100'-0"
November 17, 2005
ACTUAL SURVEY DATE AUG. 8, 1997

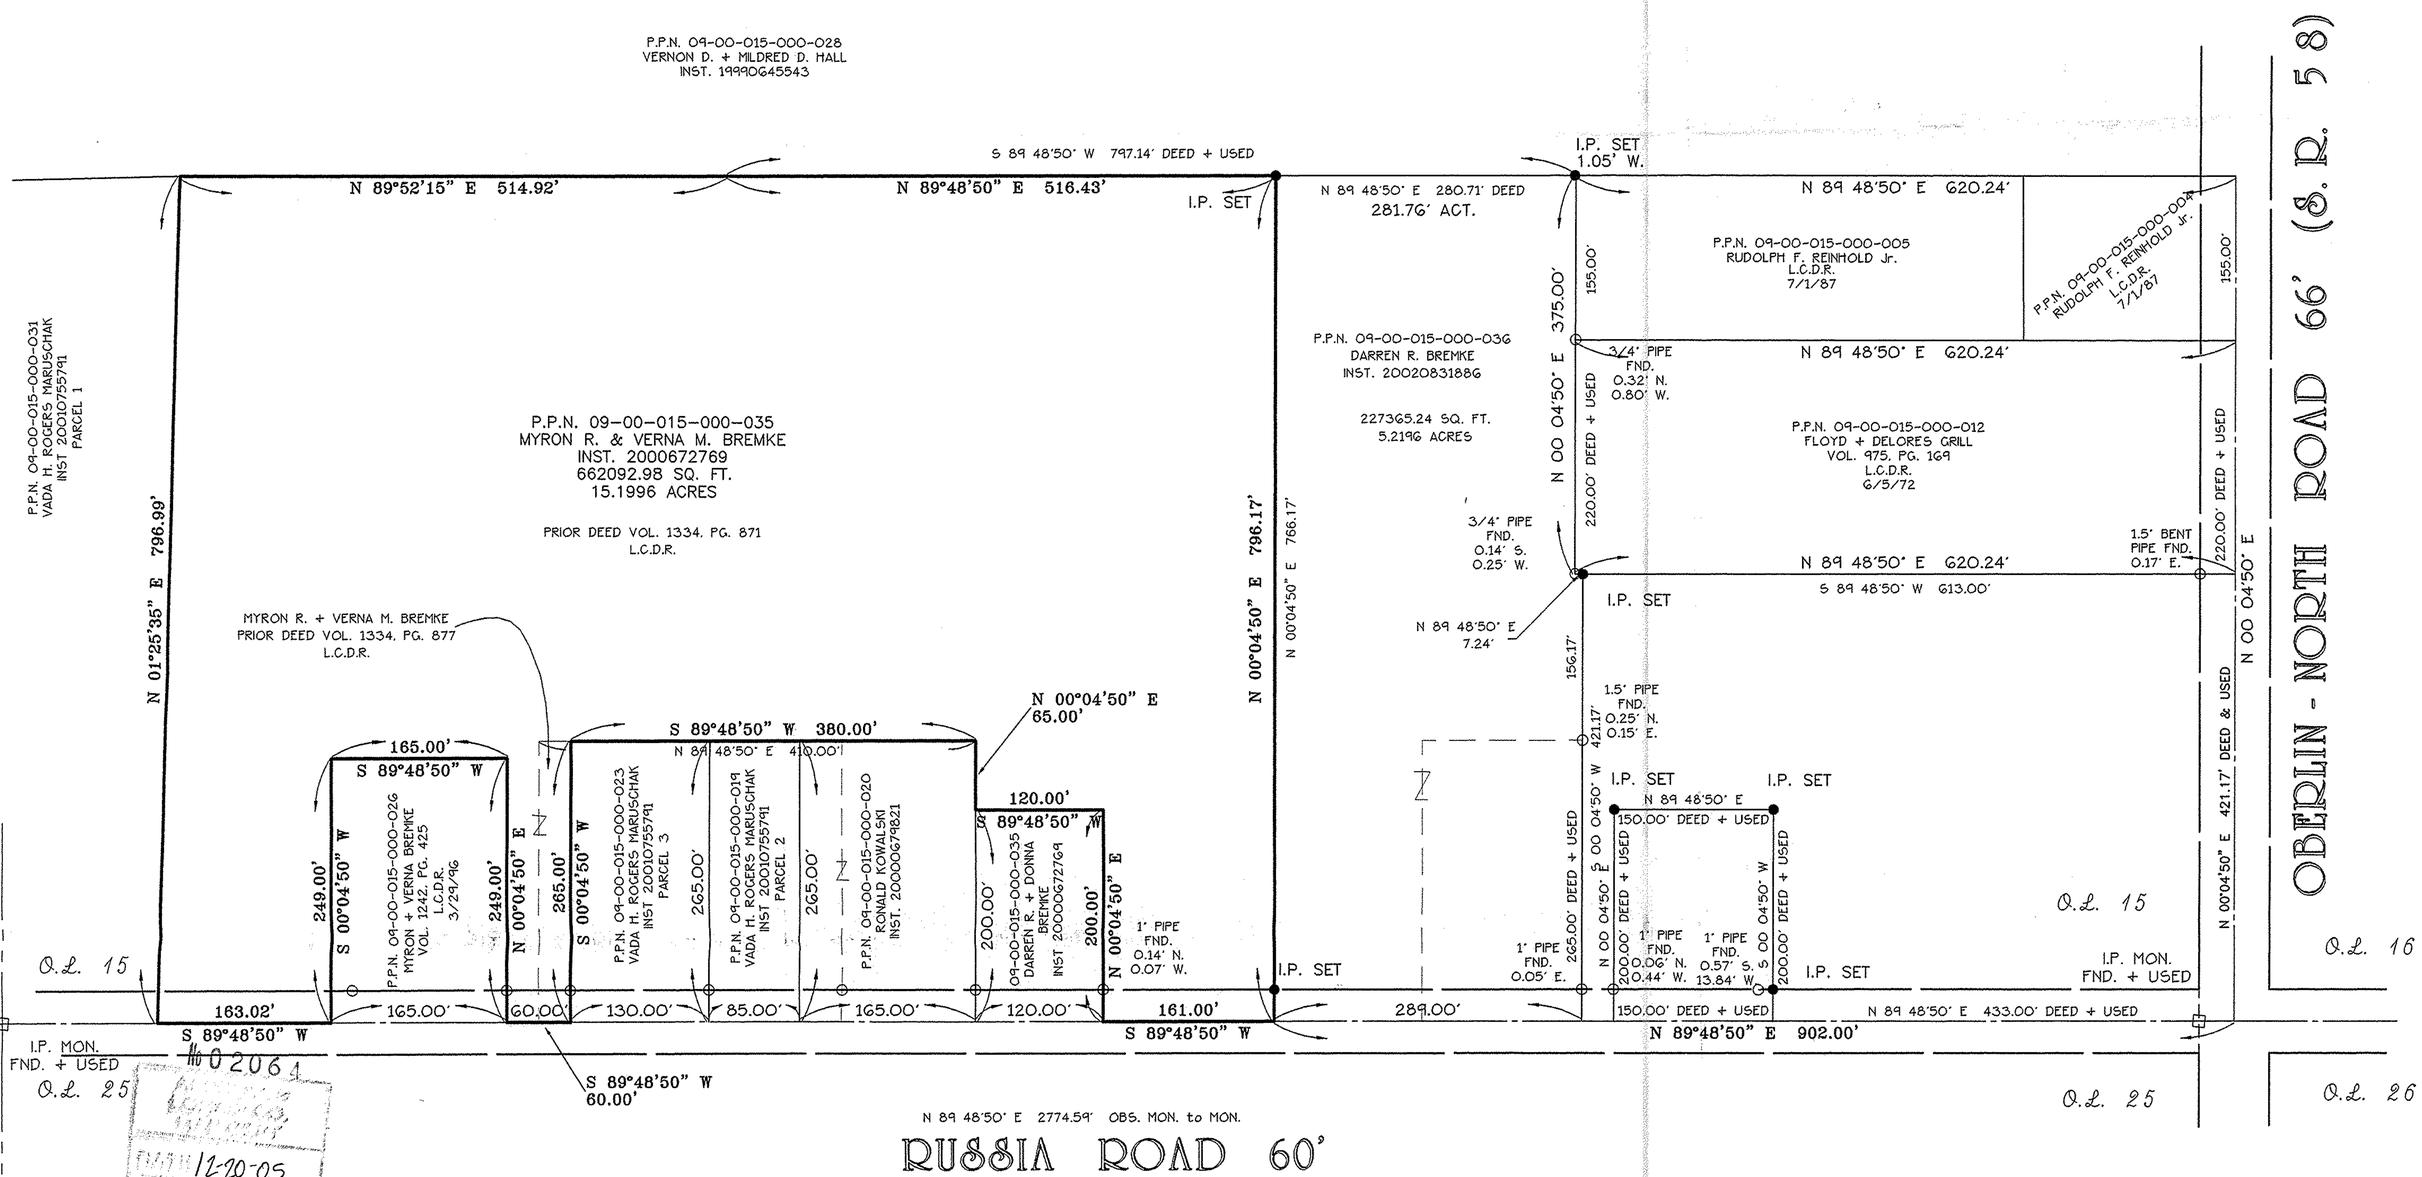

02061
DATE 12-20-05
9-B
BY VHatfield
05-02064

C:\scad2006\WORK\05185.dwg, 11/18/2005 11:07:37 AM

05185