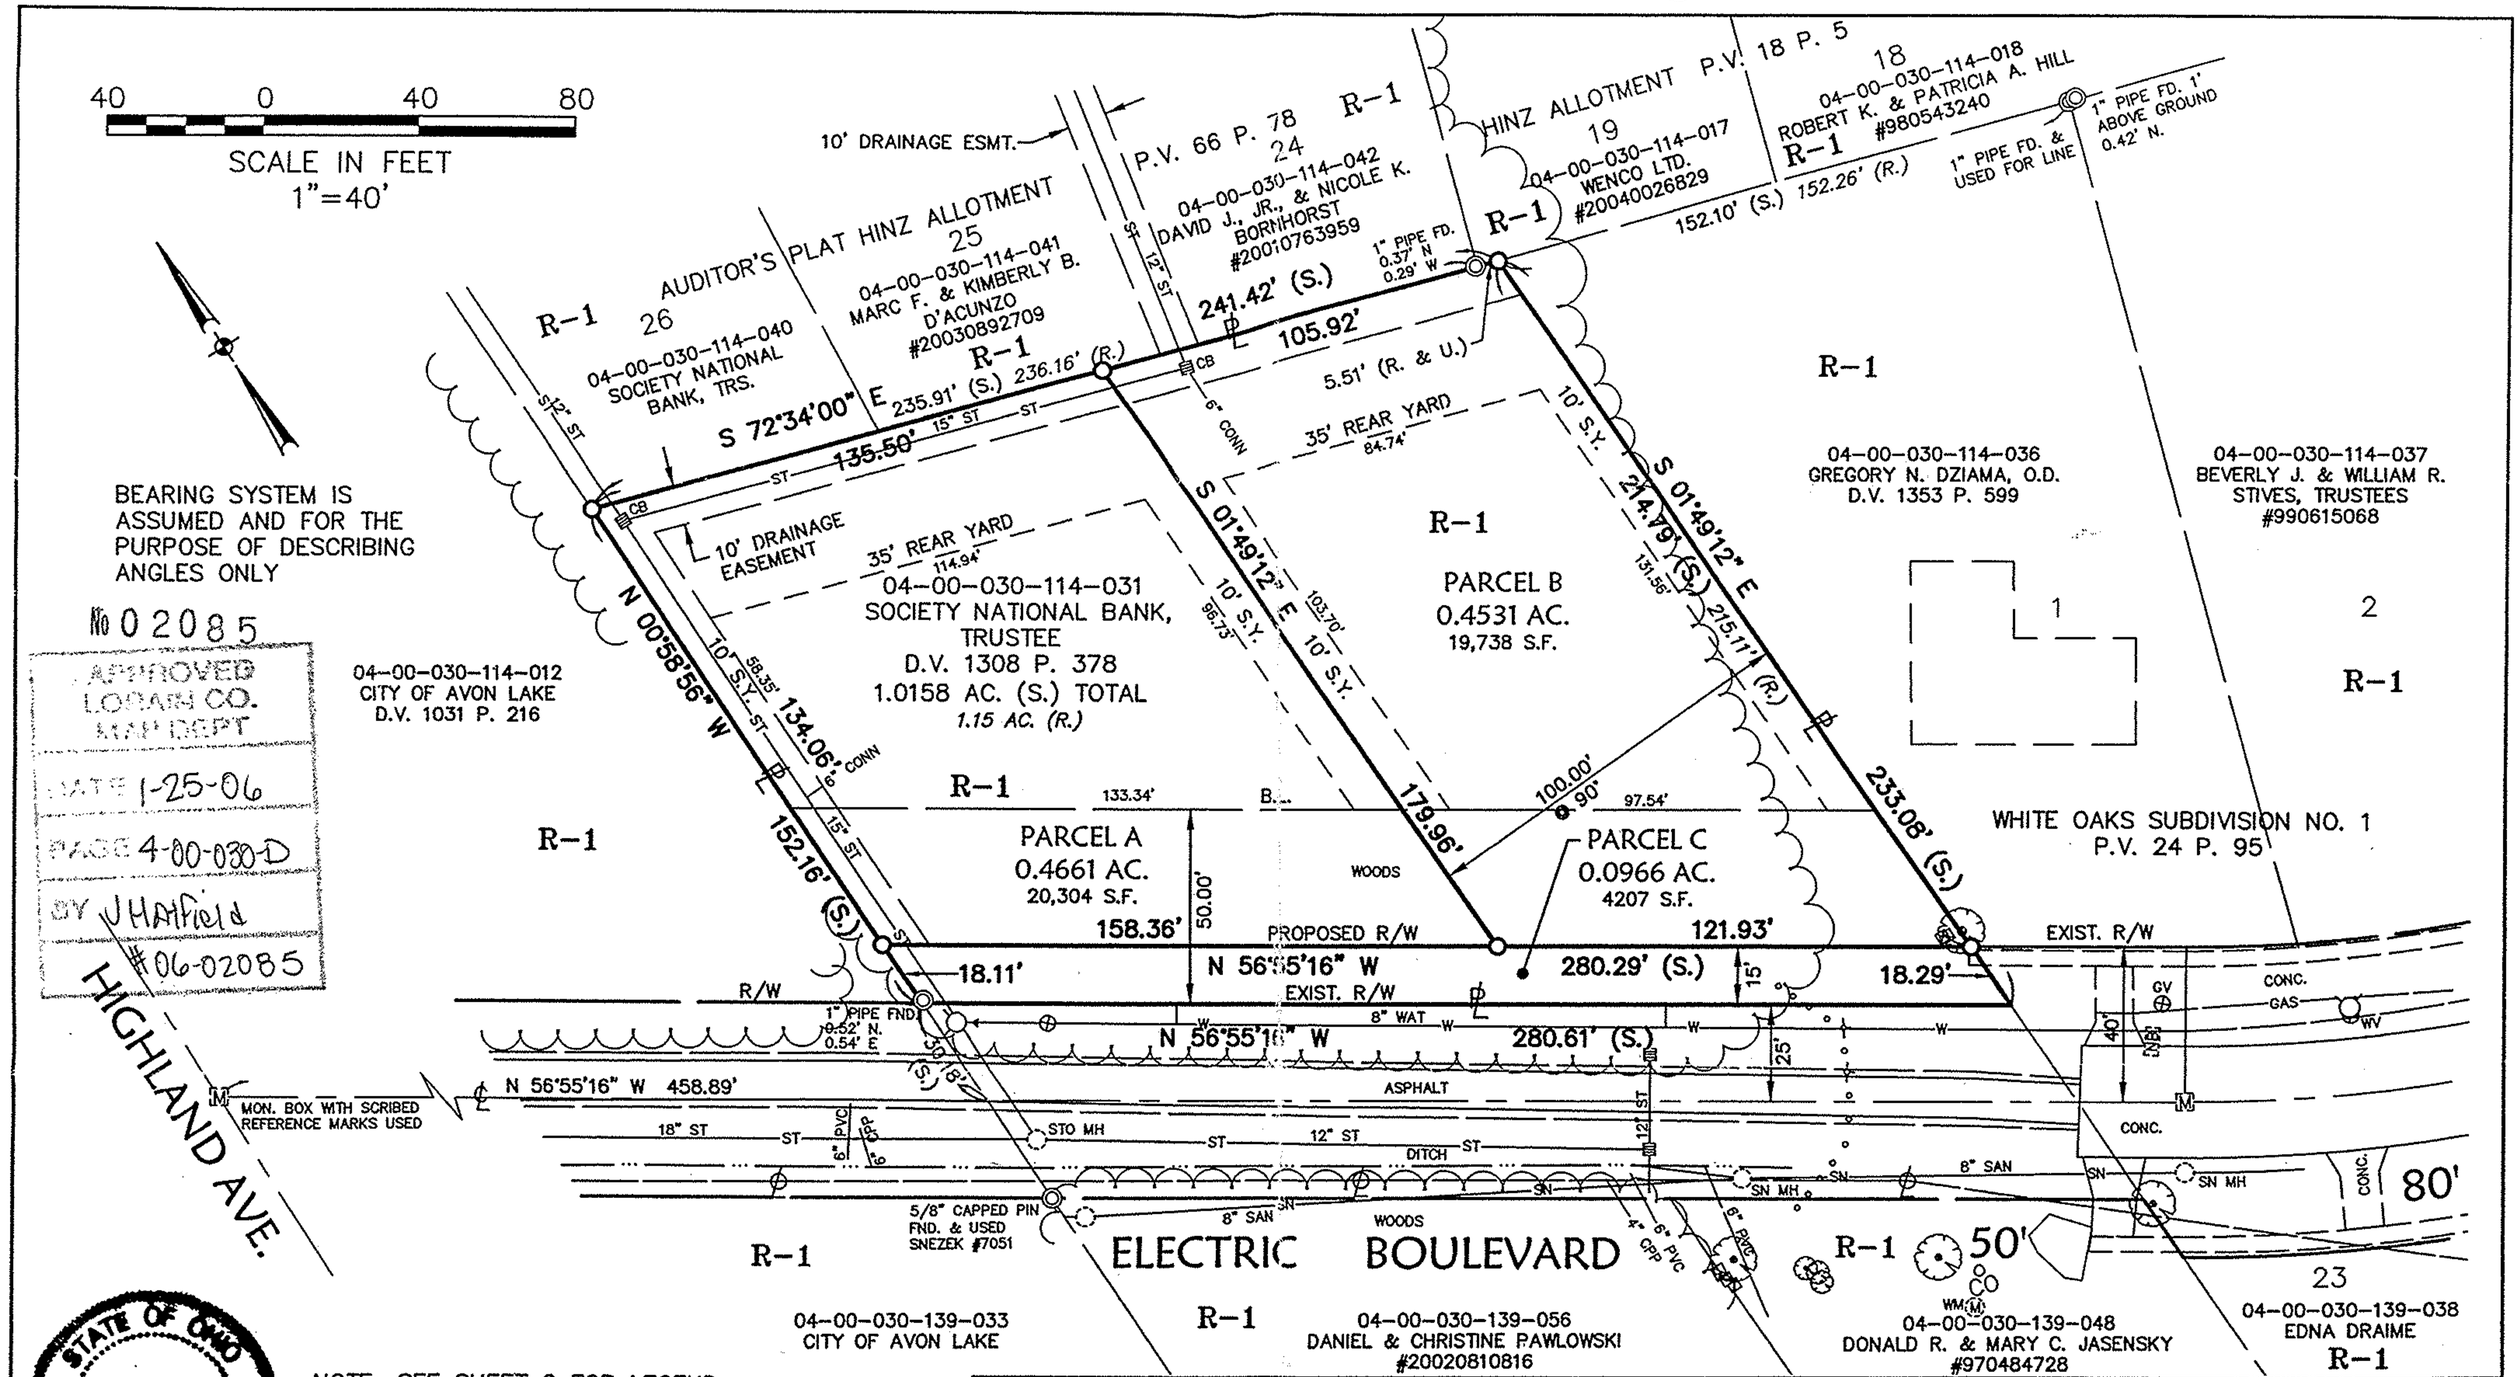

NOTE: SEE SHEET 2 FOR LEGEND

STATE OF OHIO
DAVID L. ELWELL
6333
REGISTERED SURVEYOR

David L. Elwell 6-13-05

DAVID L. ELWELL, REGISTERED SURVEYOR NO. 6333

KS ASSOCIATES
KS Associates, Inc.
260 Burns Rd., Suite 100
Elyria, Ohio 44035
Phone (440) 365-4730
Fax (440) 365-4790
mailroom@ksassoc.com
www.ksassoc.com

BOUNDARY SURVEY & PARCEL SPLIT
PARCEL NO. 04-00-030-114-031

PART OF
AVON TOWNSHIP SECTION NO. 30
CITY OF AVON LAKE COUNTY OF LORAIN STATE OF OHIO
DATE: MAY 13, 2005 REVISED: JUNE 1, 2005 & JUNE 13, 2005

JOB NO. 04301
DWG. NAME O-SPLIT01
SHEET 1 OF 2