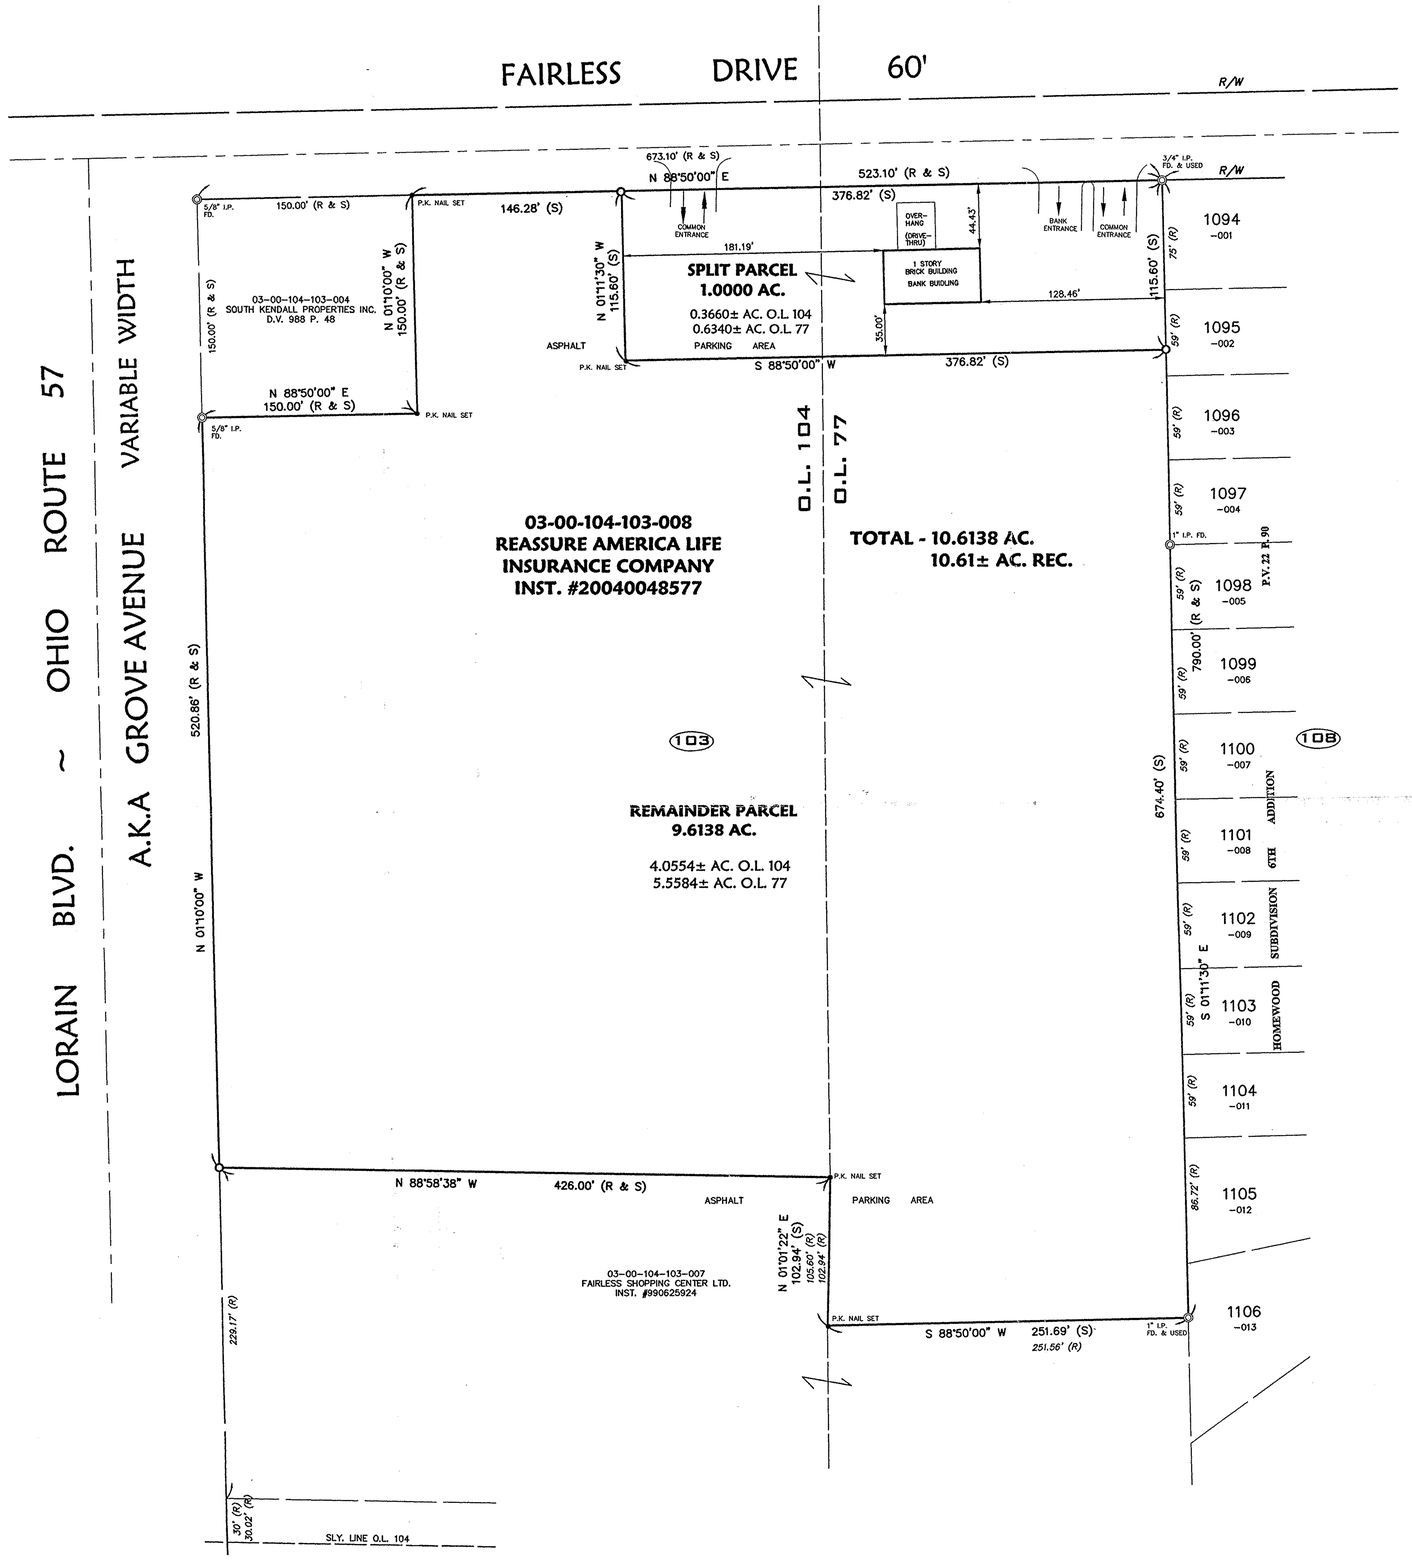

50 0 50 100

SCALE IN FEET
SCALE: 1"=50'

THE BEARING SYSTEM IS ASSUMED AND FOR THE PURPOSE OF DESCRIBING ANGLES ONLY.

LEGEND

- ◎ – IRON PIN/PIPE FOUND
- o – 5/8"X30" CAPPED REBAR SET "KS ASSOC INC PROP MARKER"
- ⊗ – PK NAIL
- (S) – SURVEYED
- (R) – RECORD
- FD. – FOUND

PREVIOUS SURVEY BY KS ASSOCIATES INC. PERFORMED SEPT. 27, 1990.

No 02109
APPROVED
LORAIN CO.
MAP DEPT
DATE 2-23-06
PAGE 3-00-104B
BY UHatfield
06-02109

STATE OF OHIO
DAVID L. ELWELL
S-6333
REGISTERED PROFESSIONAL SURVEYOR

David L. Elwell 7-07-05
DAVID L. ELWELL, REGISTERED SURVEYOR NO. 6333

APPROVED
AS TO DESCRIPTION ONLY
Date 09 2 8 05
City of Lorain
Per Engineering Dept.

APPROVED BY THE LORAIN CITY PLANNING COMMISSION ..... NO PLAT REQUIRED
William E. Dobo 9-1-05
SECRETARY LORAIN CITY PLANNING COMMISSION

DATE	DESCRIPTION	BY

REVISIONS

DATE:
DRAWN BY:
CH'D BY:
DWG. NAME:
PATH:
F.B.

KS ASSOCIATES
KS Associates, Inc.
260 Burns Rd., Suite 100
Elyria, Ohio 44035
Phone (440) 365-4730
Fax (440) 365-4790
mailroom@ksassoc.com
www.ksassoc.com

BOUNDARY SURVEY

OF PART OF
SHEEFIELD TOWNSHIP ORIG. LOTS 77 & 104
CITY OF LORAIN COUNTY OF LORAIN STATE OF OHIO

SHEET 1 OF 1

JOB NO. 05200