
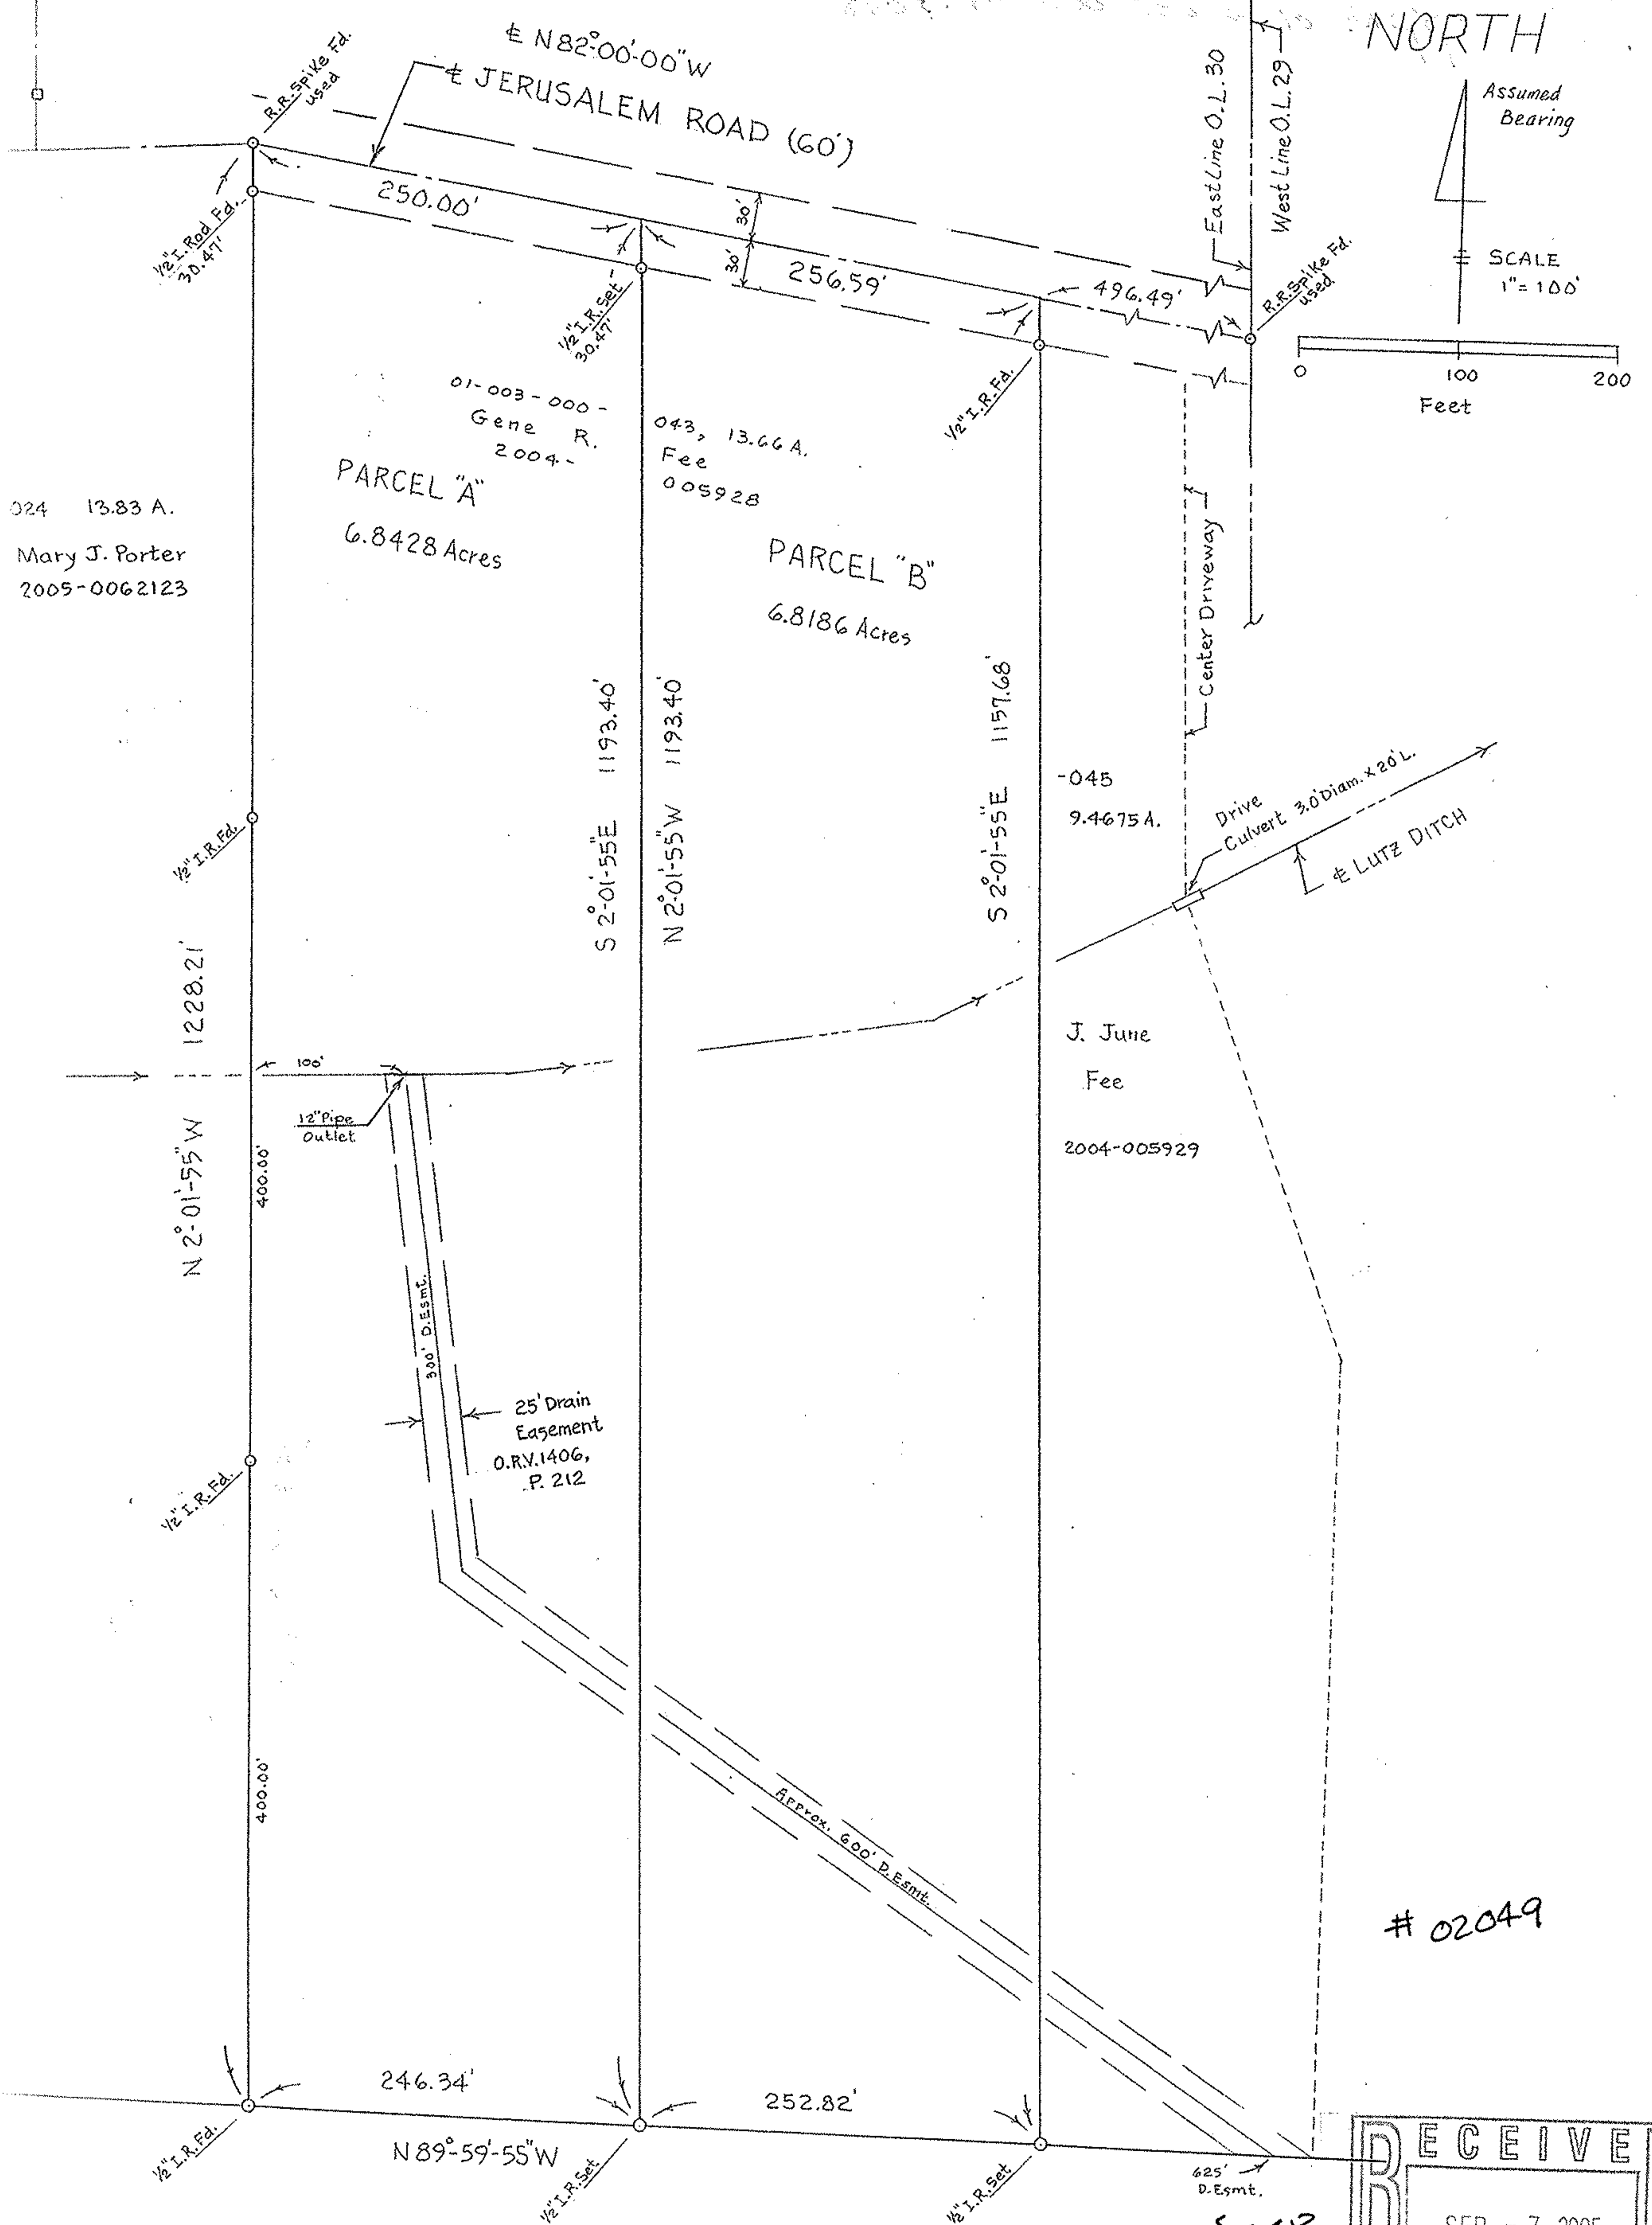


NORTH

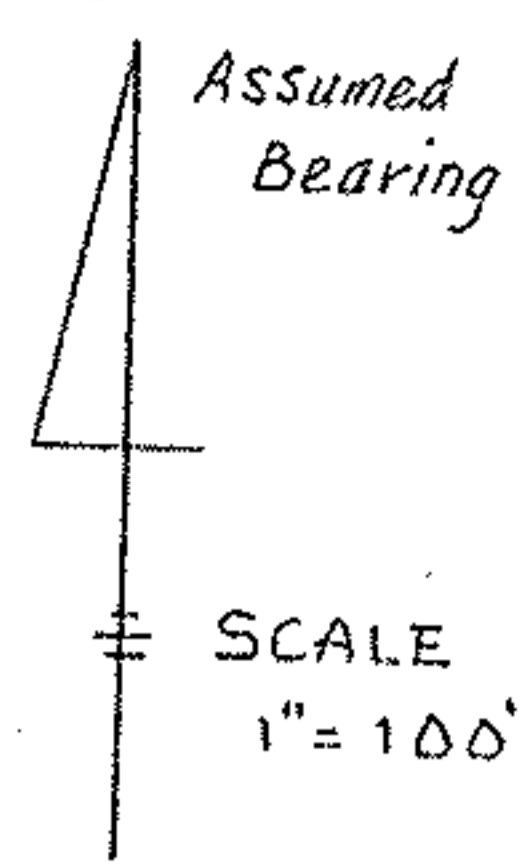

024 13.83 A.
Mary J. Porter
2005-0062123

01-003-000 -
Gene R.
2004-

PARCEL "A"
6.8428 Acres

043, 13.66 A.
Fee
005928

PARCEL "B"
6.8186 Acres

-045
9.4675 A.

J. June
Fee
2004-005929

02049

246.34'
N 89°-59'-55"W
252.82'

-037 26.97 A.
Marian Gringle, Melvin Pippert, Lois McQueen
V.1374, P.277, Par.No. 3

01-00-030-000-047
Pg. 1-00-030-B

RECEIVED
SEP - 7 2005
CITY OF VERMILION, OHIO
BOARDS & COMMISSIONS

Charles P. Waryu July 15, 2005
Charles P. Waryu, Registered Surveyor
No. 5029

MAP OF SURVEY MADE
Part of Original Brownhelm Twp.
Lot No. 30, City of Vermilion, Lorain
County, Ohio.
For Gene R. Fee July 2005