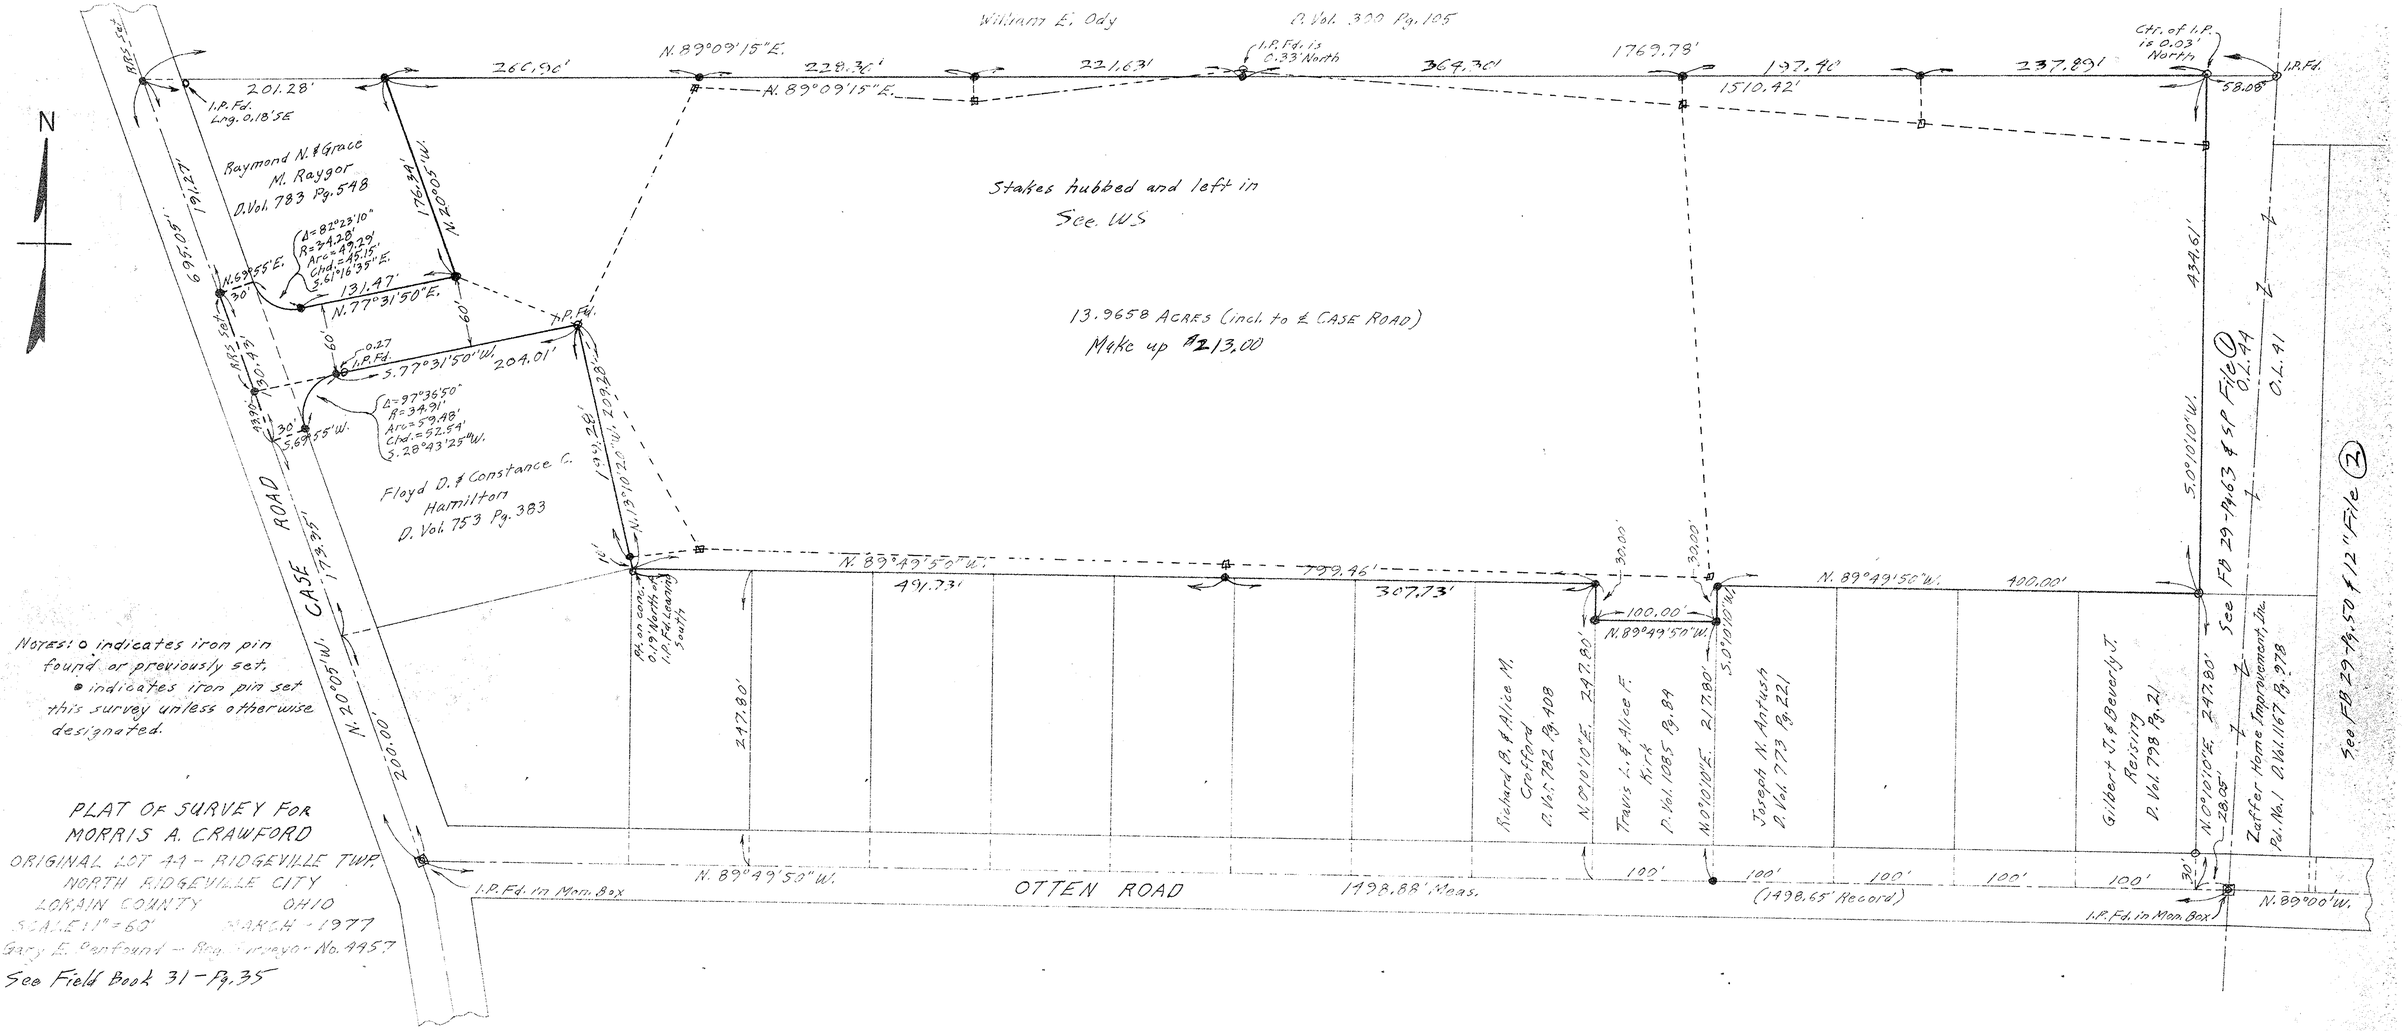

Notes: o indicates iron pin found or previously set.
• indicates iron pin set this survey unless otherwise designated.

PLAT OF SURVEY FOR
MORRIS A. CRAWFORD
ORIGINAL LOT 44 – RIDGEVILLE TWP.
NORTH RIDGEVILLE CITY
LORAIN COUNTY OHIO
SCALE 1"=60' MARCH - 1977
Gary E. Penfound – Reg. Surveyor No. 4957
See Field Book 31 – Pg. 35