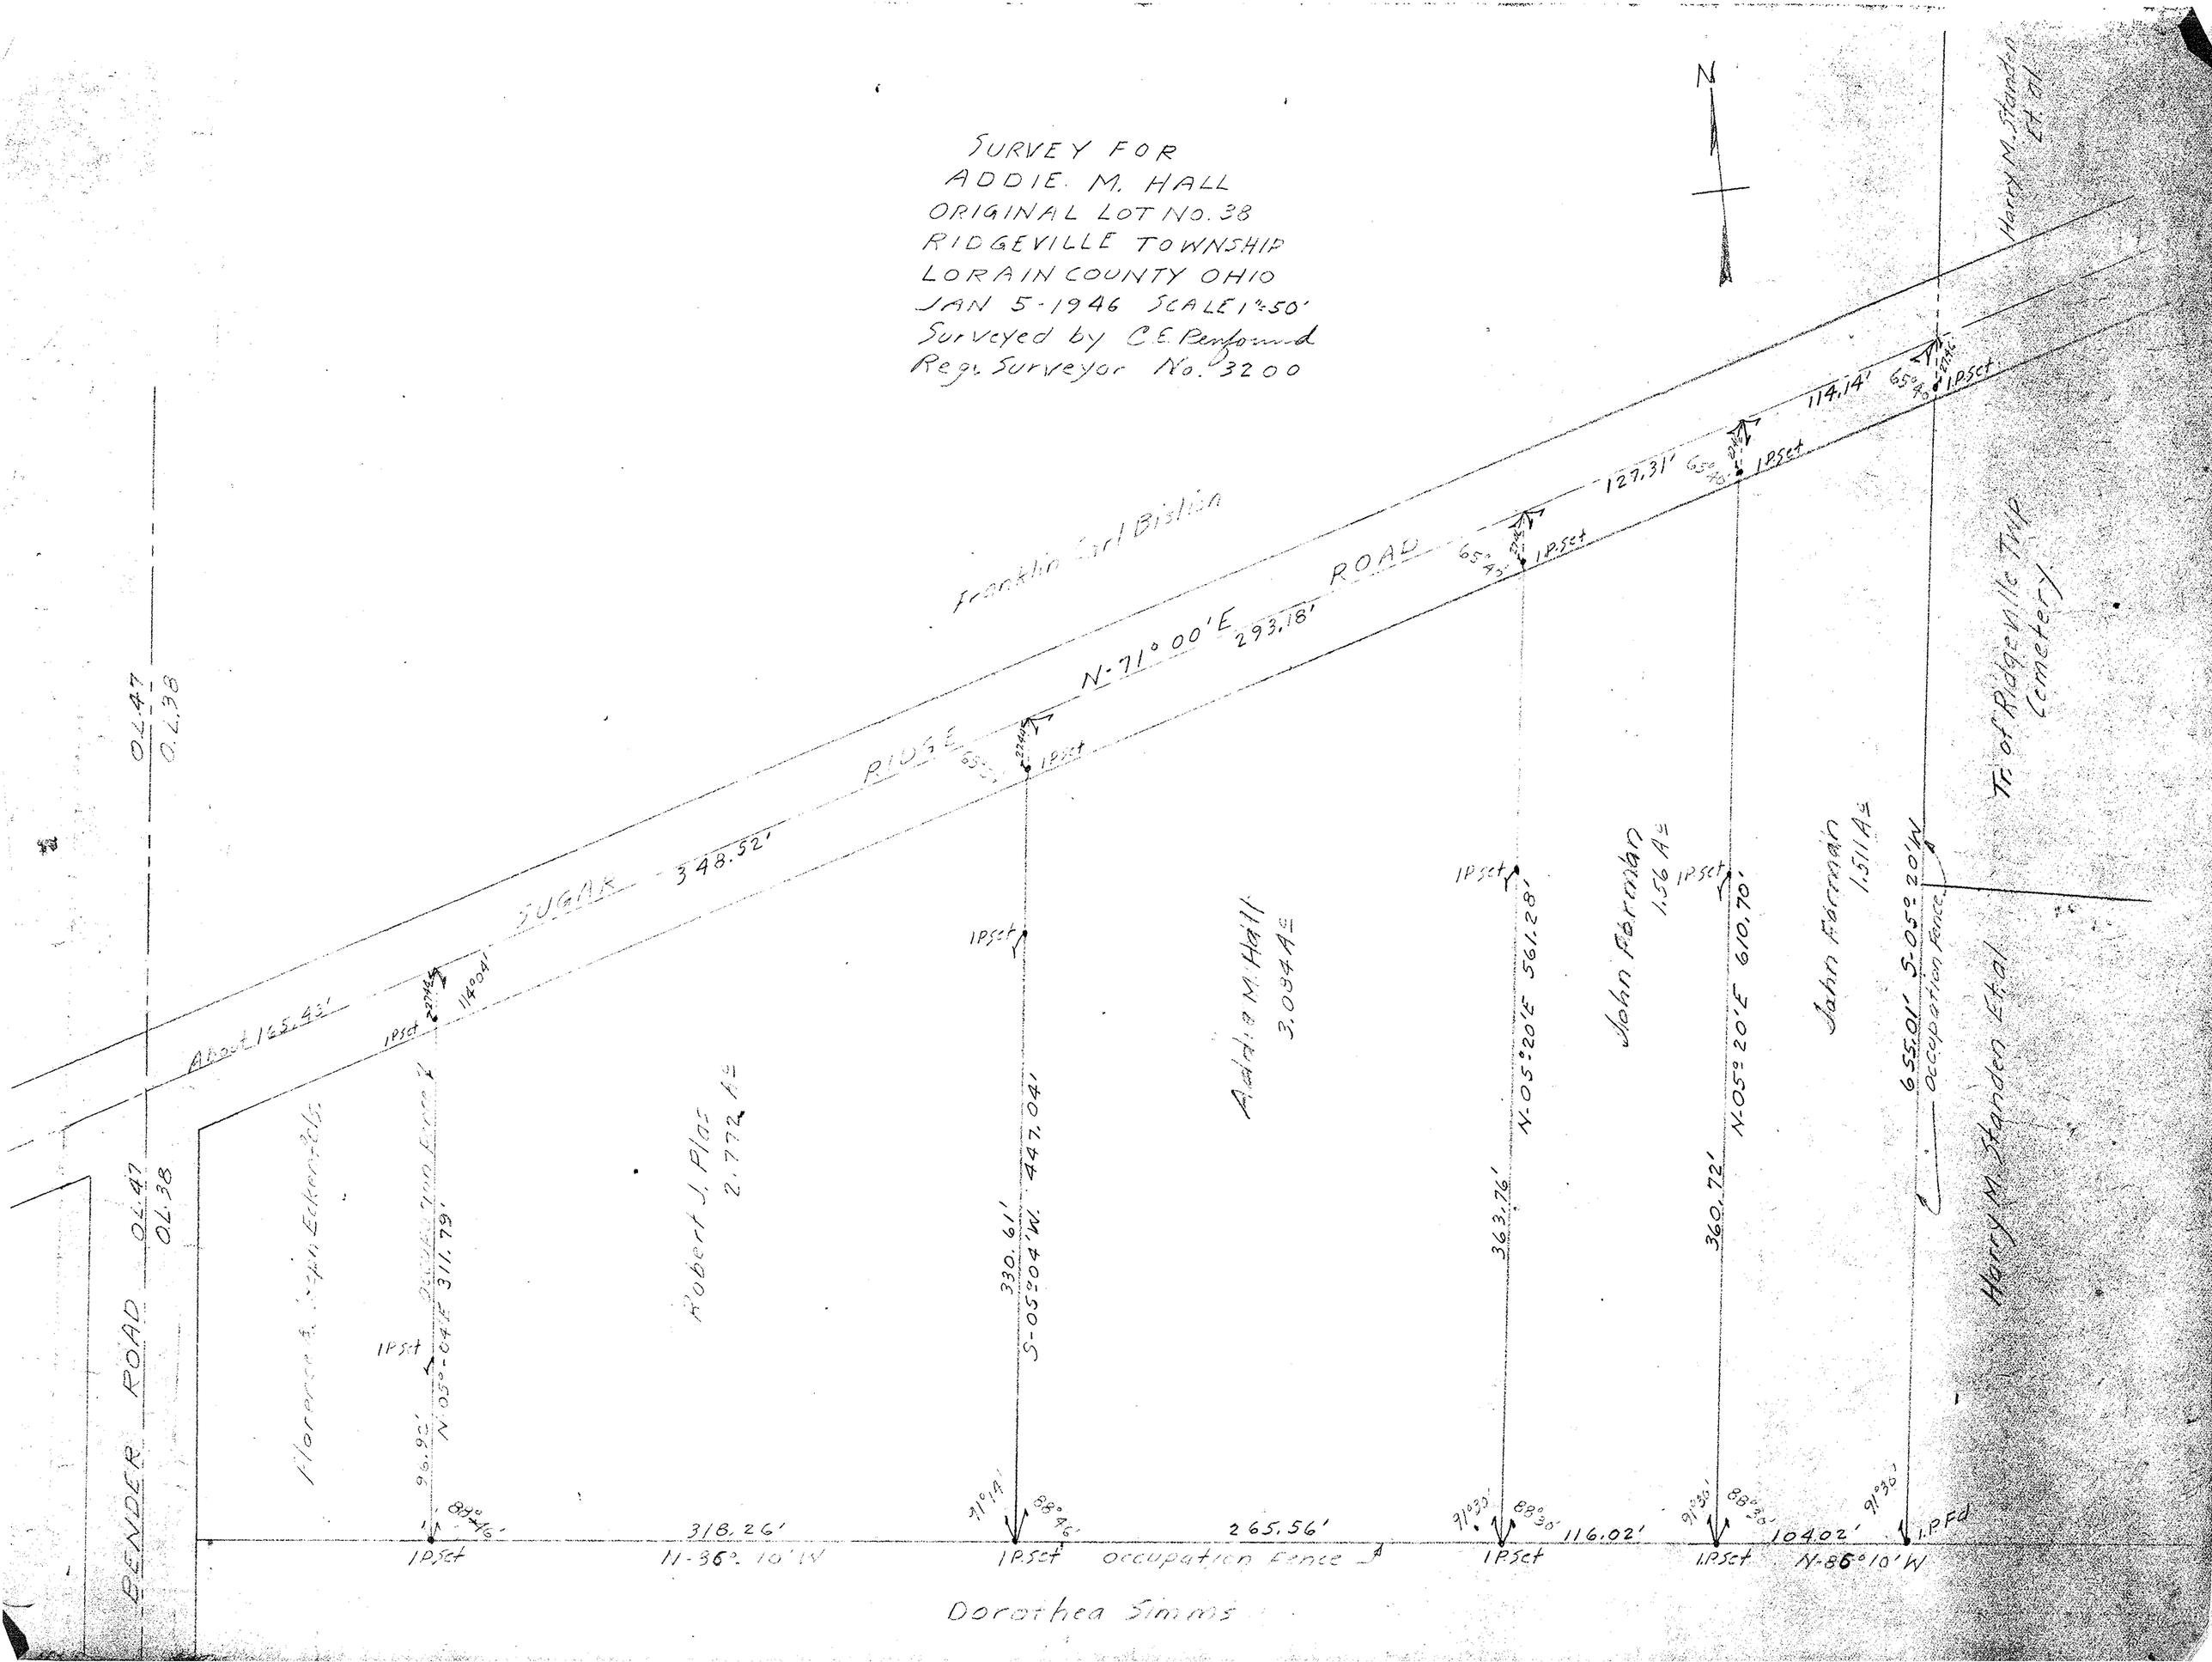SURVEY FOR
ADDIE M. HALL
ORIGINAL LOT NO. 38
RIDGEVILLE TOWNSHIP
LORAIN COUNTY OHIO
JAN 5-1946 SCALE 1"=50'
Surveyed by C.E. Renfroward
Regd. Surveyor No. 3200