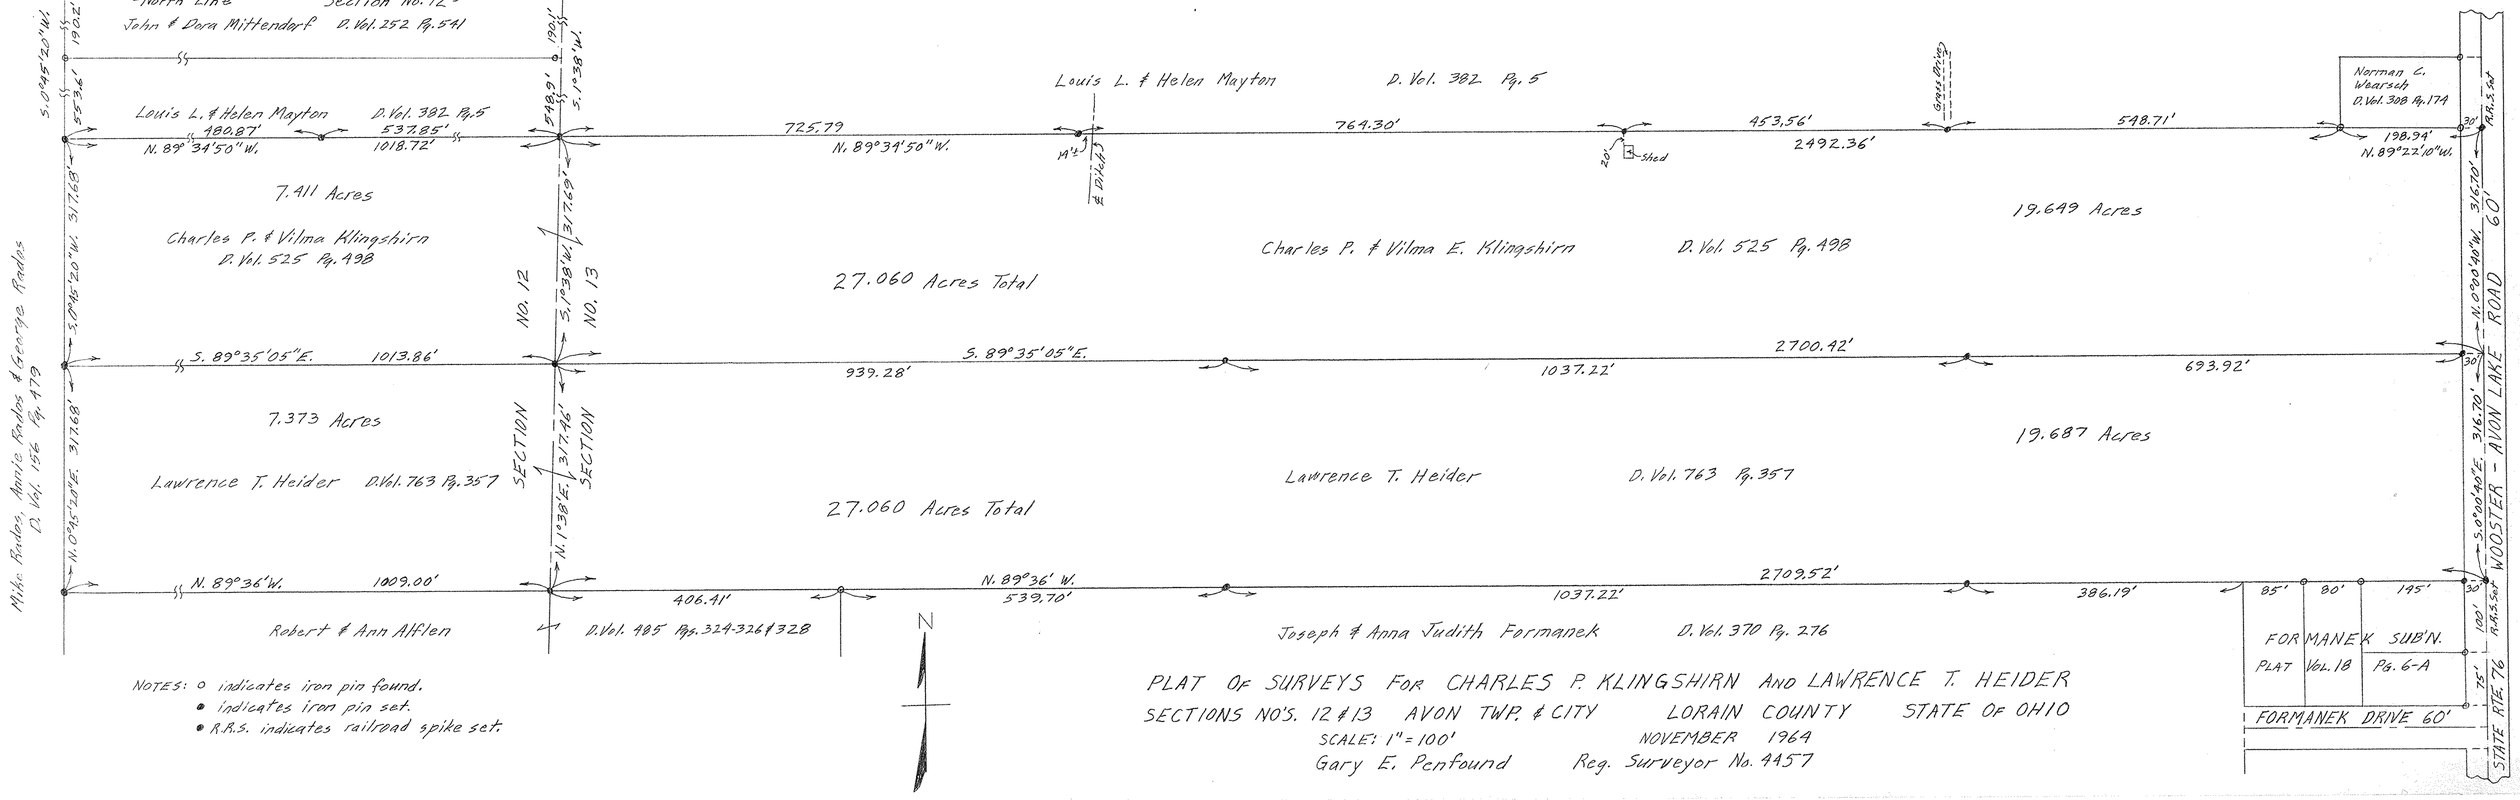

NOTES: o indicates iron pin found.
• indicates iron pin set.
• R.R.S. indicates railroad spike set.

PLAT OF SURVEYS FOR CHARLES P. KLINGSHIRN AND LAWRENCE T. HEIDER

SECTIONS NO'S. 12 & 13 AVON TWP. & CITY LORAIN COUNTY STATE OF OHIO

SCALE: 1" = 100' NOVEMBER 1964

Gary E. Penfound Reg. Surveyor No. 4457