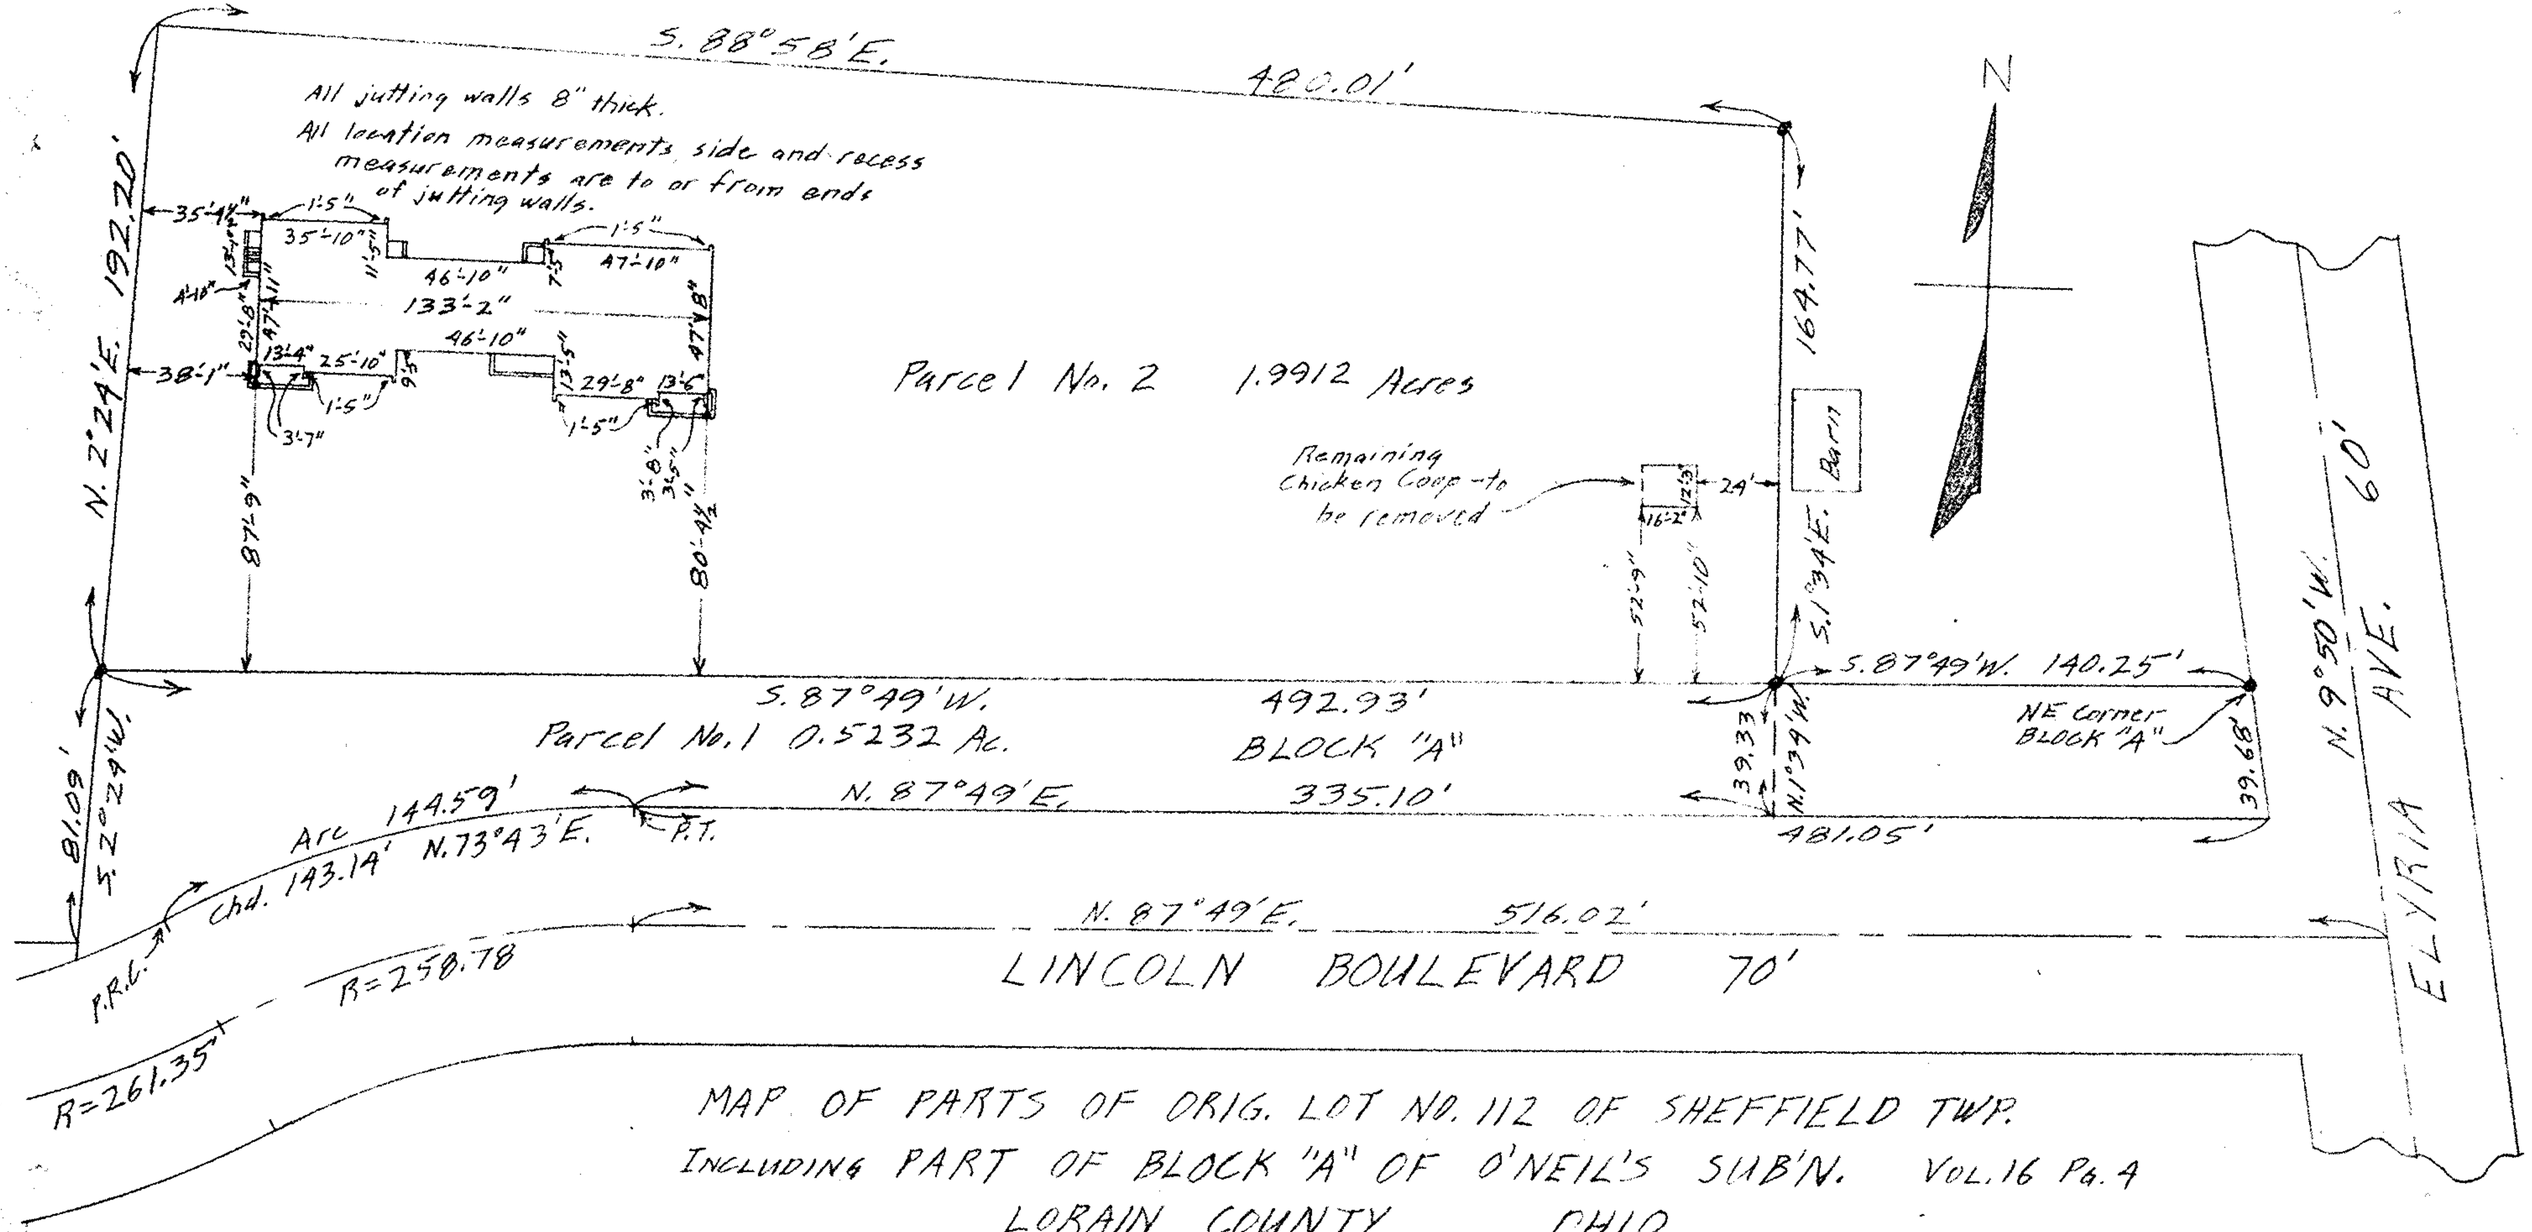

MAP OF PARTS OF ORIG. LOT NO. 112 OF SHEFFIELD TWP.
INCLUDING PART OF BLOCK "A" OF O'NEIL'S SUB'N. VOL. 16 PG. 4
LORAIN COUNTY OHIO
SCALE: 1"=50' MAY 11 - 1964 7:15 P.M.
Mary E. Benford REG. SURVEYOR

Sheffield Medical Park, Inc.