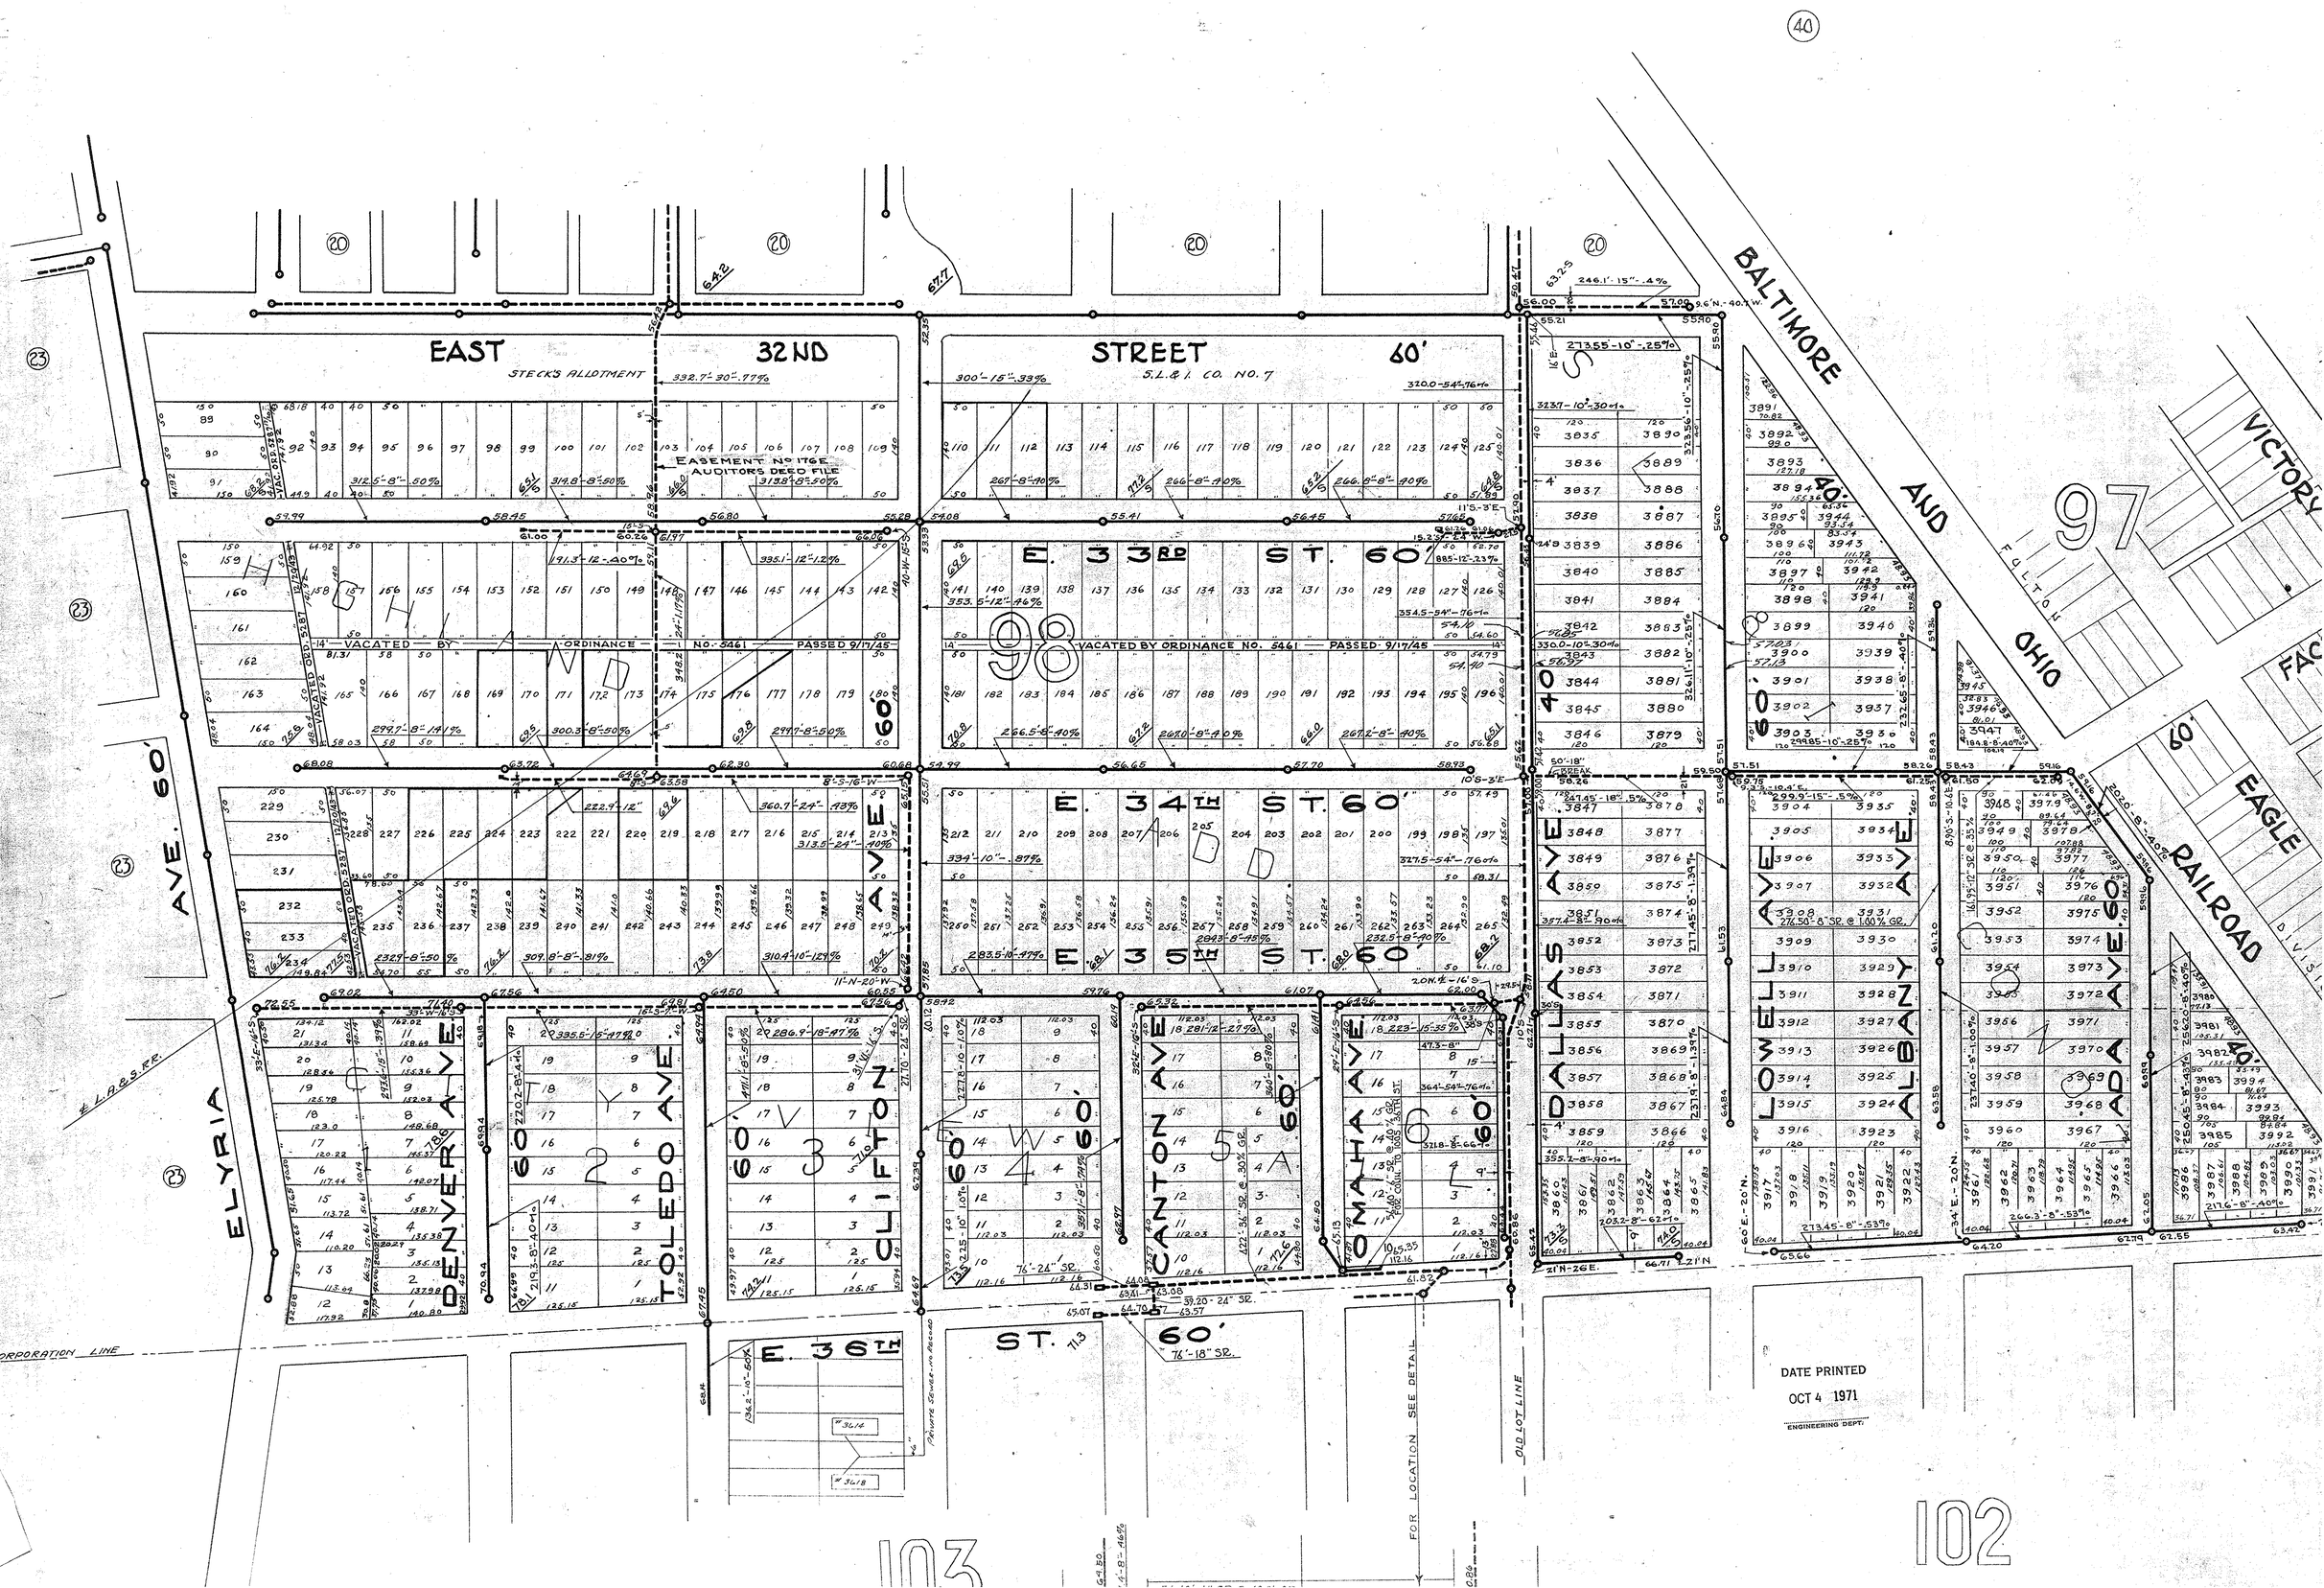
EAST 32ND STREET 60'
STECK'S ALLOTMENT
S.L.&I. CO. NO. 7
EASEMENT No 1762 AUDITORS DEED FILE
E. 33RD ST. 60'
E. 34TH ST. 60'
E. 35TH ST. 60'
E. 36TH ST. 60'
VACATED BY ORDINANCE No. 5461 PASSED 9/17/45
BALTIMORE AND OHIO
FULTON
VICTORY
EAGLE
RAILROAD
ELYRIA AVE. 60'
DENVER AVE.
TOLEDO AVE.
CLIFTON
CANTON AVE.
OMAHA AVE.
DALLAS AVE.
LOWELL AVE.
ALBANY AVE.
ADA AVE. 60'
CORPORATION LINE
OLD LOT LINE
FOR LOCATION SEE DETAIL
DATE PRINTED
OCT 4 1971
ENGINEERING DEPT.
97
98
102
103