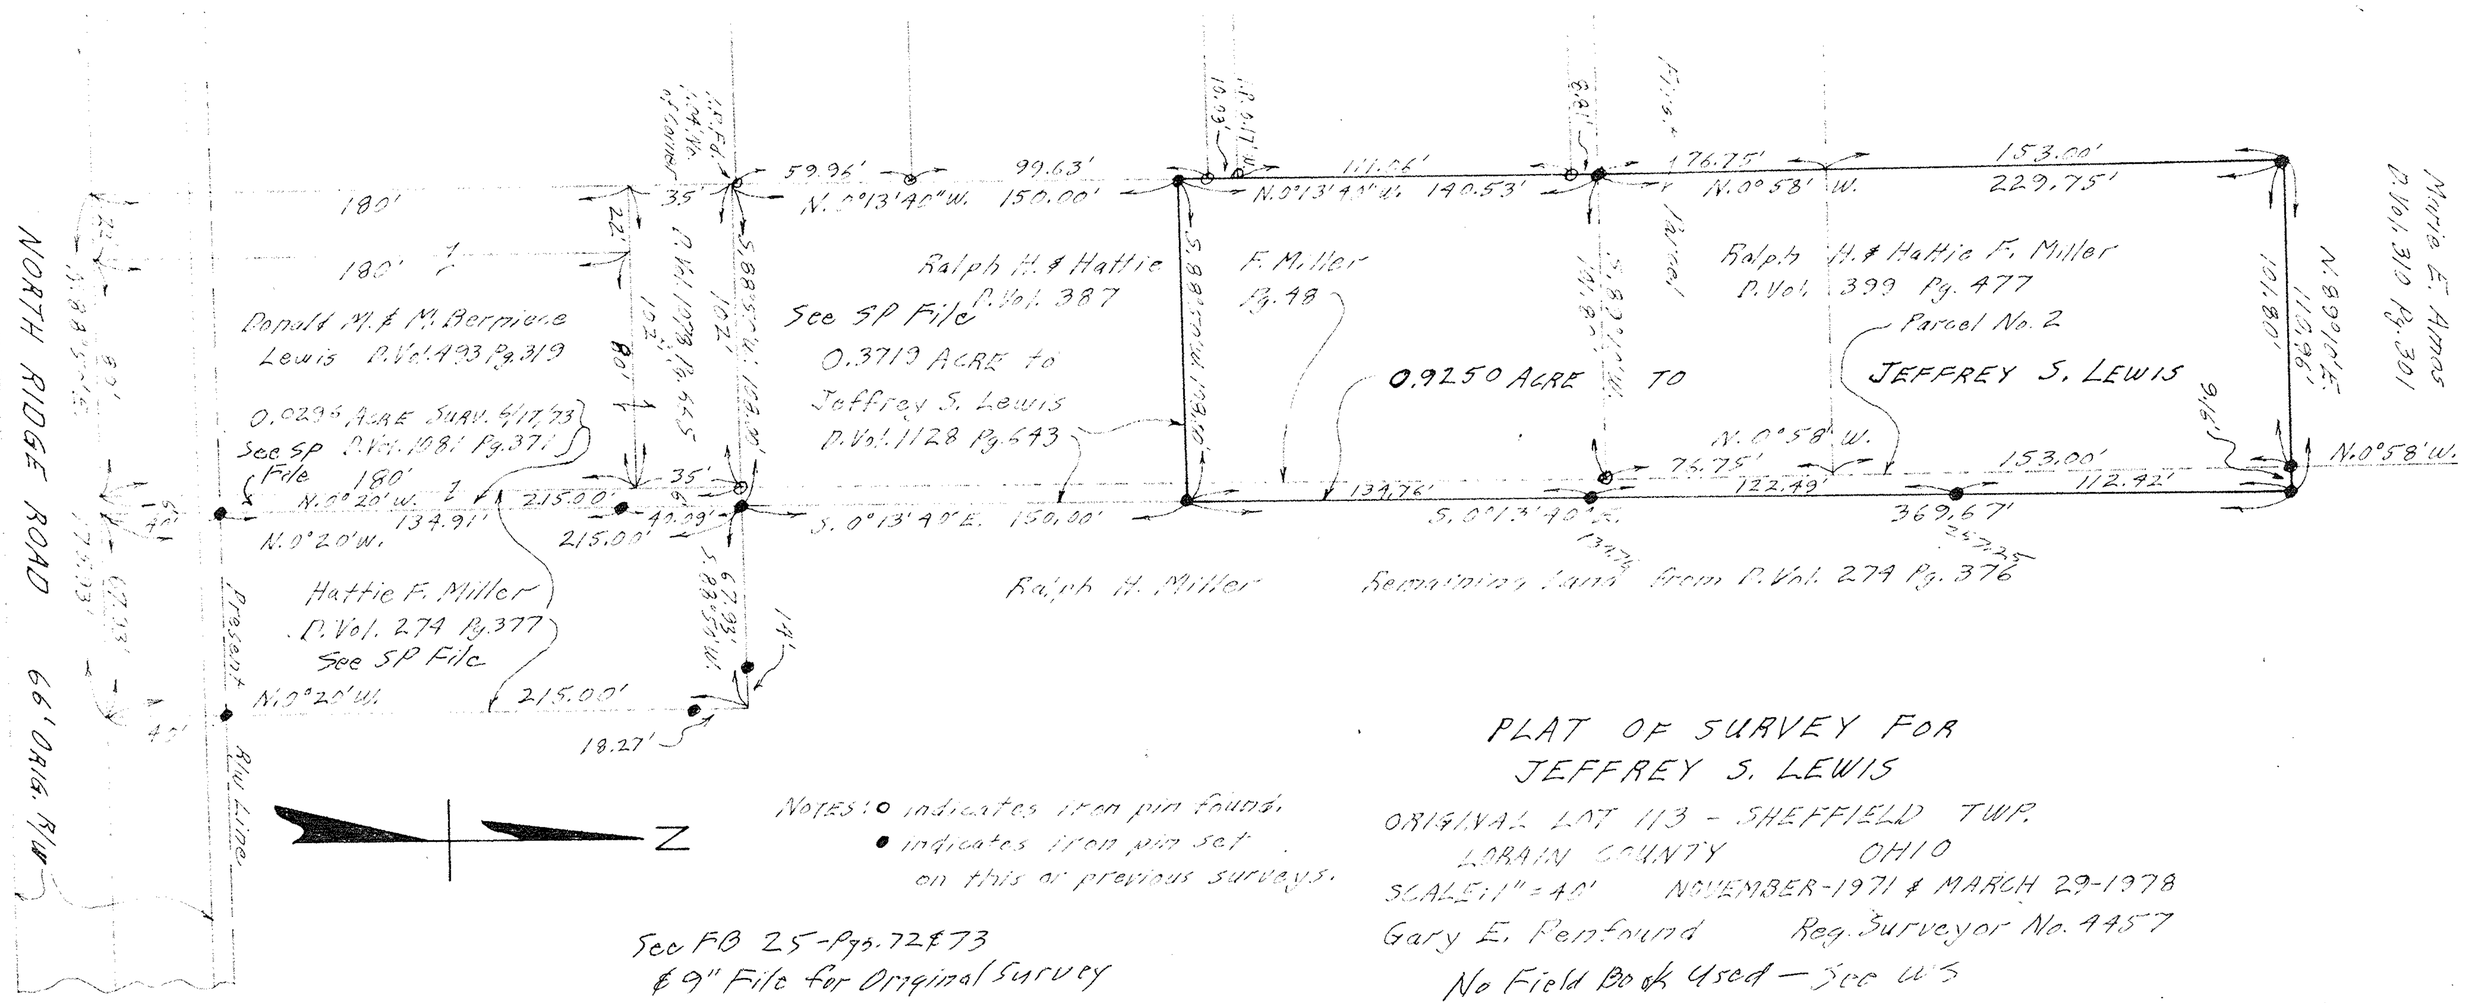


See FB 25 - Pgs. 72 & 73
& 9" File for Original Survey

# PLAT OF SURVEY FOR JEFFREY S. LEWIS

ORIGINAL LOT 113 - SHEFFIELD TWP.
LORAIN COUNTY OHIO
SCALE: 1" = 40' NOVEMBER-1971 & MARCH 29-1978
Gary E. Pentland Reg. Surveyor No. 4457
No Field Book Used — See N/S