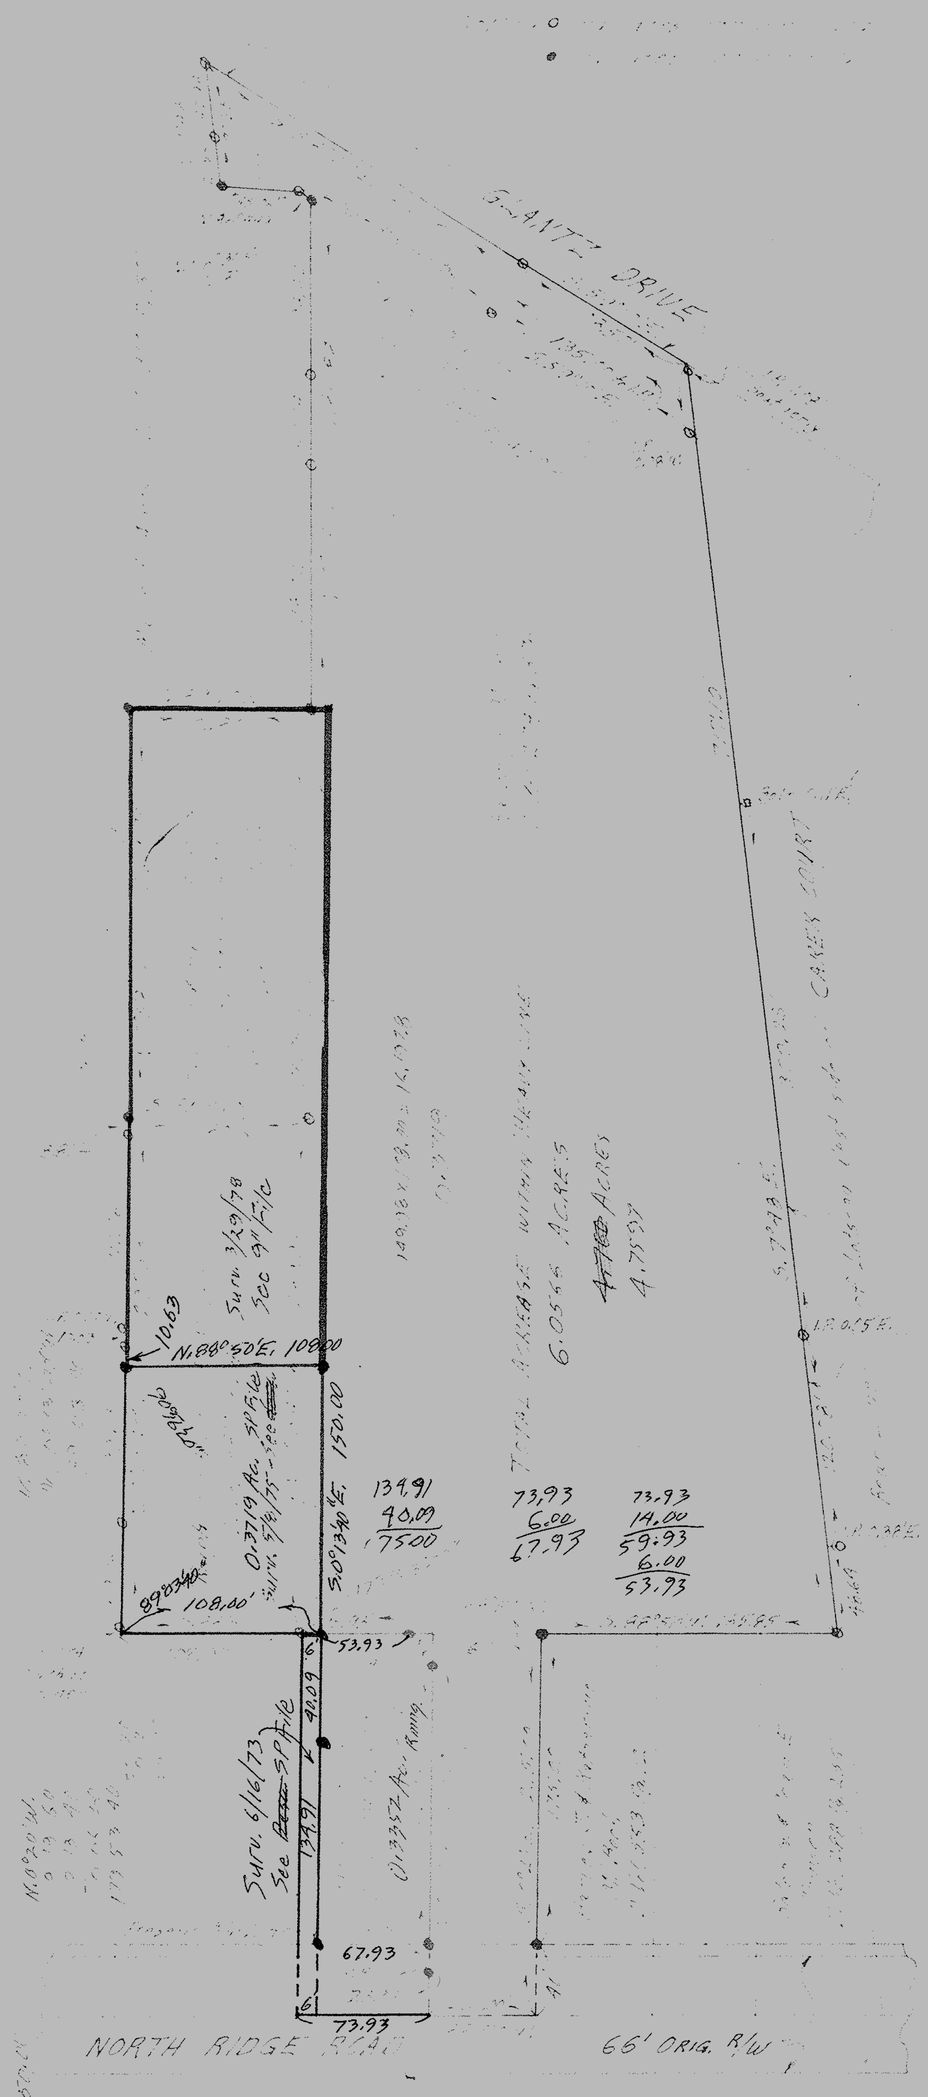

PLAT OF SURVEY FOR
RALPH H. & HATTIE F. MILLER
ORIGINAL LOT NO. 13 SHEFFIELD TWP.
LORAIN COUNTY OHIO
SCALE: 1" = 50' NOVEMBER 1971
Gary E. Penfield
Reg. Surveyor No. 4457
See Field Book 25 - Pgs. 72 & 73