MAP OF PARTS OF ORIG. LOT NO. 1
TRACT NO. 3 BLACK RIVER TWP.
LORAIN CITY - LORAIN COUNTY - OHIO
SCALE: 1" = 30' JUNE 7-1968 7:00 P.M.
Gary E. Penfound REG. SURVEYOR

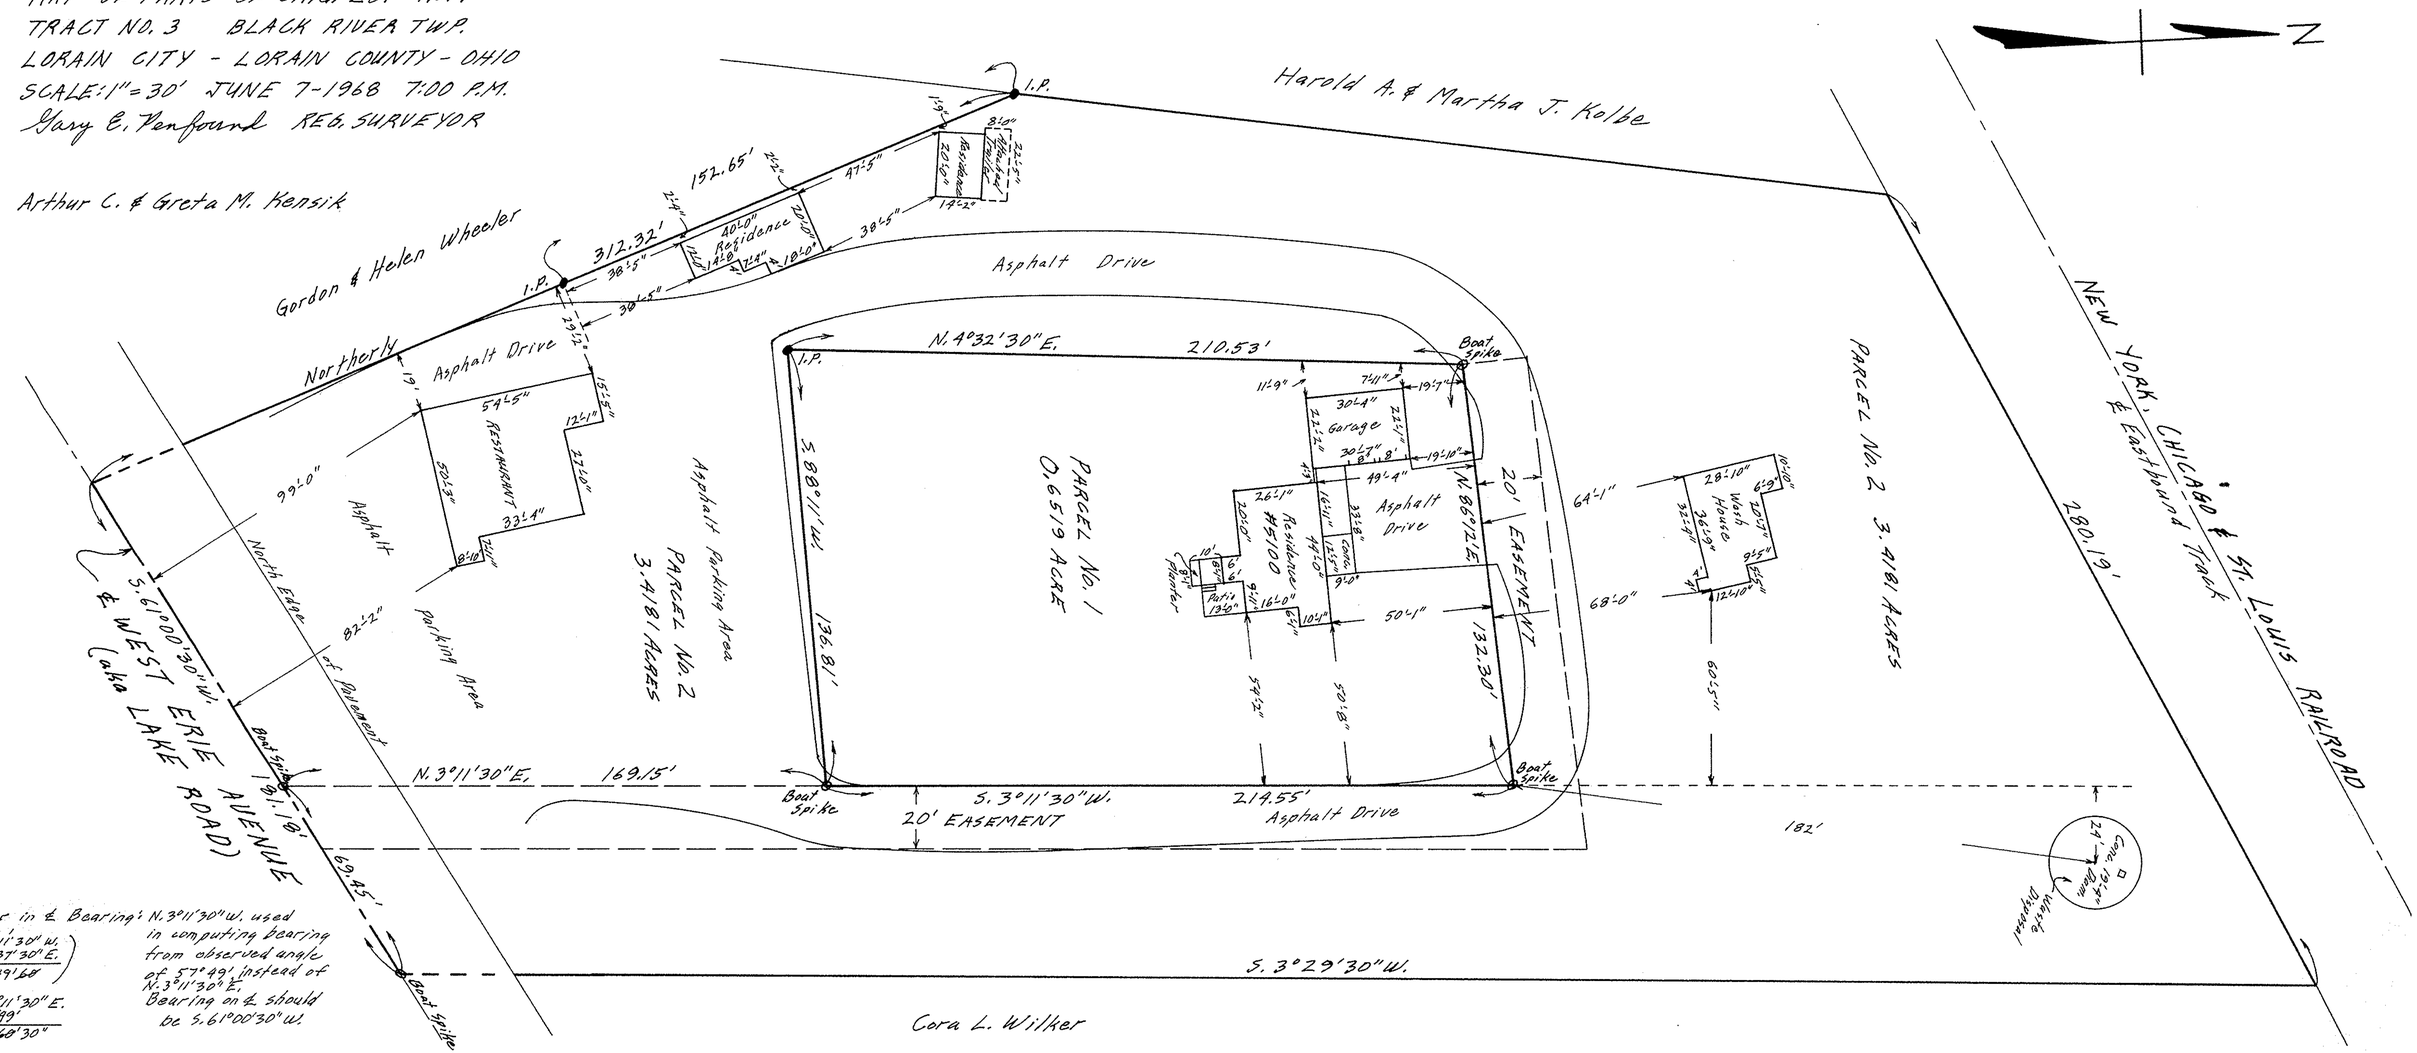

Error in ℄ Bearing: N. 3°11'30" W. used in computing bearing from observed angle of 57°49' instead of N. 3°11'30" E. Bearing on ℄ should be S. 61°00'30" W.

N. 3°11'30" W.
N. 54°37'30" E.
57°49'60"

N. 3°11'30" E.
+ 57°49'
61°60'30"