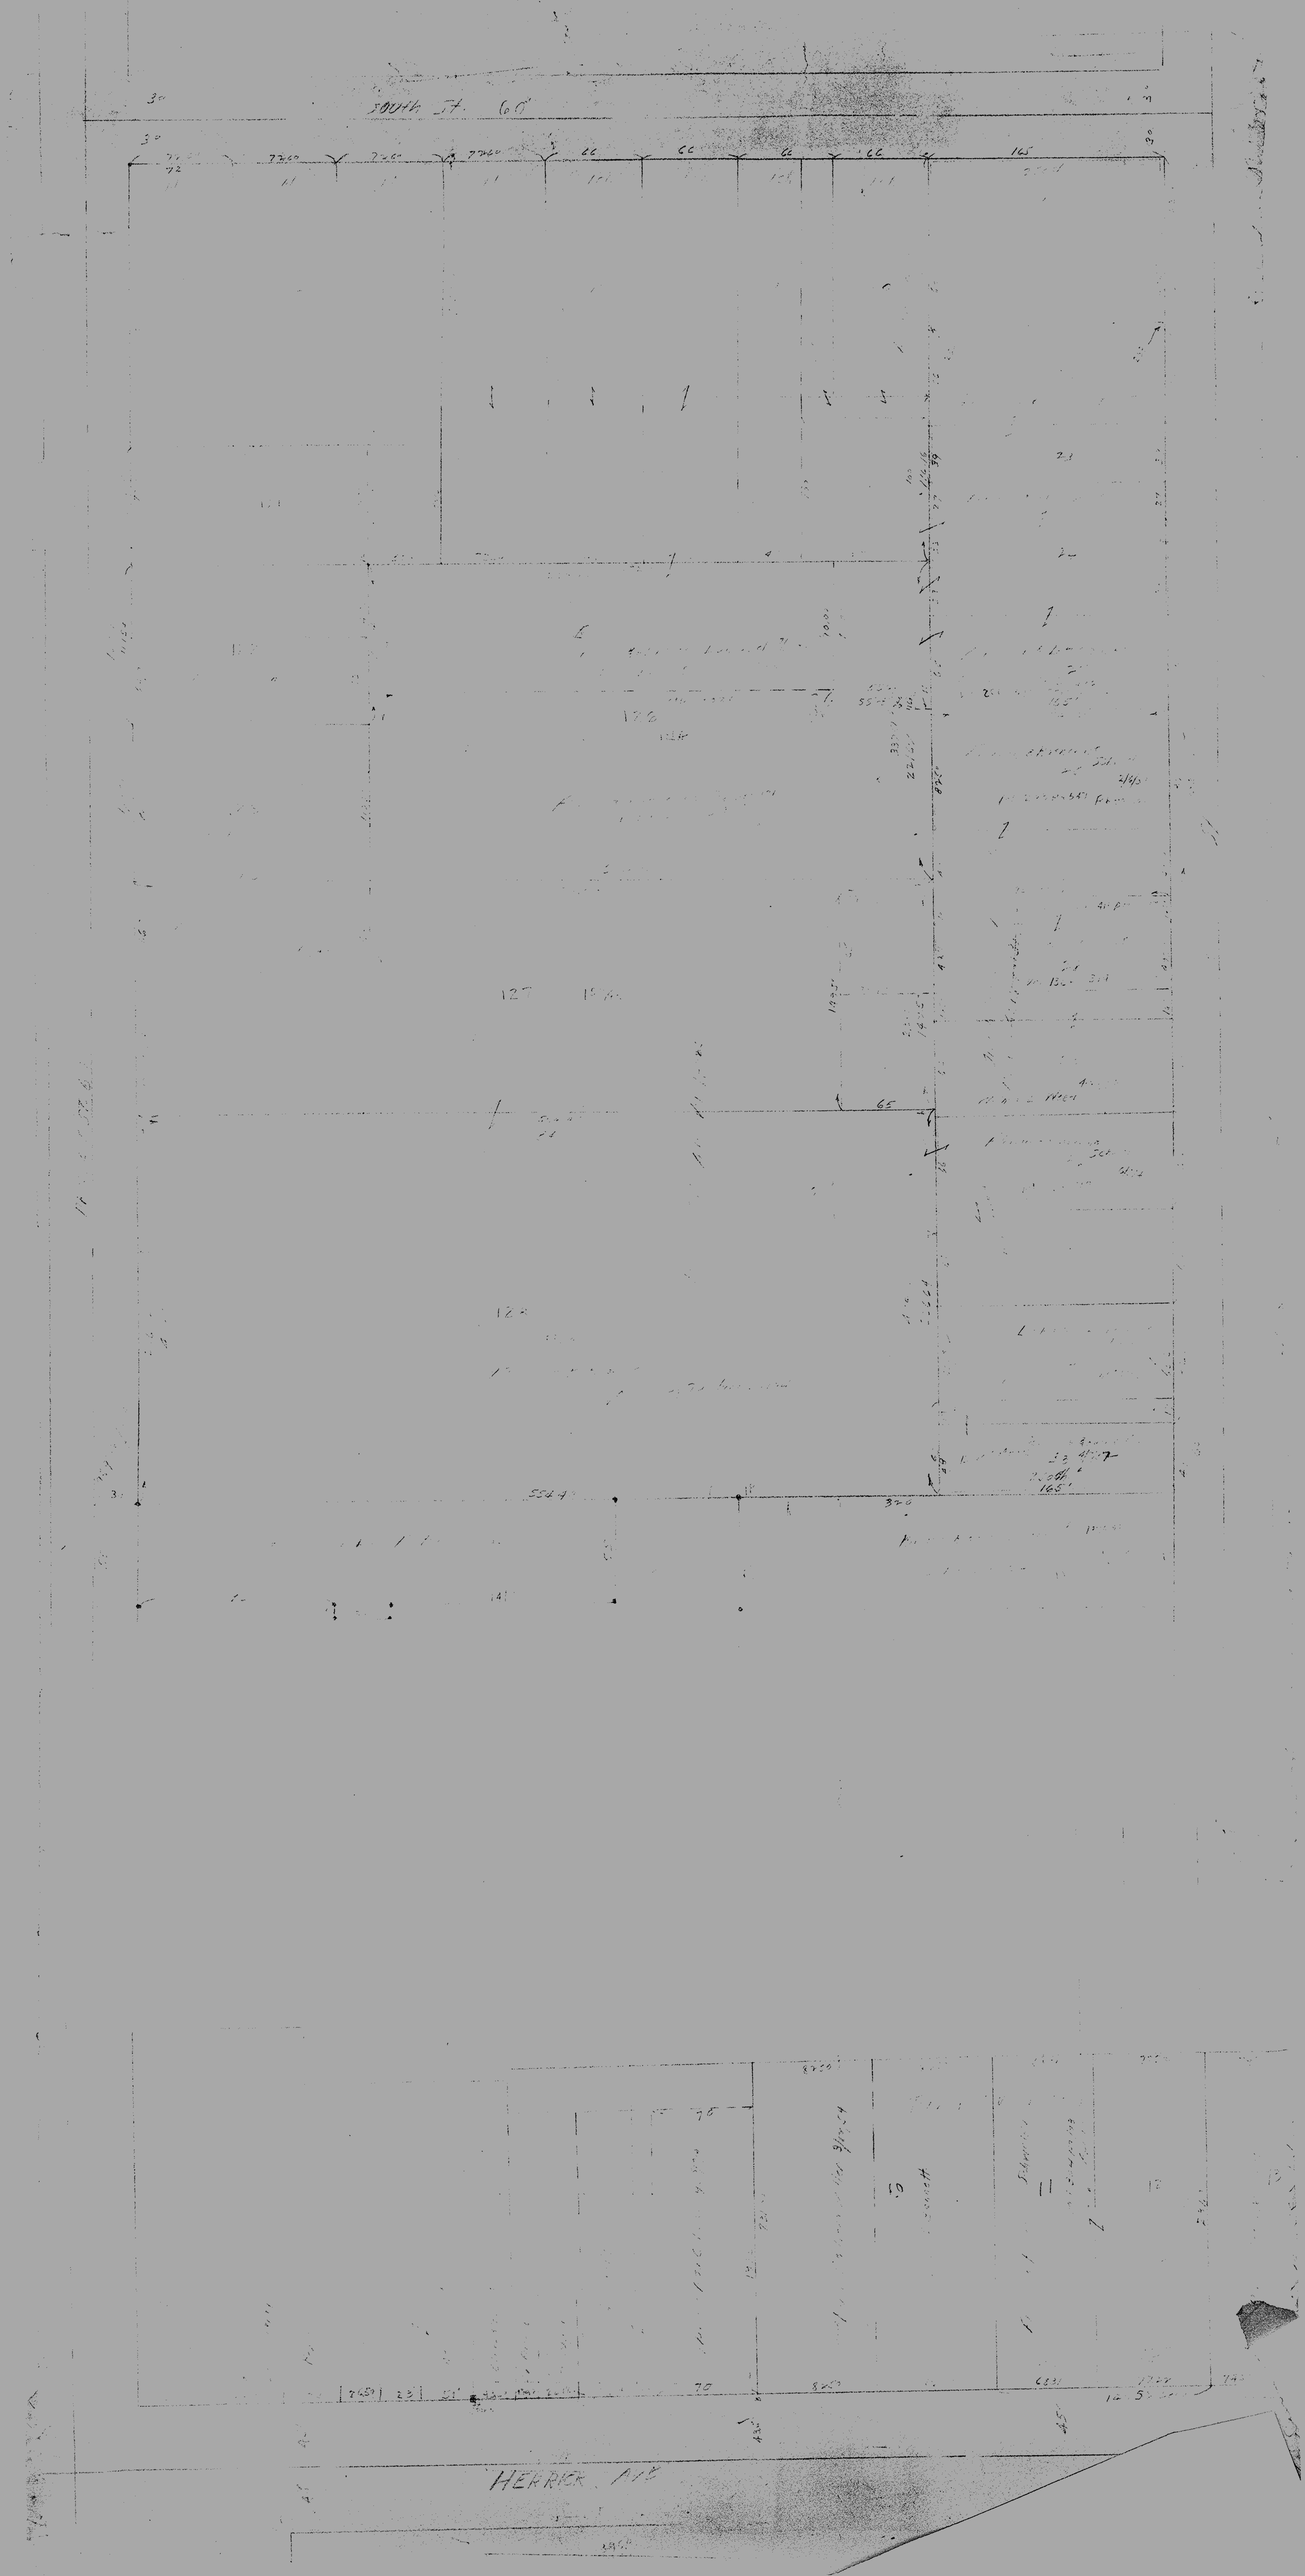
SOUTH ST. 60'
HERRICK AVE