PLAT OF SURVEY FOR
JAMES M. O'BRIEN & PHYLLIS A. O'BRIEN
DIVISION OF 25.2938 ACRES IN ORIGINAL
LOT NO. 98 OF RUSSIA TOWNSHIP
LORAIN COUNTY OHIO
SCALE: 1" = 100' AUG. 1982 & MAR. - 1983
Gary E. Penfound Reg. Surveyor No. 4457
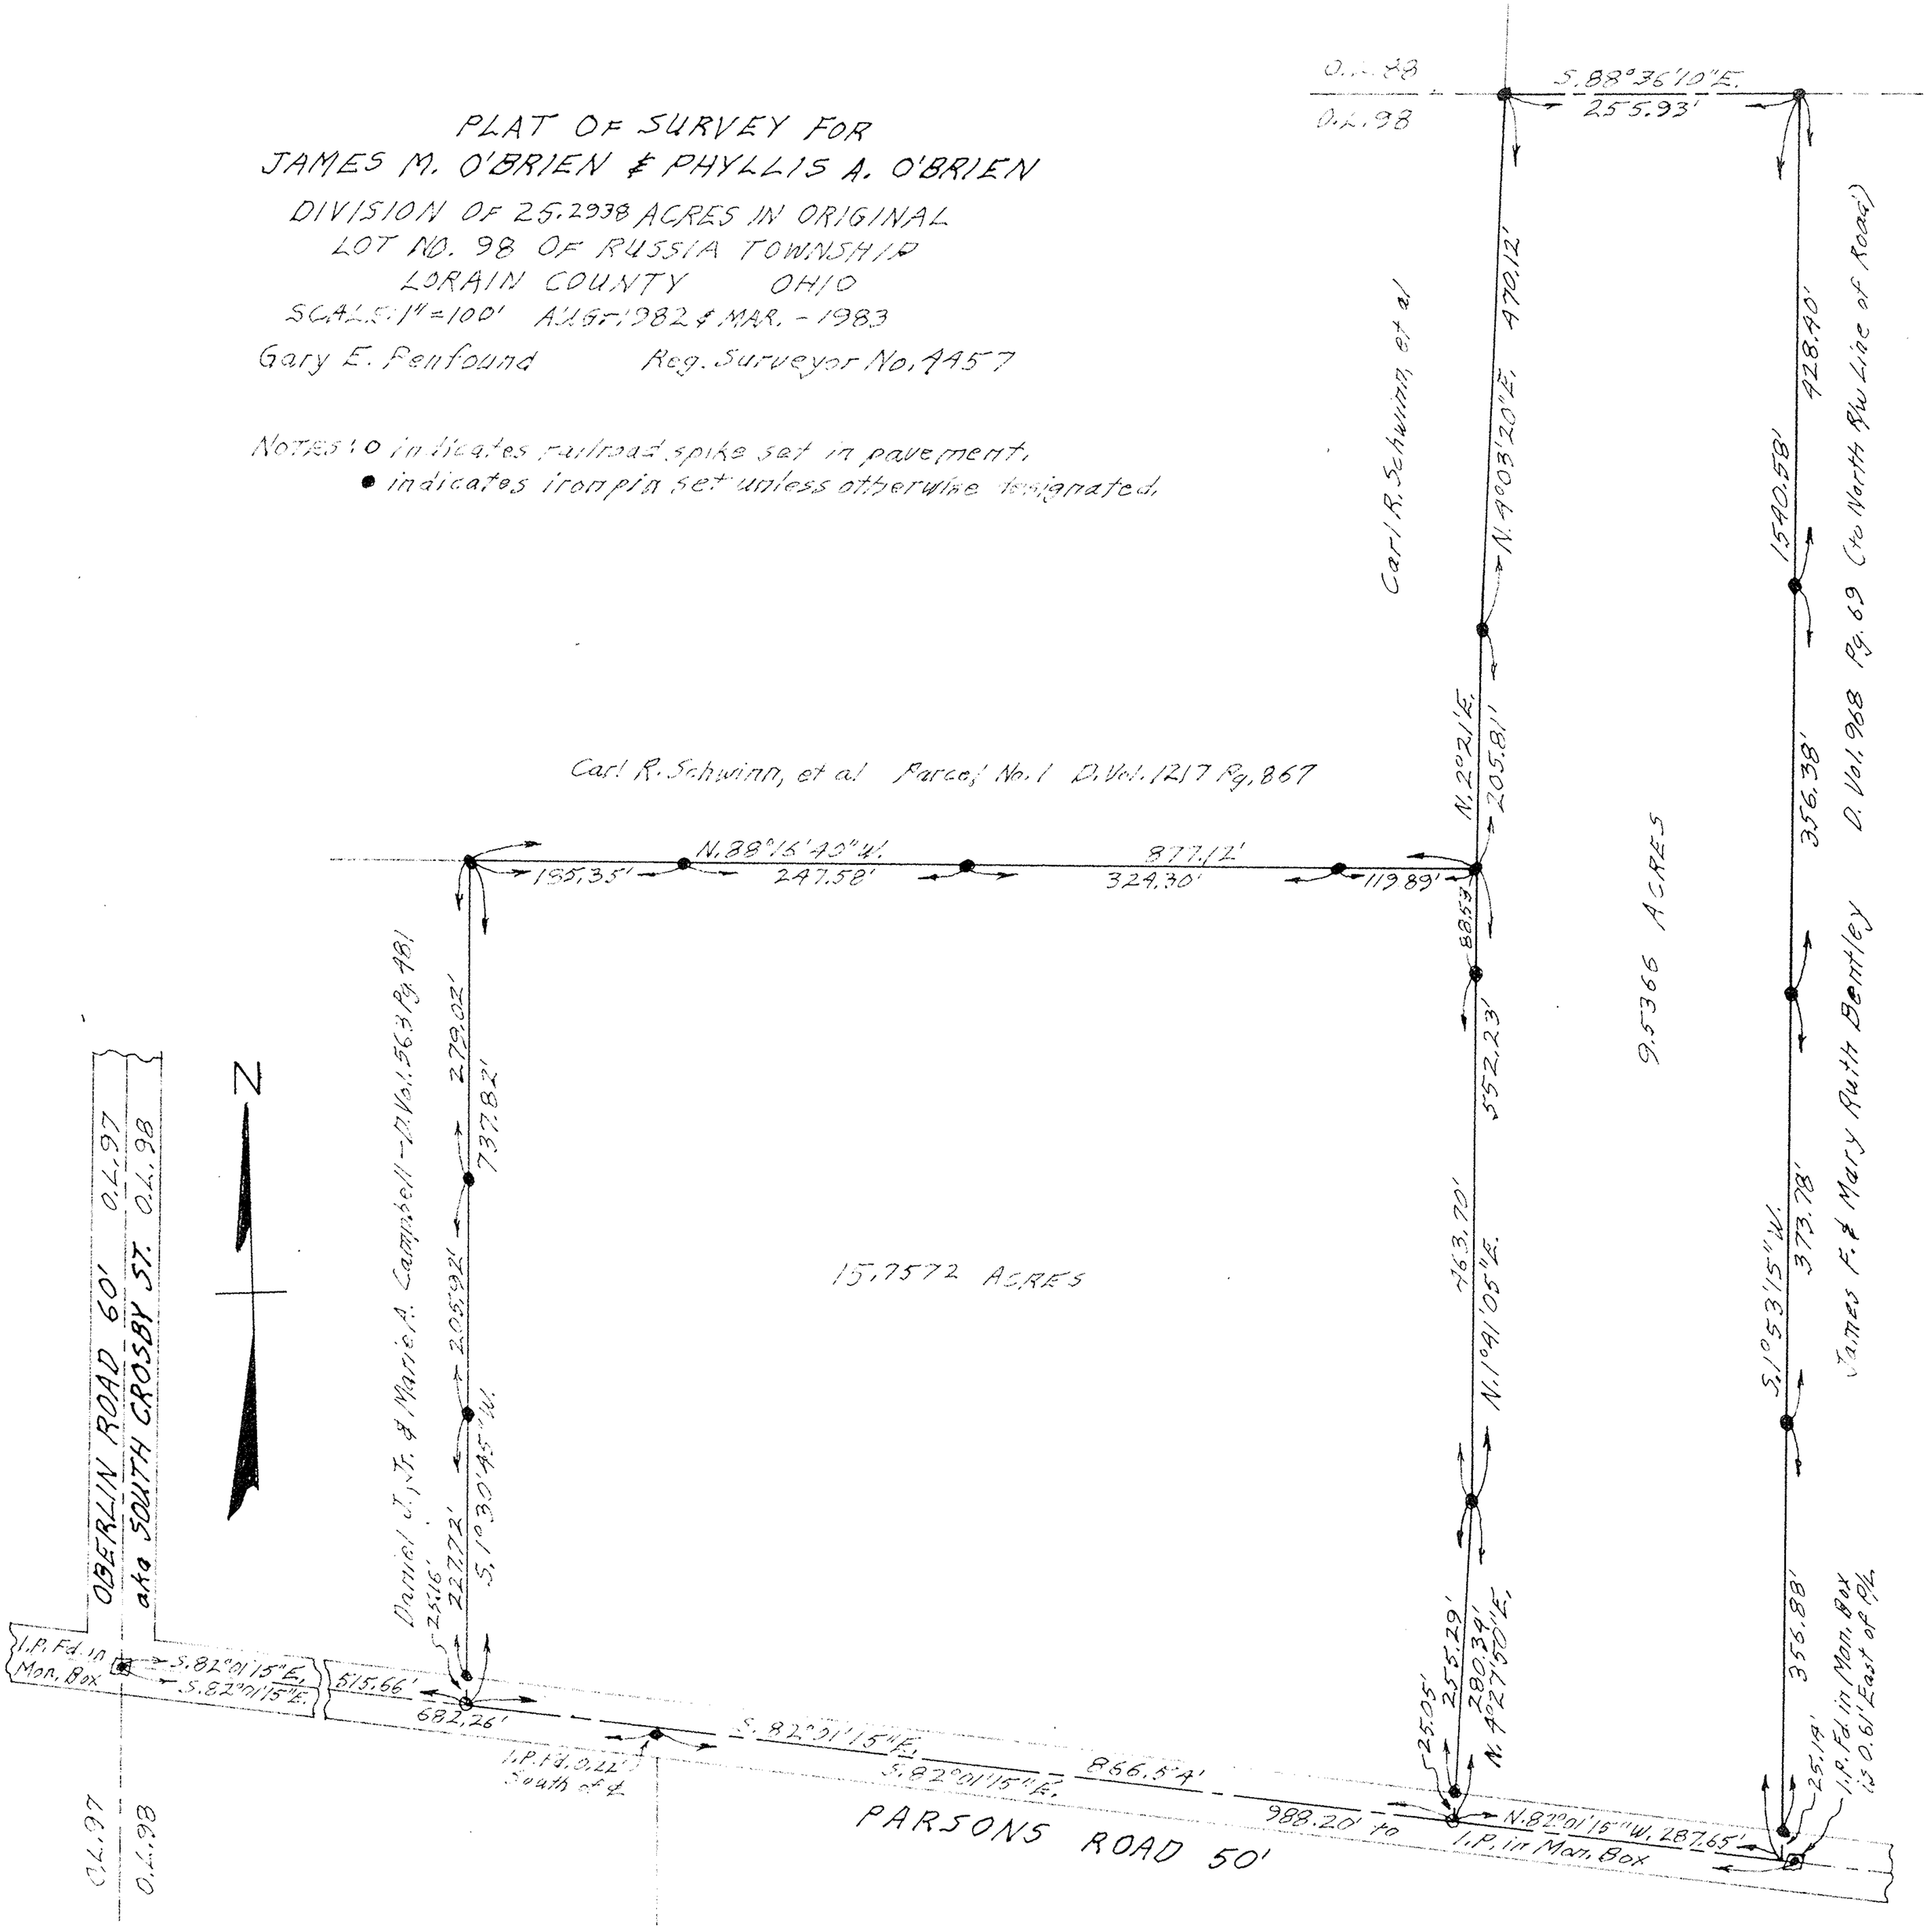
NOTES: o indicates railroad spike set in pavement.
● indicates iron pin set unless otherwise designated.