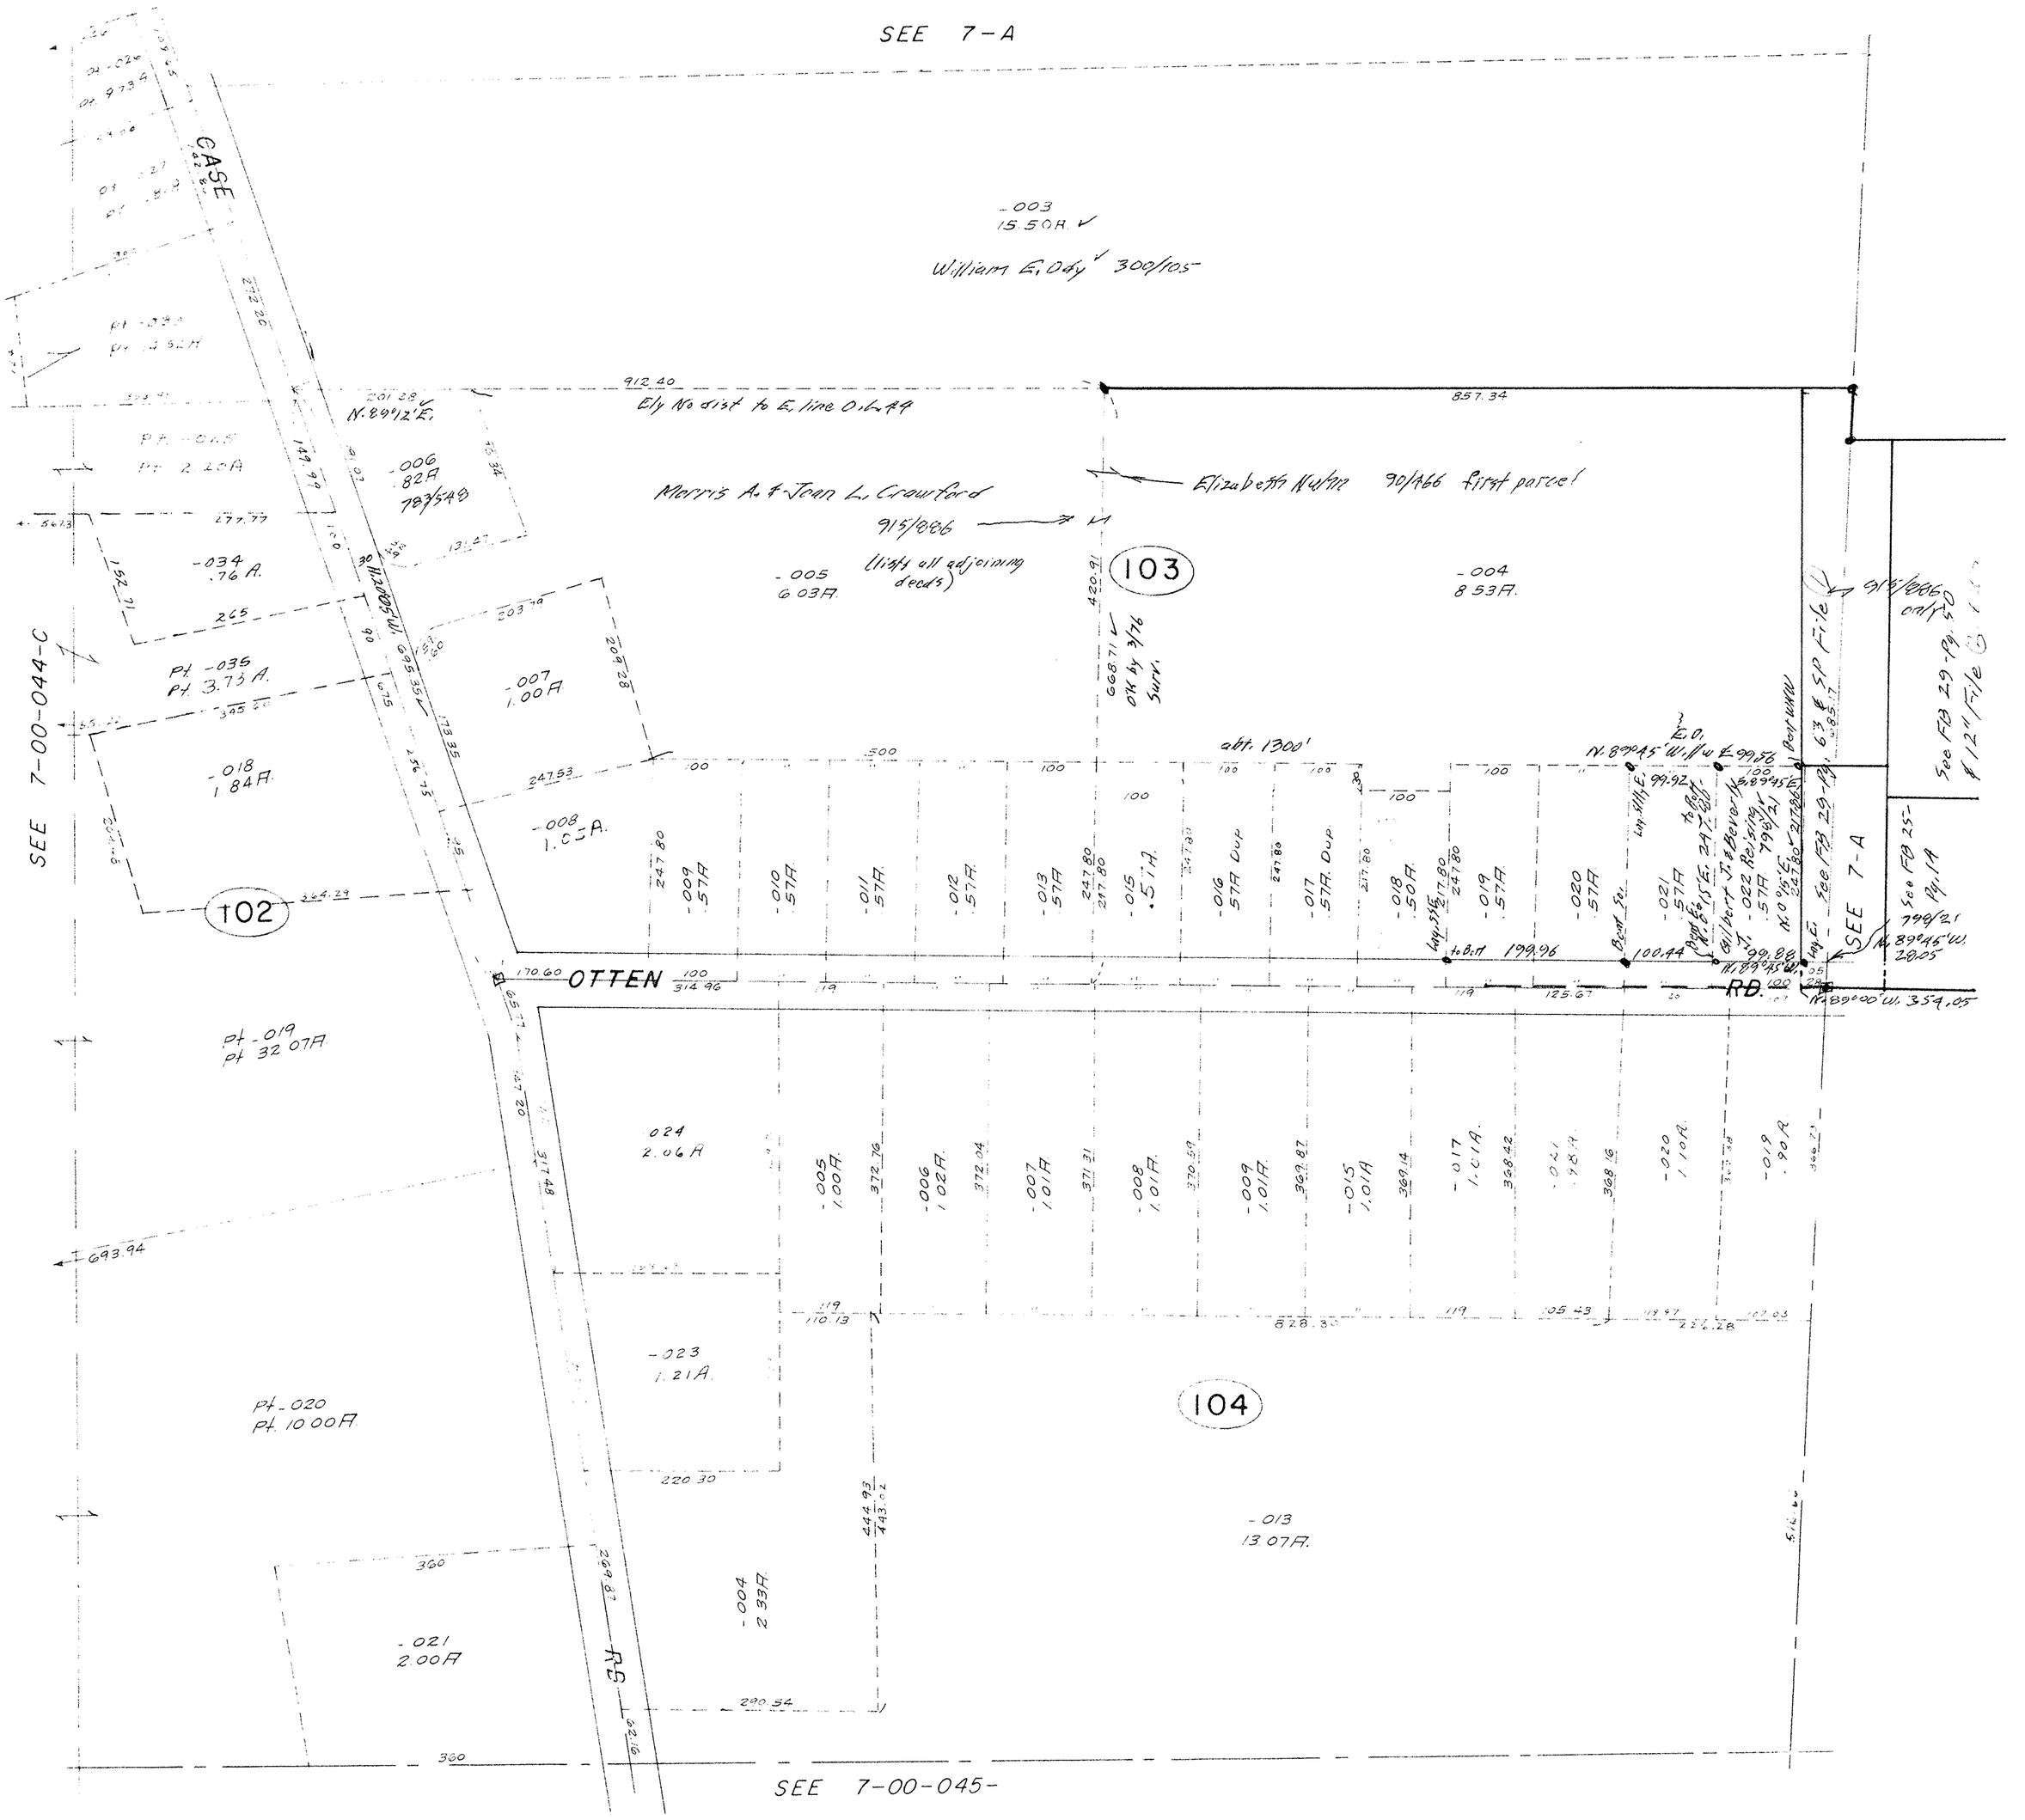

RIDGEVILLE TWP.

SCALE: 1" = 100'

SE 1/4 LOT 44

Copyright 1964

7-00-044-D