


Southeasterly Line of CLEVELAND ST. 66' R/W

NOTES: ○ indicates iron pin found.  
● indicates iron pin set.  
+ indicates reference cross cut.  
x indicates cross cut in concrete on property corner.

Gary E. Penfound Reg. Surveyor No. 4457

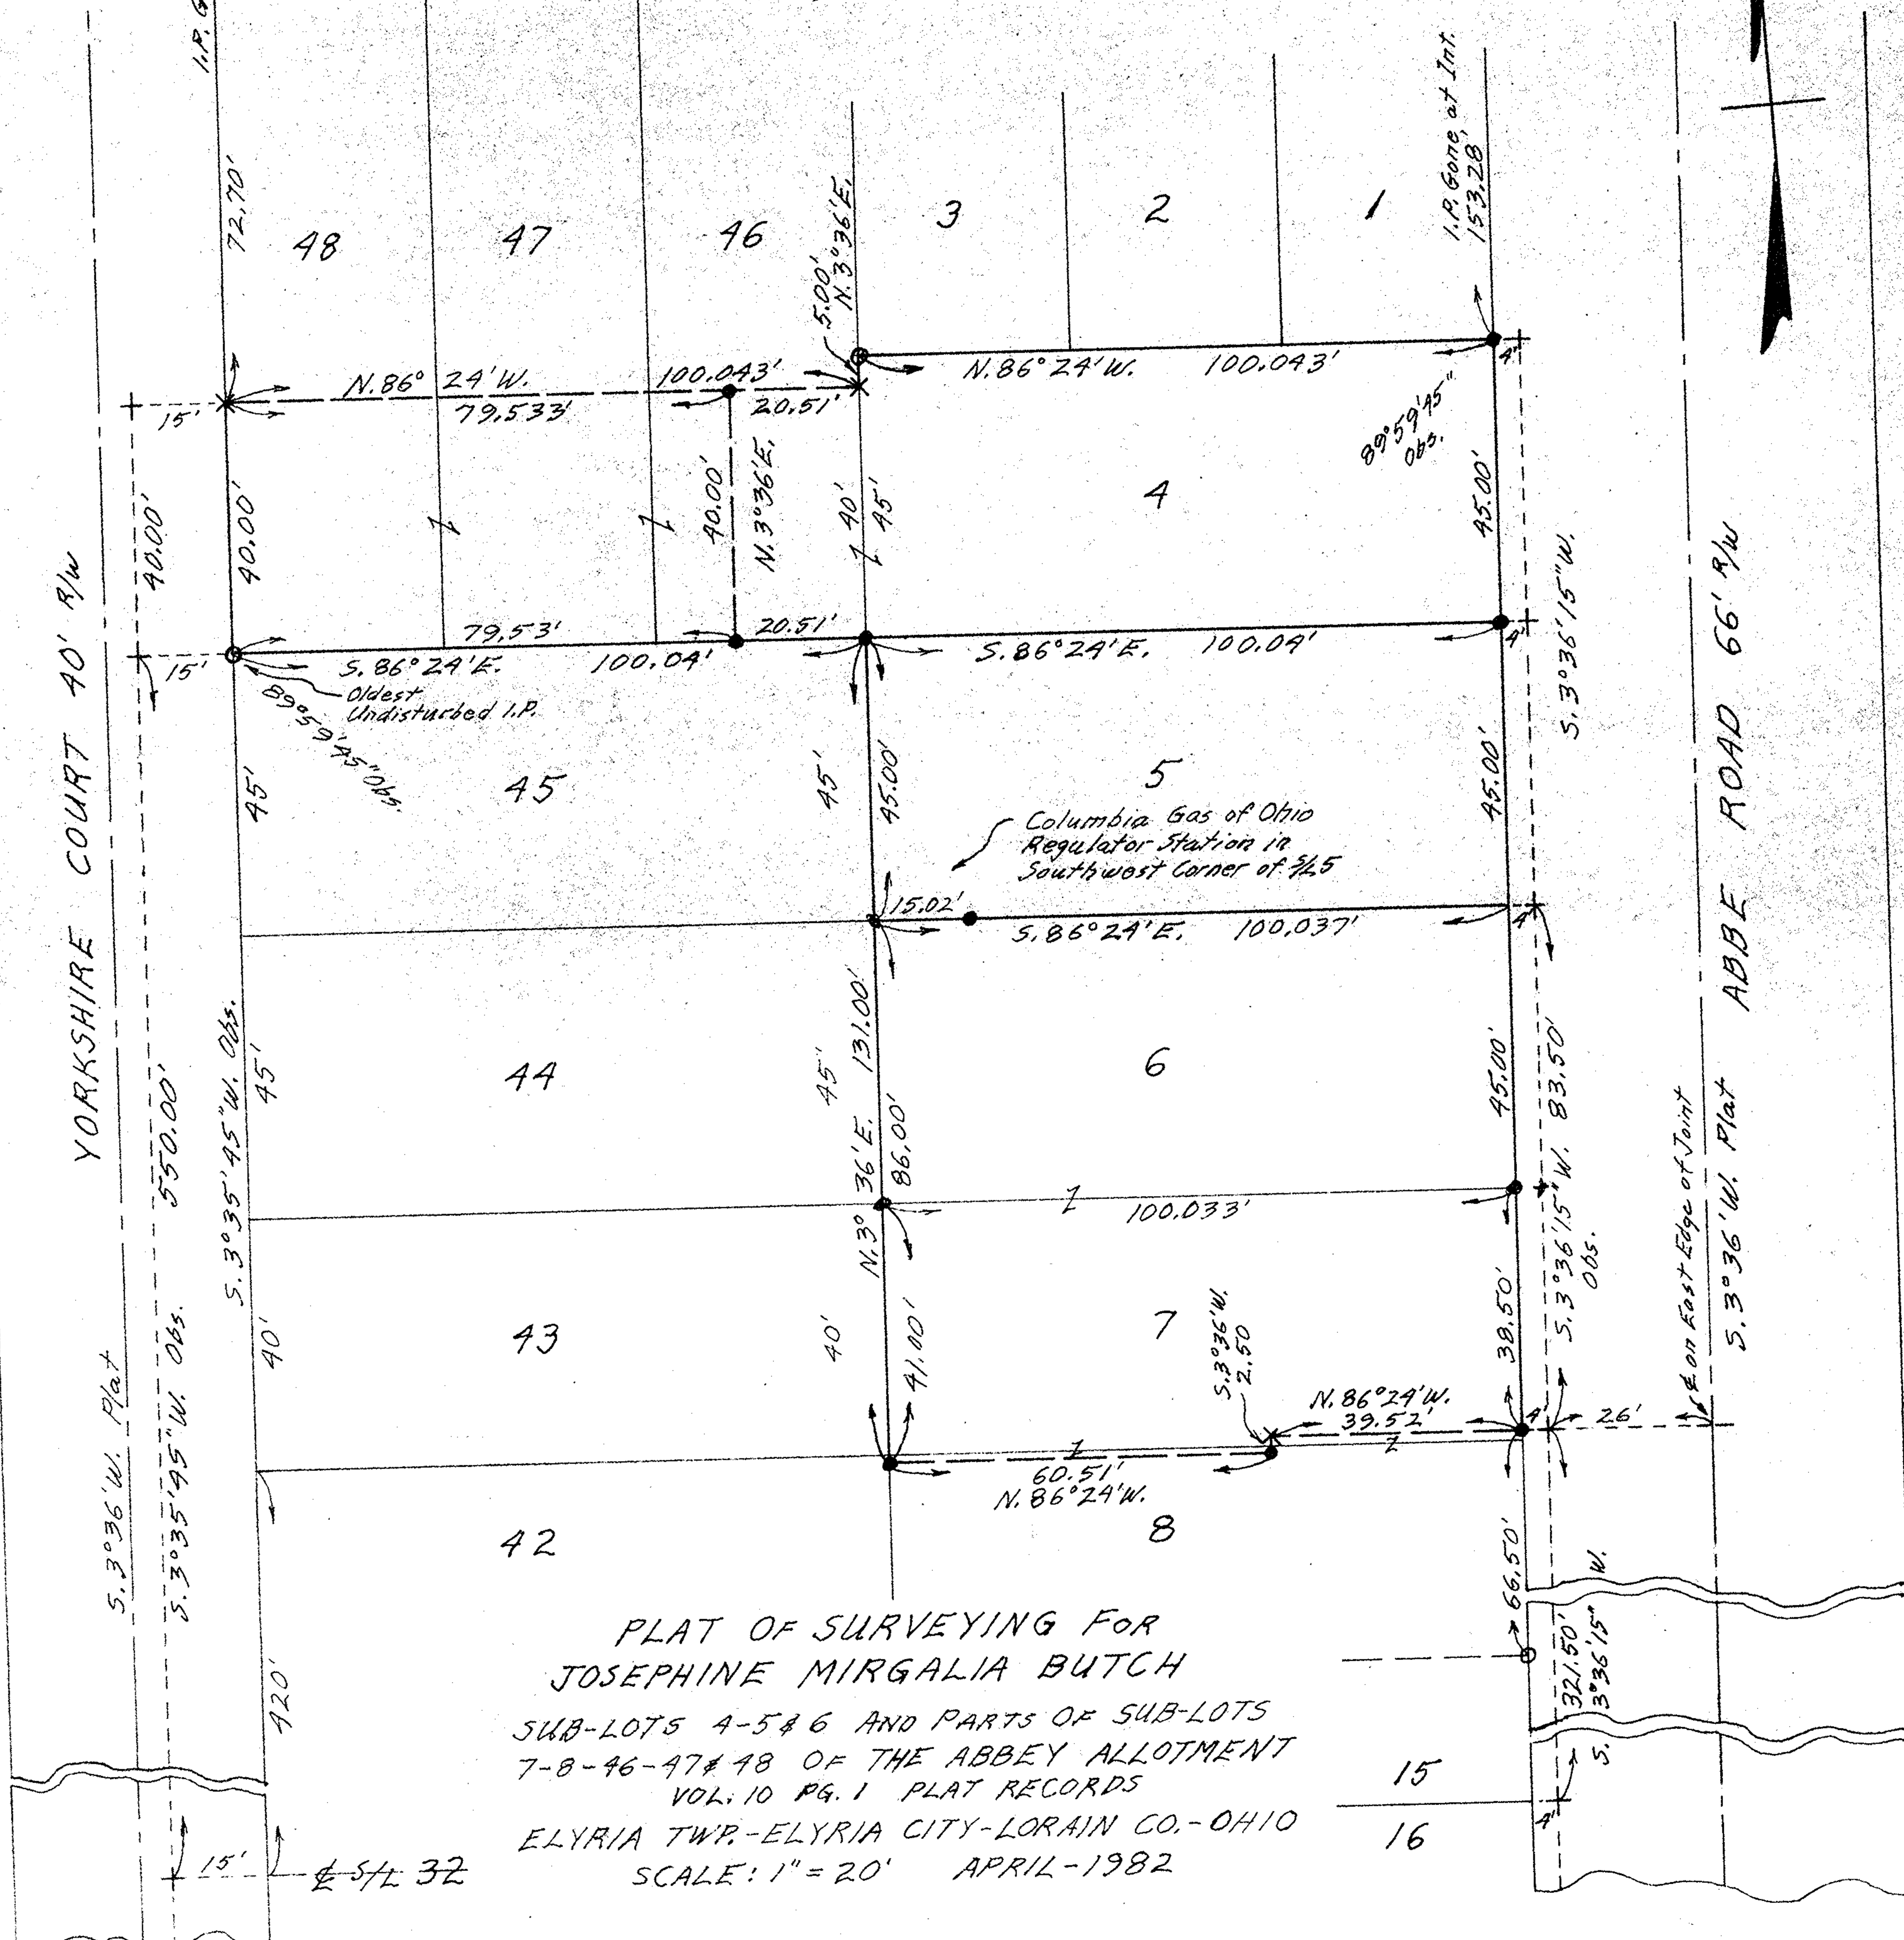

PLAT OF SURVEYING FOR  
 JOSEPHINE MIRGALIA BUTCH  
 SUB-LOTS 4-5 & 6 AND PARTS OF SUB-LOTS  
 7-8-46-47 & 48 OF THE ABBEY ALLOTMENT  
 VOL. 10 PG. 1 PLAT RECORDS  
 ELYRIA TWP.-ELYRIA CITY-LORAIN CO.-OHIO  
 SCALE: 1" = 20' APRIL-1982

YORKSHIRE COURT 40' R/W

ABBE ROAD 66' R/W

5.3°36' W. Plat

5.3°35'45" W. Obs.

5.3°35'45" W. Obs.

420'

15' S/L 32

Joint on East Edge of Joint

5.3°36' W. Plat

321.50'  
5.3°36'15" W.

15

16