643507

643507

HIGHLAND ACRES SUBD'N No 2 SEC-B

PART OF O.L. 24 WEST OF RIVER ELYRIA TOWNSHIP

ELYRIA CITY LORAIN COUNTY OHIO

SCALE 1"=60' SEPTEMBER 1963

BY - RAY E. HOLLIS REGISTERED SURVEYOR

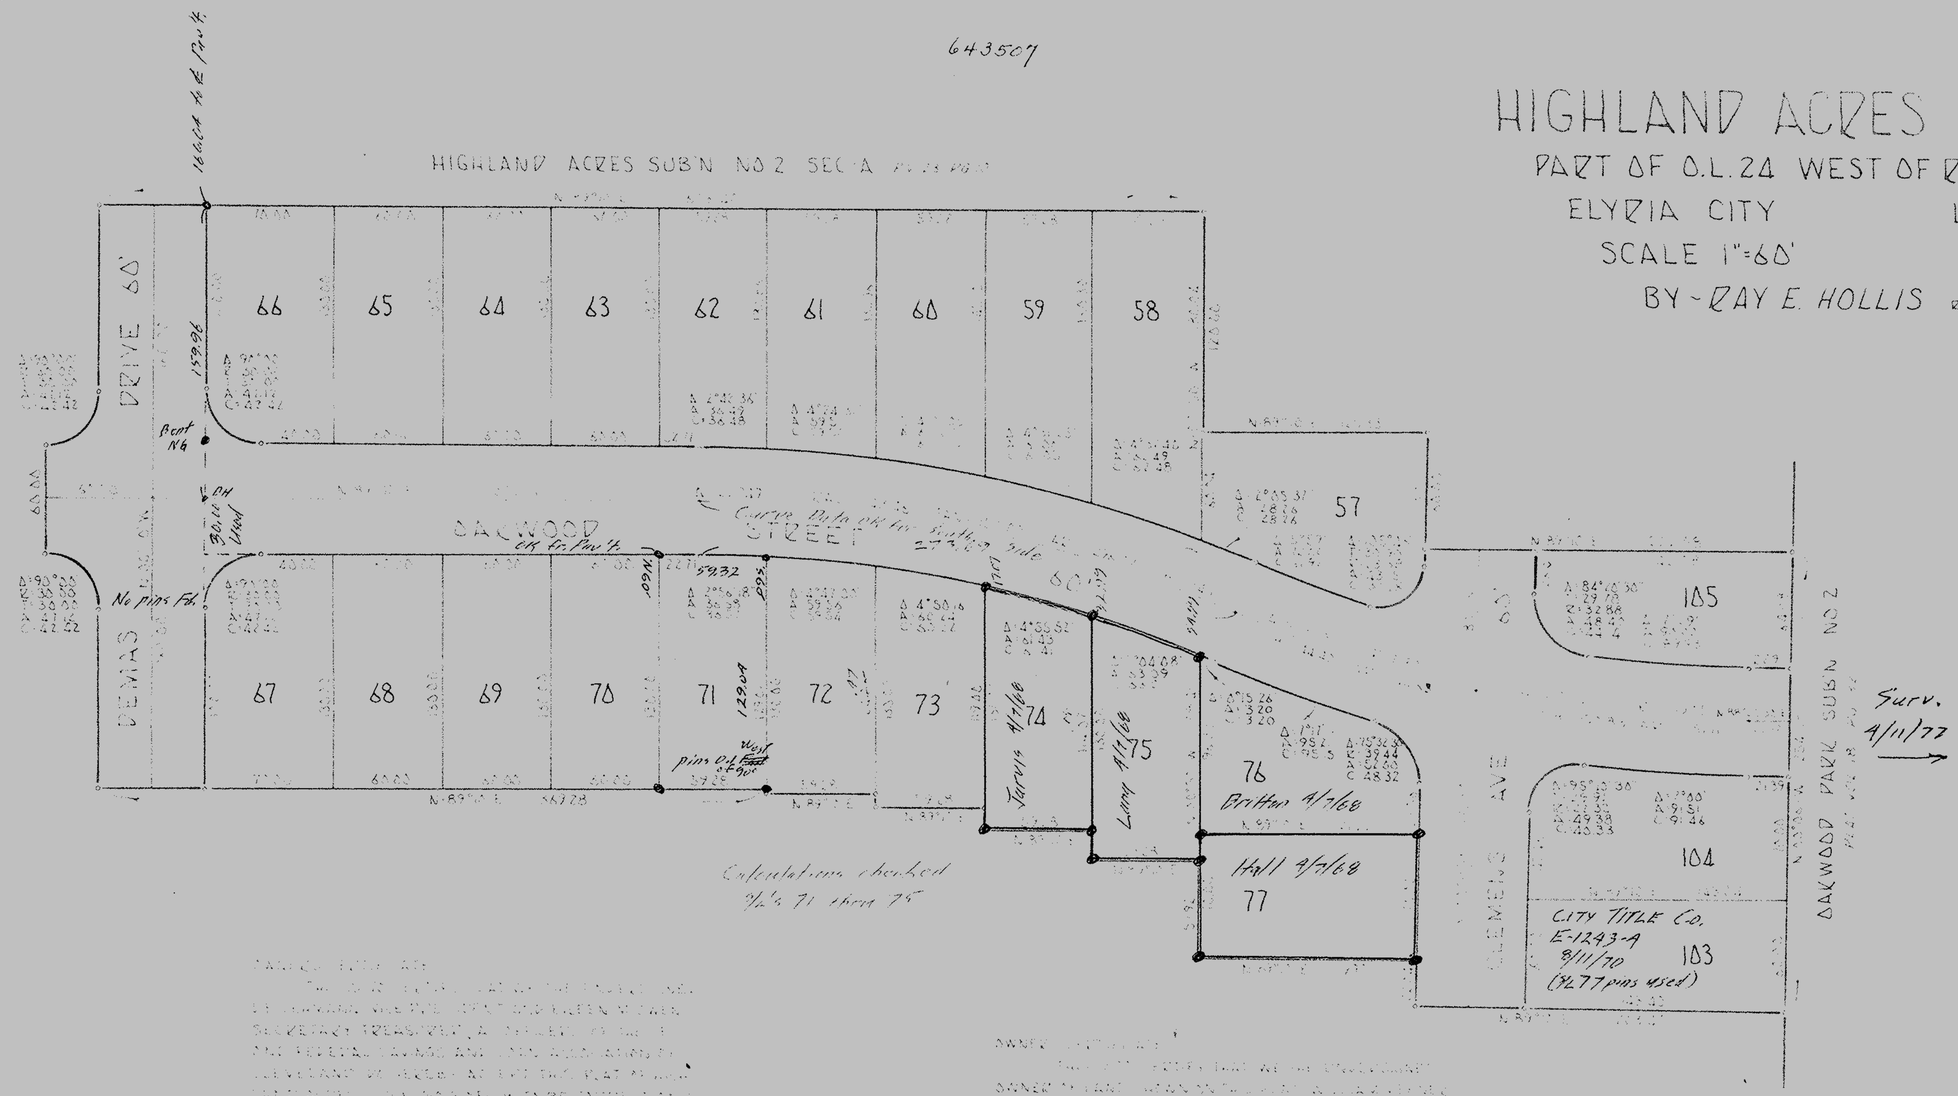

SURVEYOR'S CERTIFICATE

THIS IS TO CERTIFY THAT THE ABOVE PLAT OF HIGHLAND ACRES SUBD'N NO 2 SEC-B WAS MADE AT THE REQUEST OF THE OWNERS SECOND FEDERAL SAVINGS AND LOAN ASSOC. OF CLEVELAND AND EMBRACES A TOTAL OF 6.5966 ACRES OF LAND IN ORIG LOT 24 WEST OF BLACK RIVER, ELYRIA TWP NOW ELYRIA CITY, LORAIN COUNTY OHIO AT ALL POINTS SO INDICATED — IRON PIN MONUMENTS WERE FOUND OR SET ALL DISTANCES ARE IN FEET AND DECIMAL PARTS THEREOF, ALL OF WHICH I CERTIFY TO BE CORRECT

ACREAGE IN LOTS 4.6314

ACREAGE IN STS 1.9652

Ray E. Hollis
Reg. Surveyor

THIS IS TO CERTIFY THAT THE FOREGOING PLAT OF HIGHLAND ACRES SUBD'N NO 2 SEC-B WAS APPROVED ON THIS 30 DAY OF OCT 1963 BY THE PLANNING COMMISSION OF THE CITY OF ELYRIA

J. J. [illegible]
SECRETARY

THIS IS TO CERTIFY THAT I HAVE EXAMINED THE FOREGOING PLAT AND HEREBY APPROVE THE SAME [illegible]

R. E. Glimcoder
[illegible]

THIS IS TO CERTIFY THAT THIS PLAT OF HIGHLAND ACRES SUBD'N NO 2 SEC-B WAS APPROVED AND ACCEPTED BY THE [illegible] OF THE CITY OF ELYRIA BY ORDINANCE NO [illegible] PASSED THE [illegible] DAY OF [illegible], 1970.

[illegible]
MAYOR

[illegible]
CLERK OF COUNCIL

8:07 A.

Plat 23