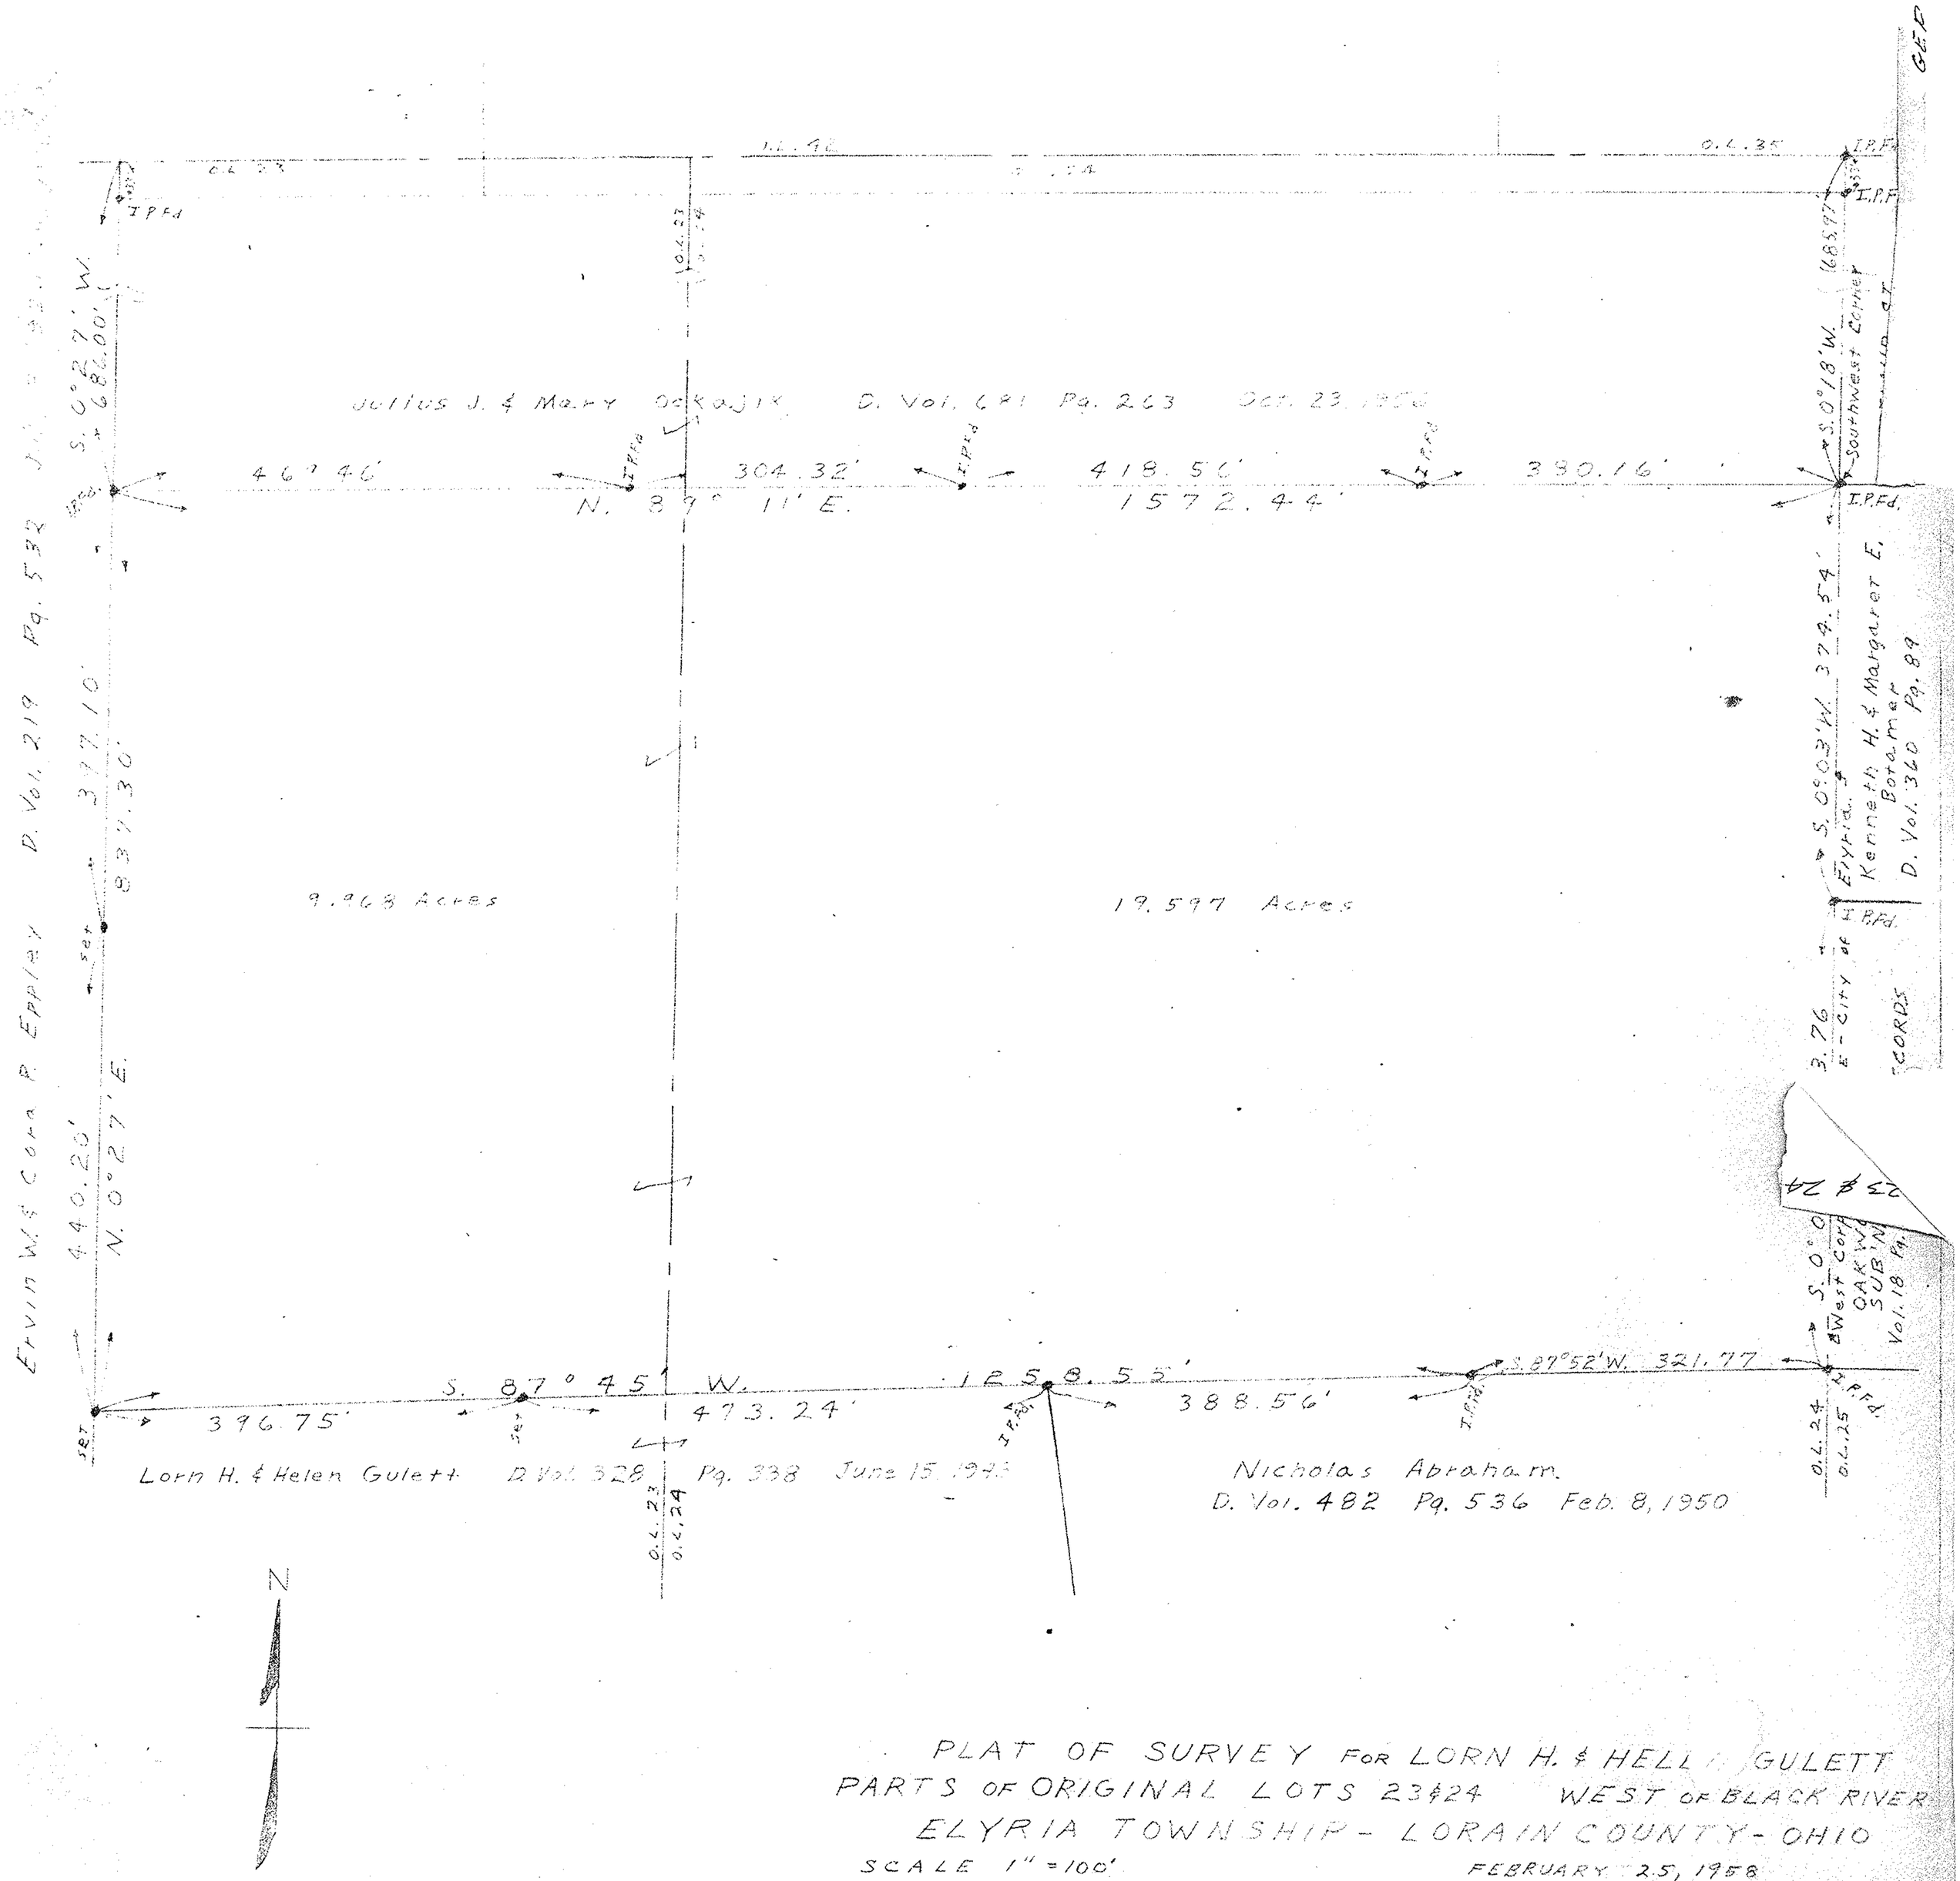

PLAT OF SURVEY FOR LORN H. & HELEN GULETT
PARTS OF ORIGINAL LOTS 23 & 24 WEST OF BLACK RIVER
ELYRIA TOWNSHIP - LORAIN COUNTY - OHIO

SCALE 1" = 100' FEBRUARY 25, 1958

Gary E. Penfound Registered Surveyor

NOTE: Iron pins found or set shown thus: •