PLAT OF SURVEY FOR
ROBERT GLAVER, INC.
1.6774 ACRES IN ORIGINAL LOT 3A, WEST OF
BLACK RIVER, IN ELYRIA TWP. & ELYRIA CITY
LORAIN COUNTY OHIO
SCALE: 1" = 20' APRIL 9 - 1962
Gary E. Penfound Reg. Surveyor No. 4457
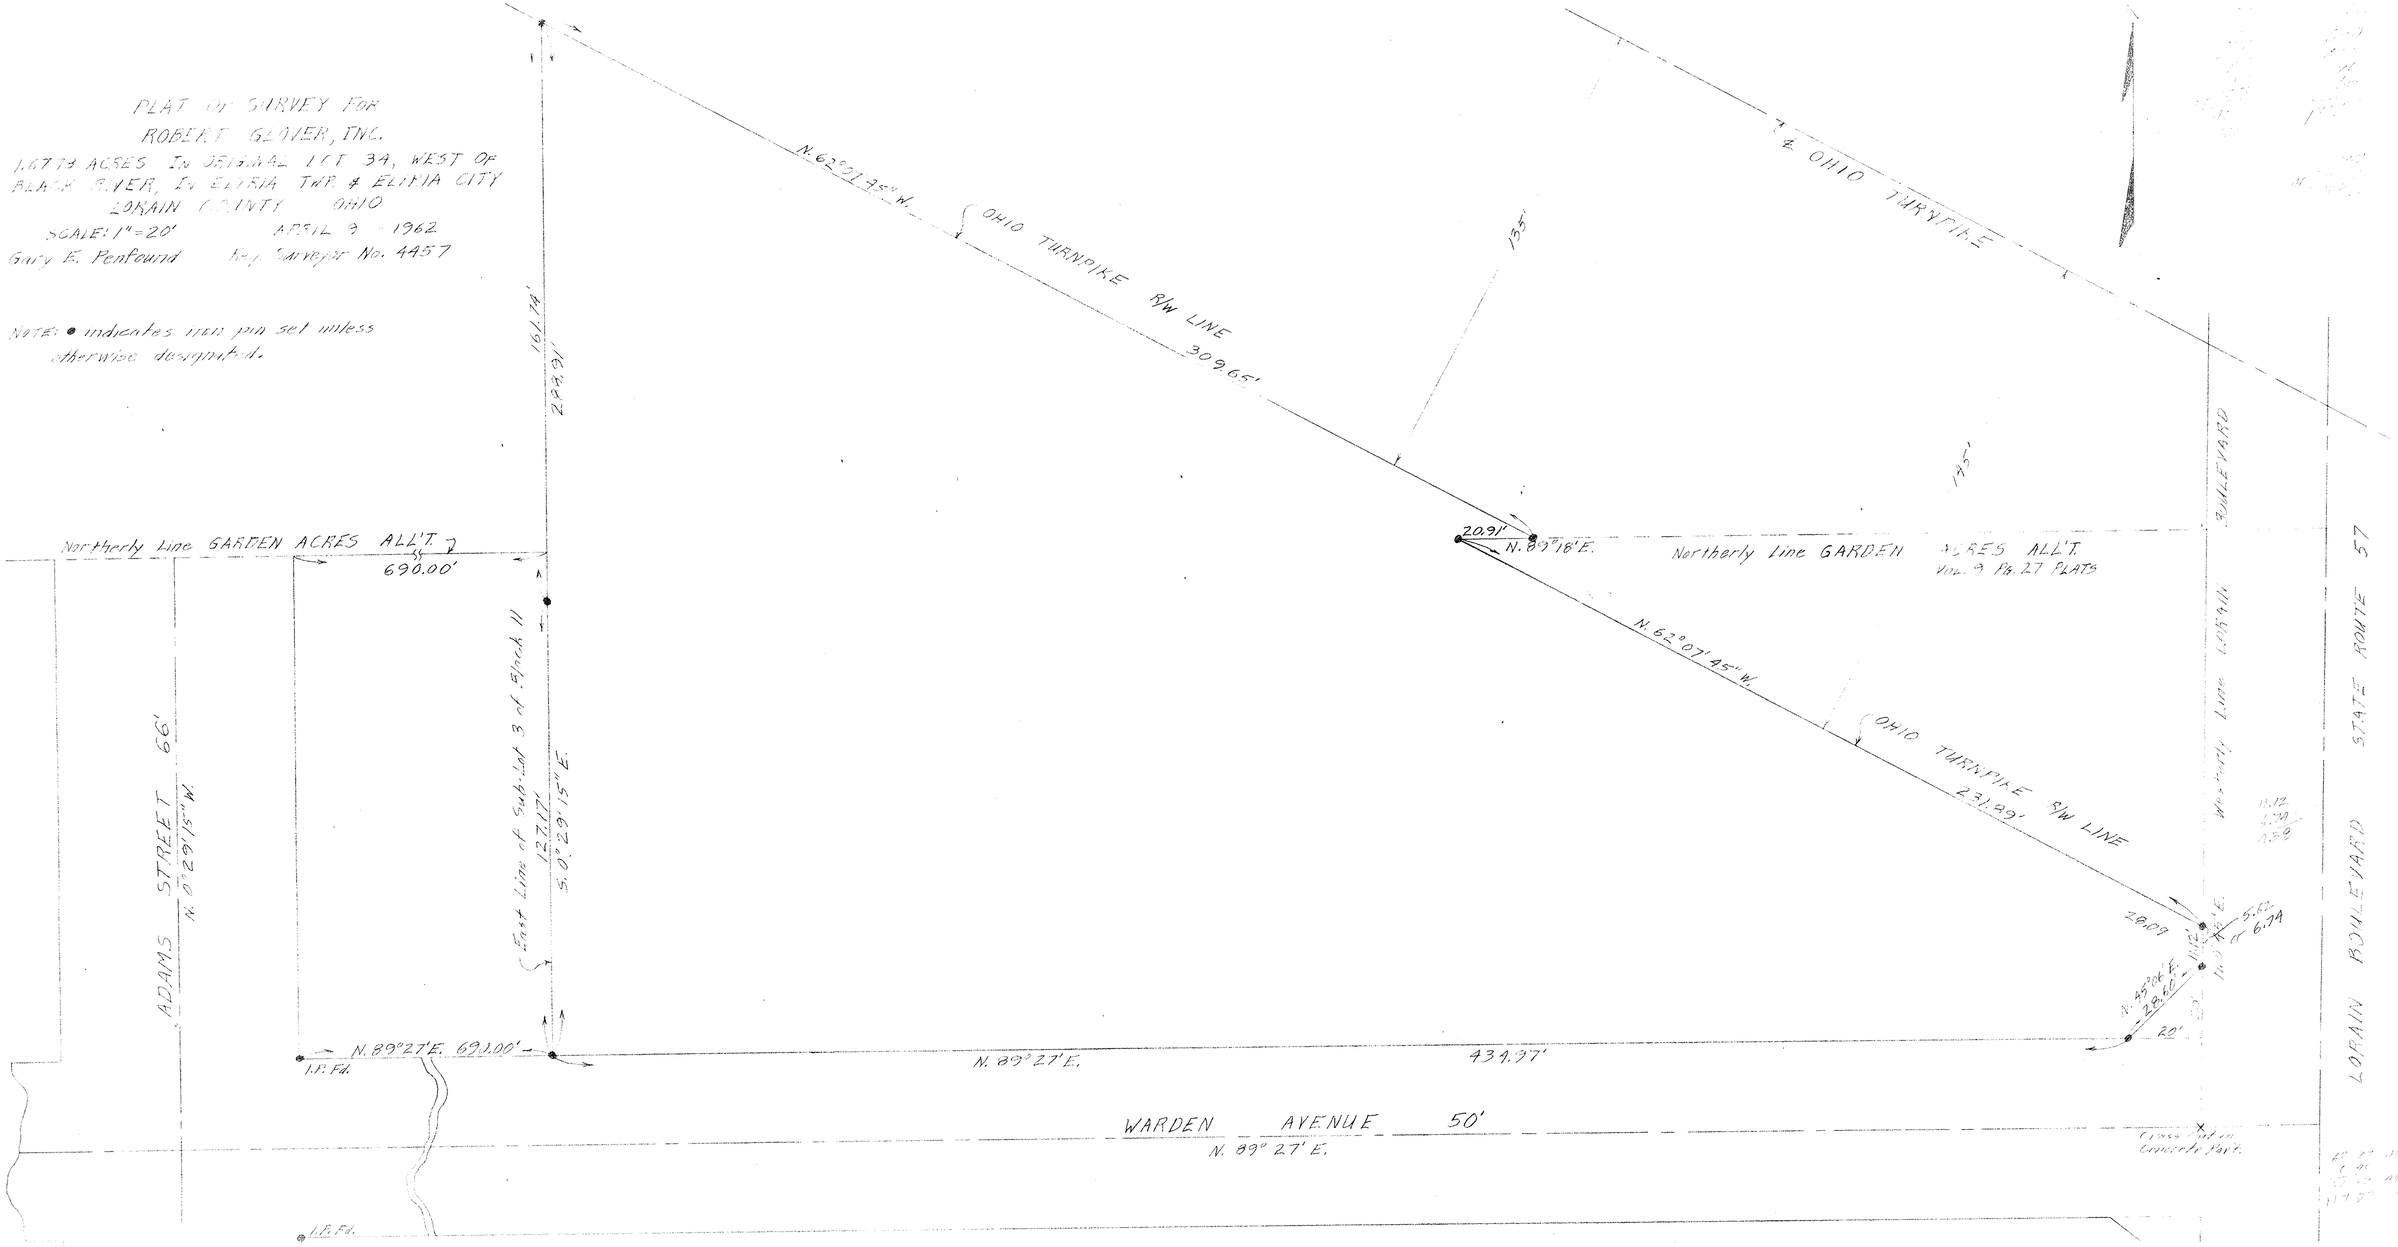
NOTE: ● indicates iron pin set unless otherwise designated.