Survey for

LOUIS M^gu TREVA MENNELL

D-Vol 567 Pg 307 April 11 1953

D-Vol 569 Pg 501 April 16. 1953

Part of Lot 66 East of East Branch of Black River

Elyria Twp. Elyria City Lorain County Ohio.

Scale 1" = 20' July 1. 1957.

J. W. Wardell & Associates Reg. Surveyor's.

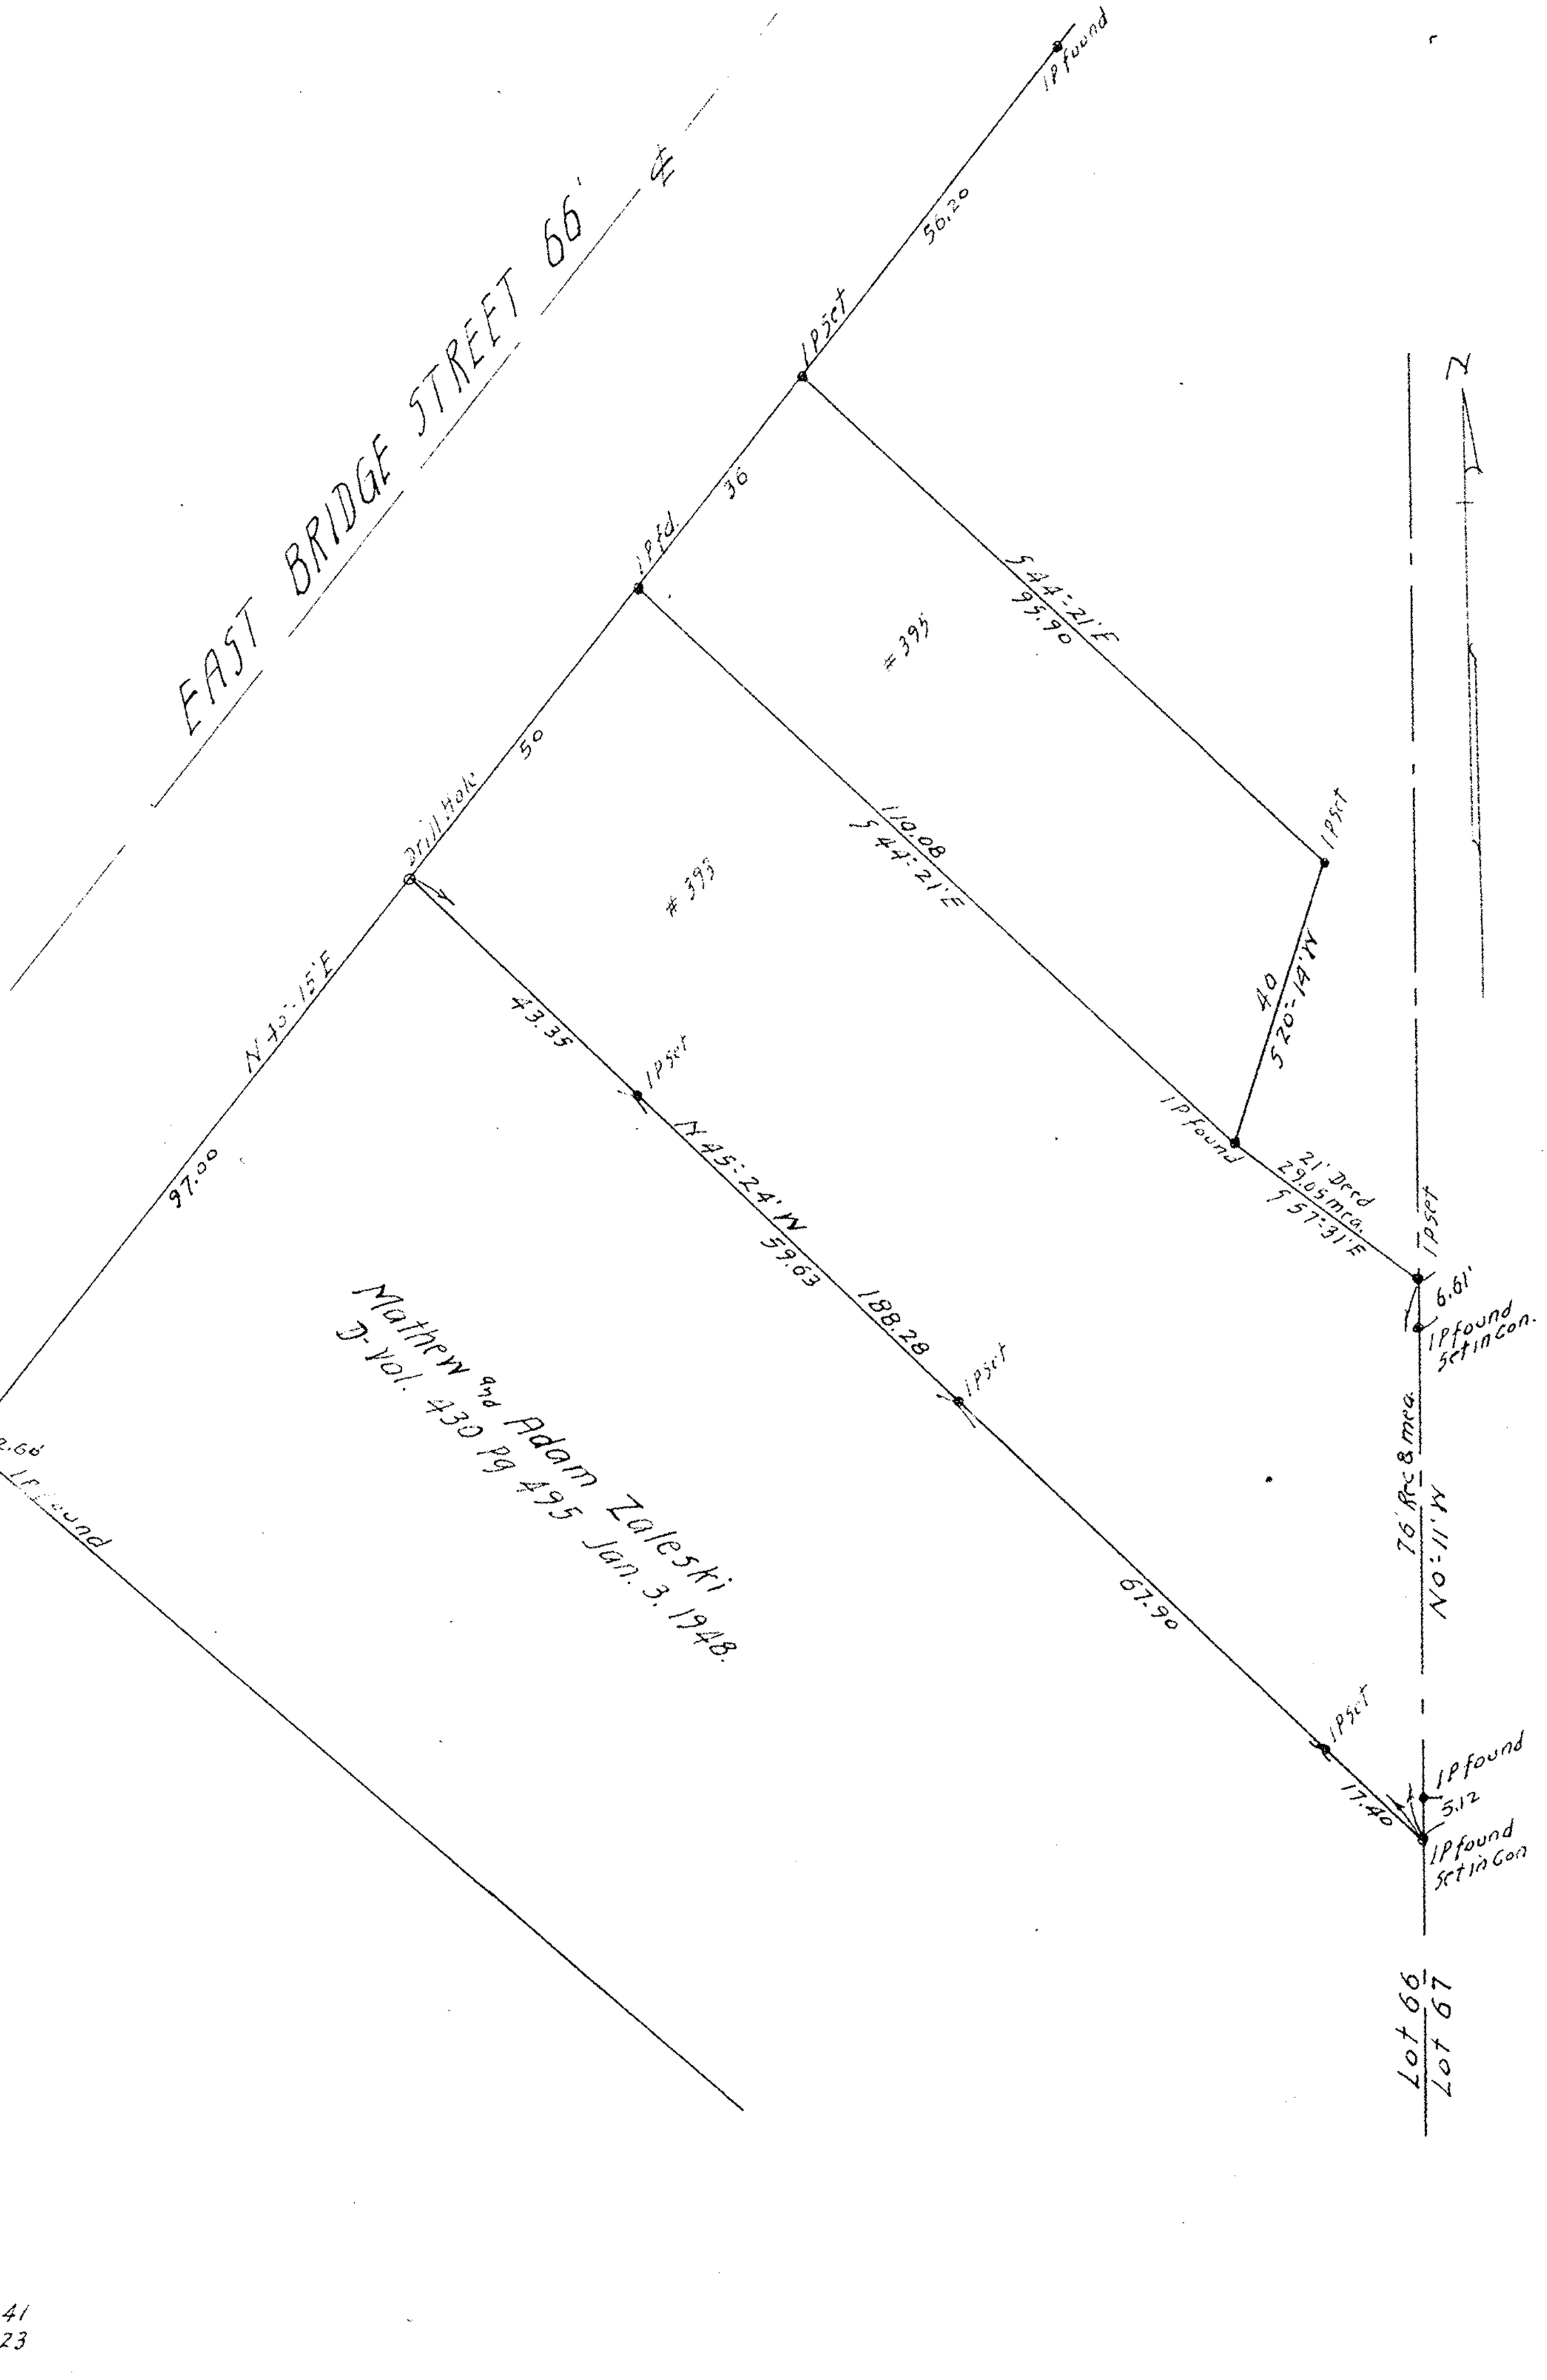

FB 11-41
FB 17-23