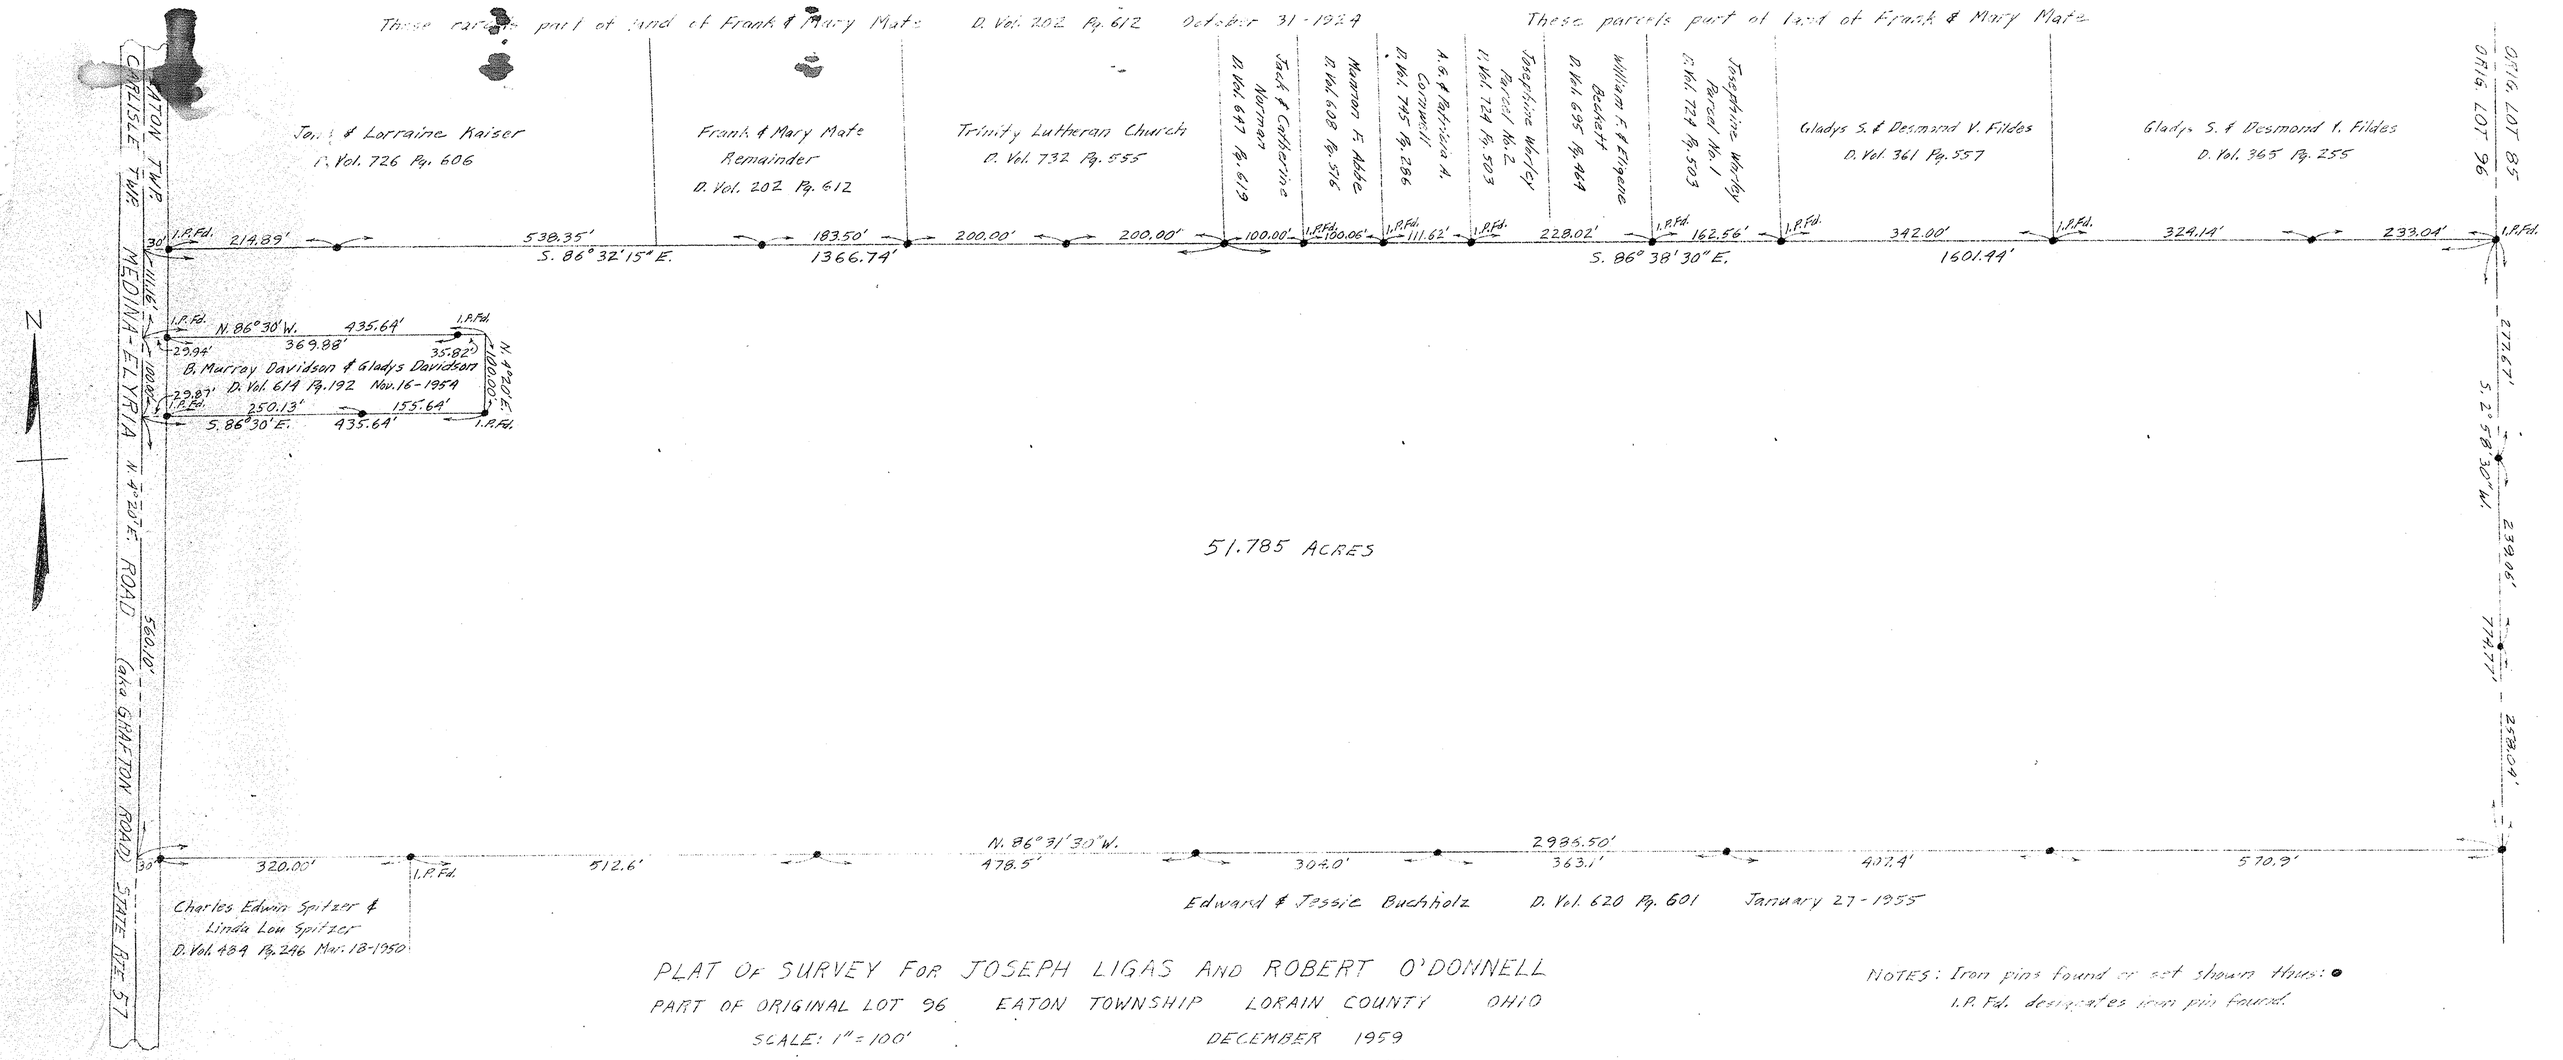

PLAT OF SURVEY FOR JOSEPH LIGAS AND ROBERT O'DONNELL

PART OF ORIGINAL LOT 96 EATON TOWNSHIP LORAIN COUNTY OHIO

SCALE: 1" = 100' DECEMBER 1959

GARY E. PENFOUND REGISTERED SURVEYOR NO. 4457

See Field Book 16 - Pages 8 & 9

NOTES: Iron pins found or set shown thus: ●

I.P. Fd. designates iron pin found.