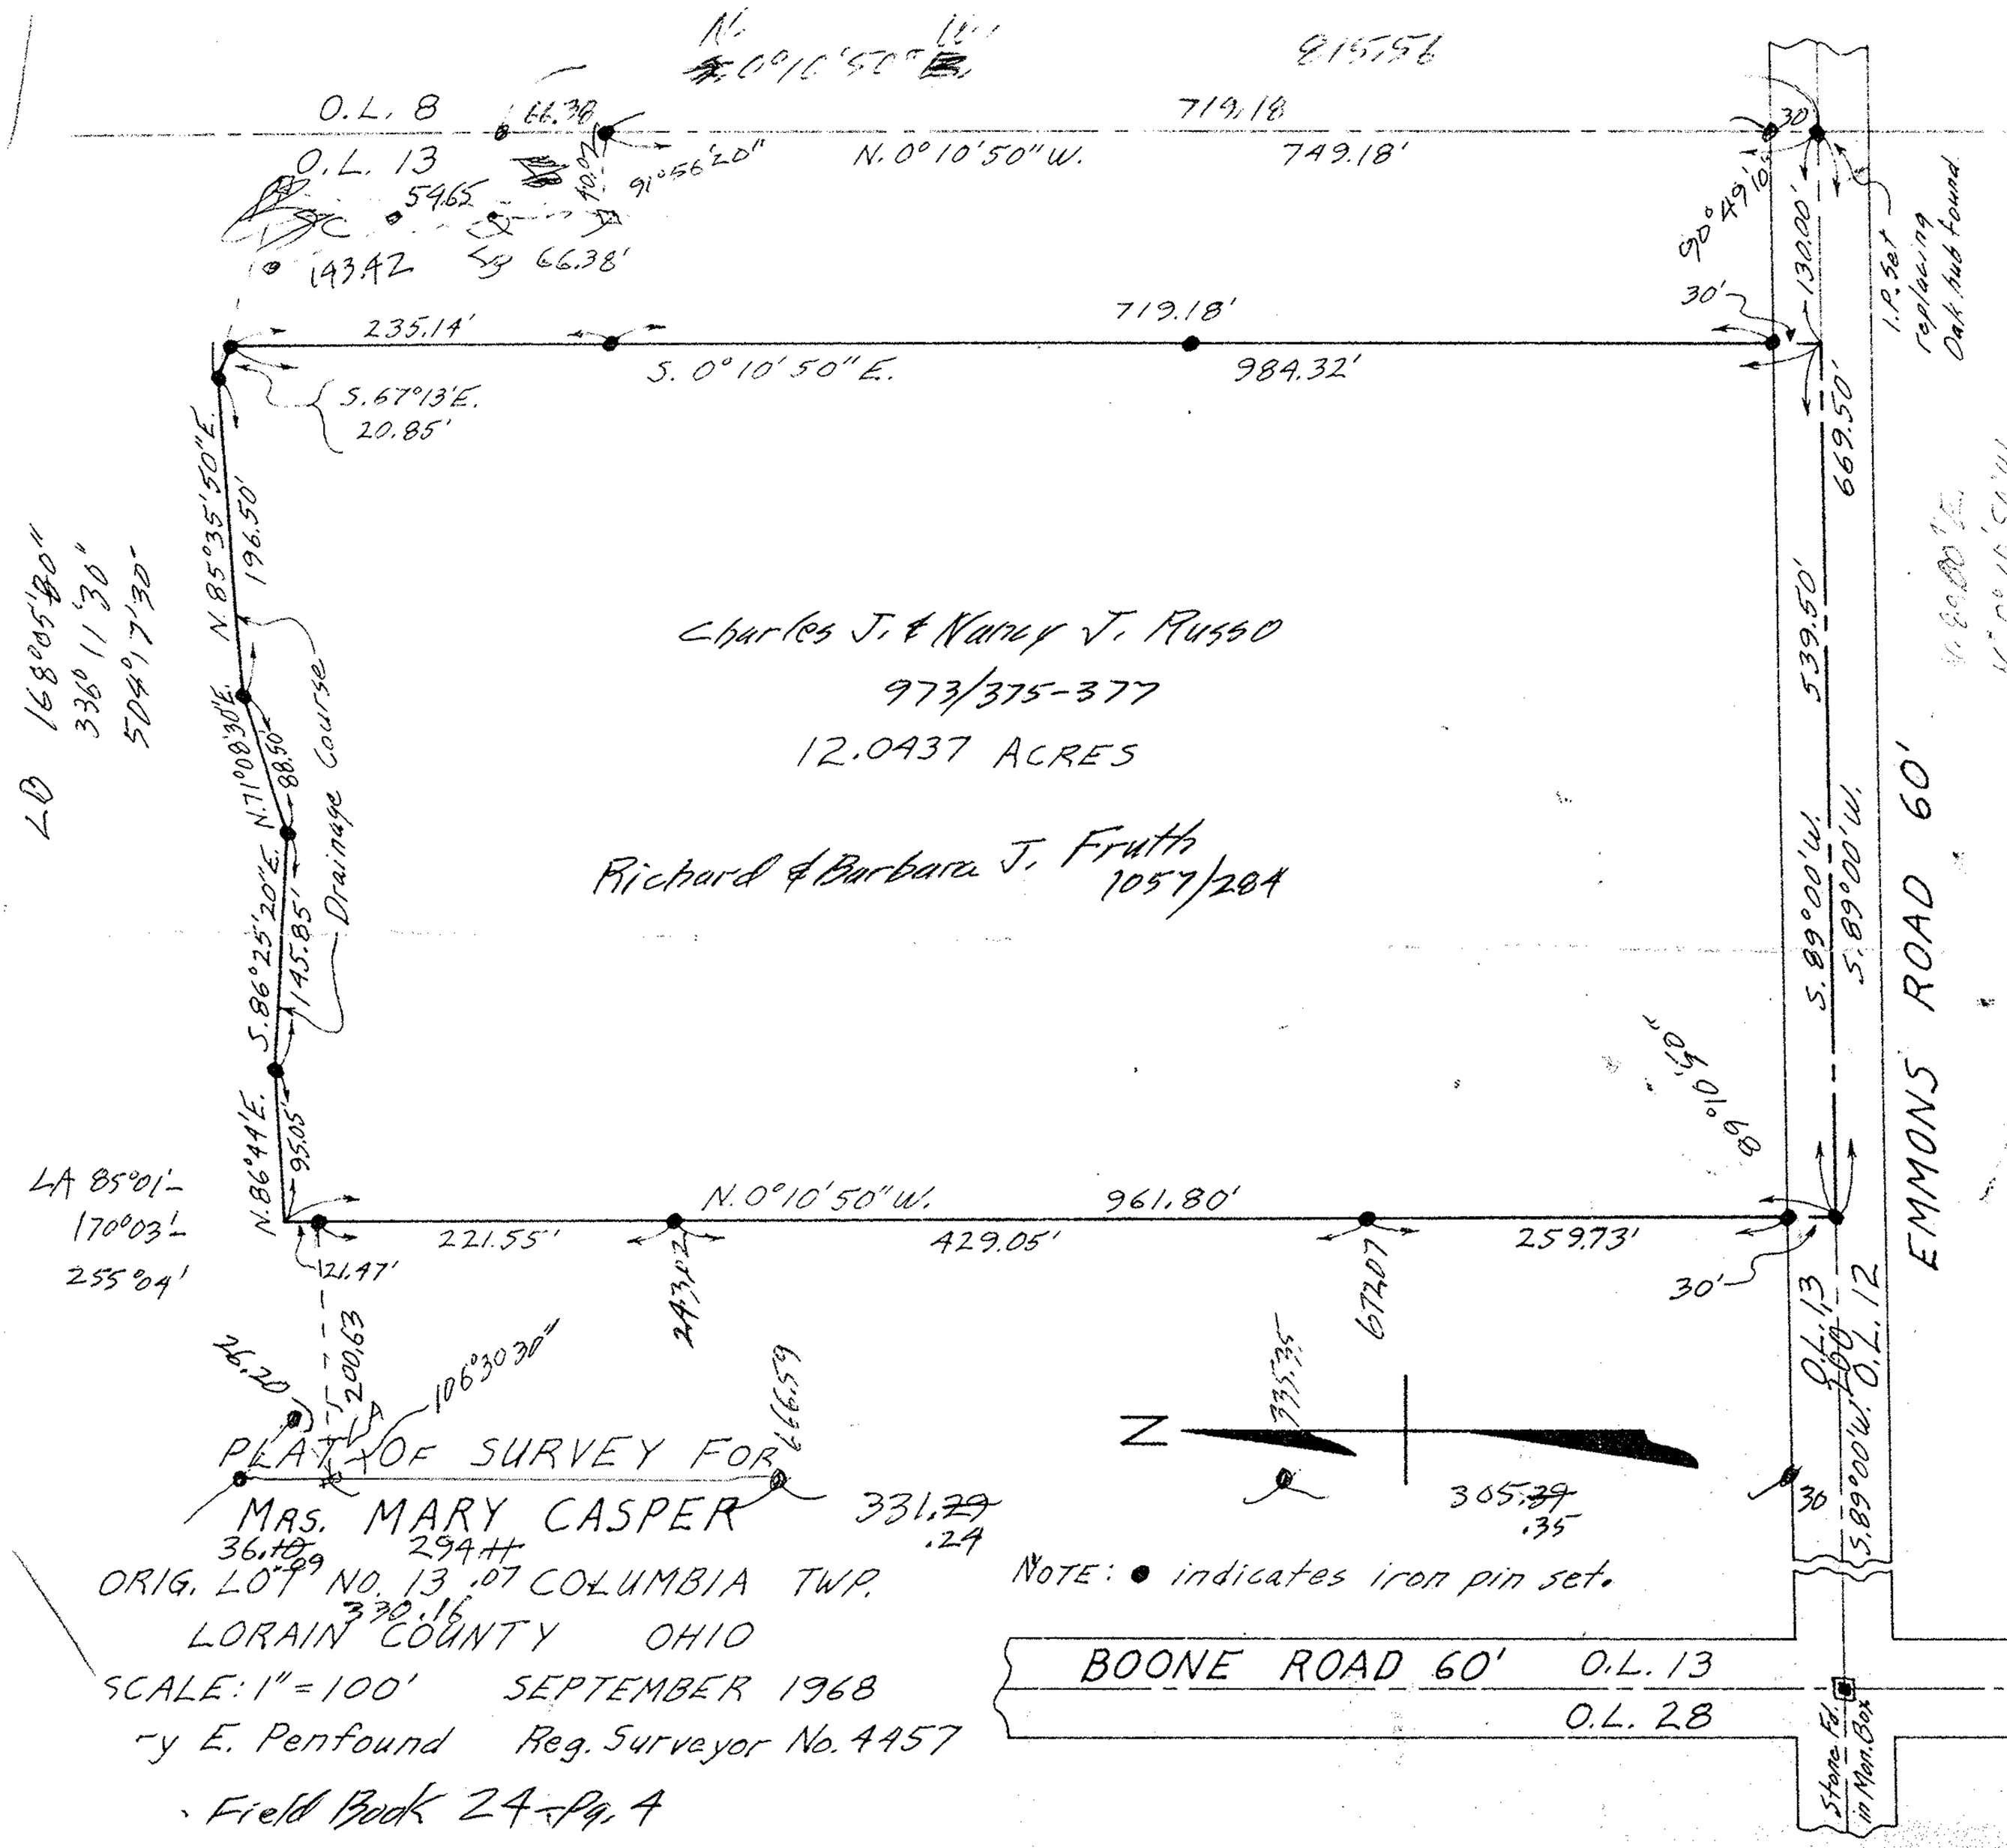
N. 0°10'50" W.
O.L. 8
O.L. 13
66.38
91°56'20"
N. 0°10'50" W.
749.18'
719.18
30
90°49'
130.00'
30'
I.P. Set replacing Oak Sub Found
143.42
66.38'
235.14'
719.18'
S. 0°10'50" E.
984.32'
S. 67°13' E.
20.85'
669.50'
539.50'
S. 89°00' W.
EMMONS ROAD 60'
N. 85°35'50" E.
196.50'
LB 168°05'80"
336°11'30"
504°7'30"
Charles J. & Nancy J. Russo
973/375-377
12.0437 ACRES
Richard & Barbara J. Fruth
1057/284
N. 71°08'30" E.
88.50'
Drainage Course
S. 86°25'20" E.
145.85'
N. 86°44' E.
95.05'
LA 85°01'
170°03'
255°04'
N. 0°10'50" W.
961.80'
221.55'
429.05'
259.73'
121.47'
30'
O.L. 13
O.L. 12
26.20
200.63
106°30'30"
243.22
672.07
335.35
Z
305.29
.35
331.29
.24
36.10
.99
294.11
.07
330.16
PLAT OF SURVEY FOR
MRS. MARY CASPER
ORIG. LOT NO. 13 COLUMBIA TWP.
LORAIN COUNTY OHIO
SCALE: 1" = 100' SEPTEMBER 1968
-y E. Penfound Reg. Surveyor No. 4457
Field Book 24-Pg. 4
NOTE: ● indicates iron pin set.
BOONE ROAD 60'
O.L. 13
O.L. 28
Stone Fd. in Mon. Box