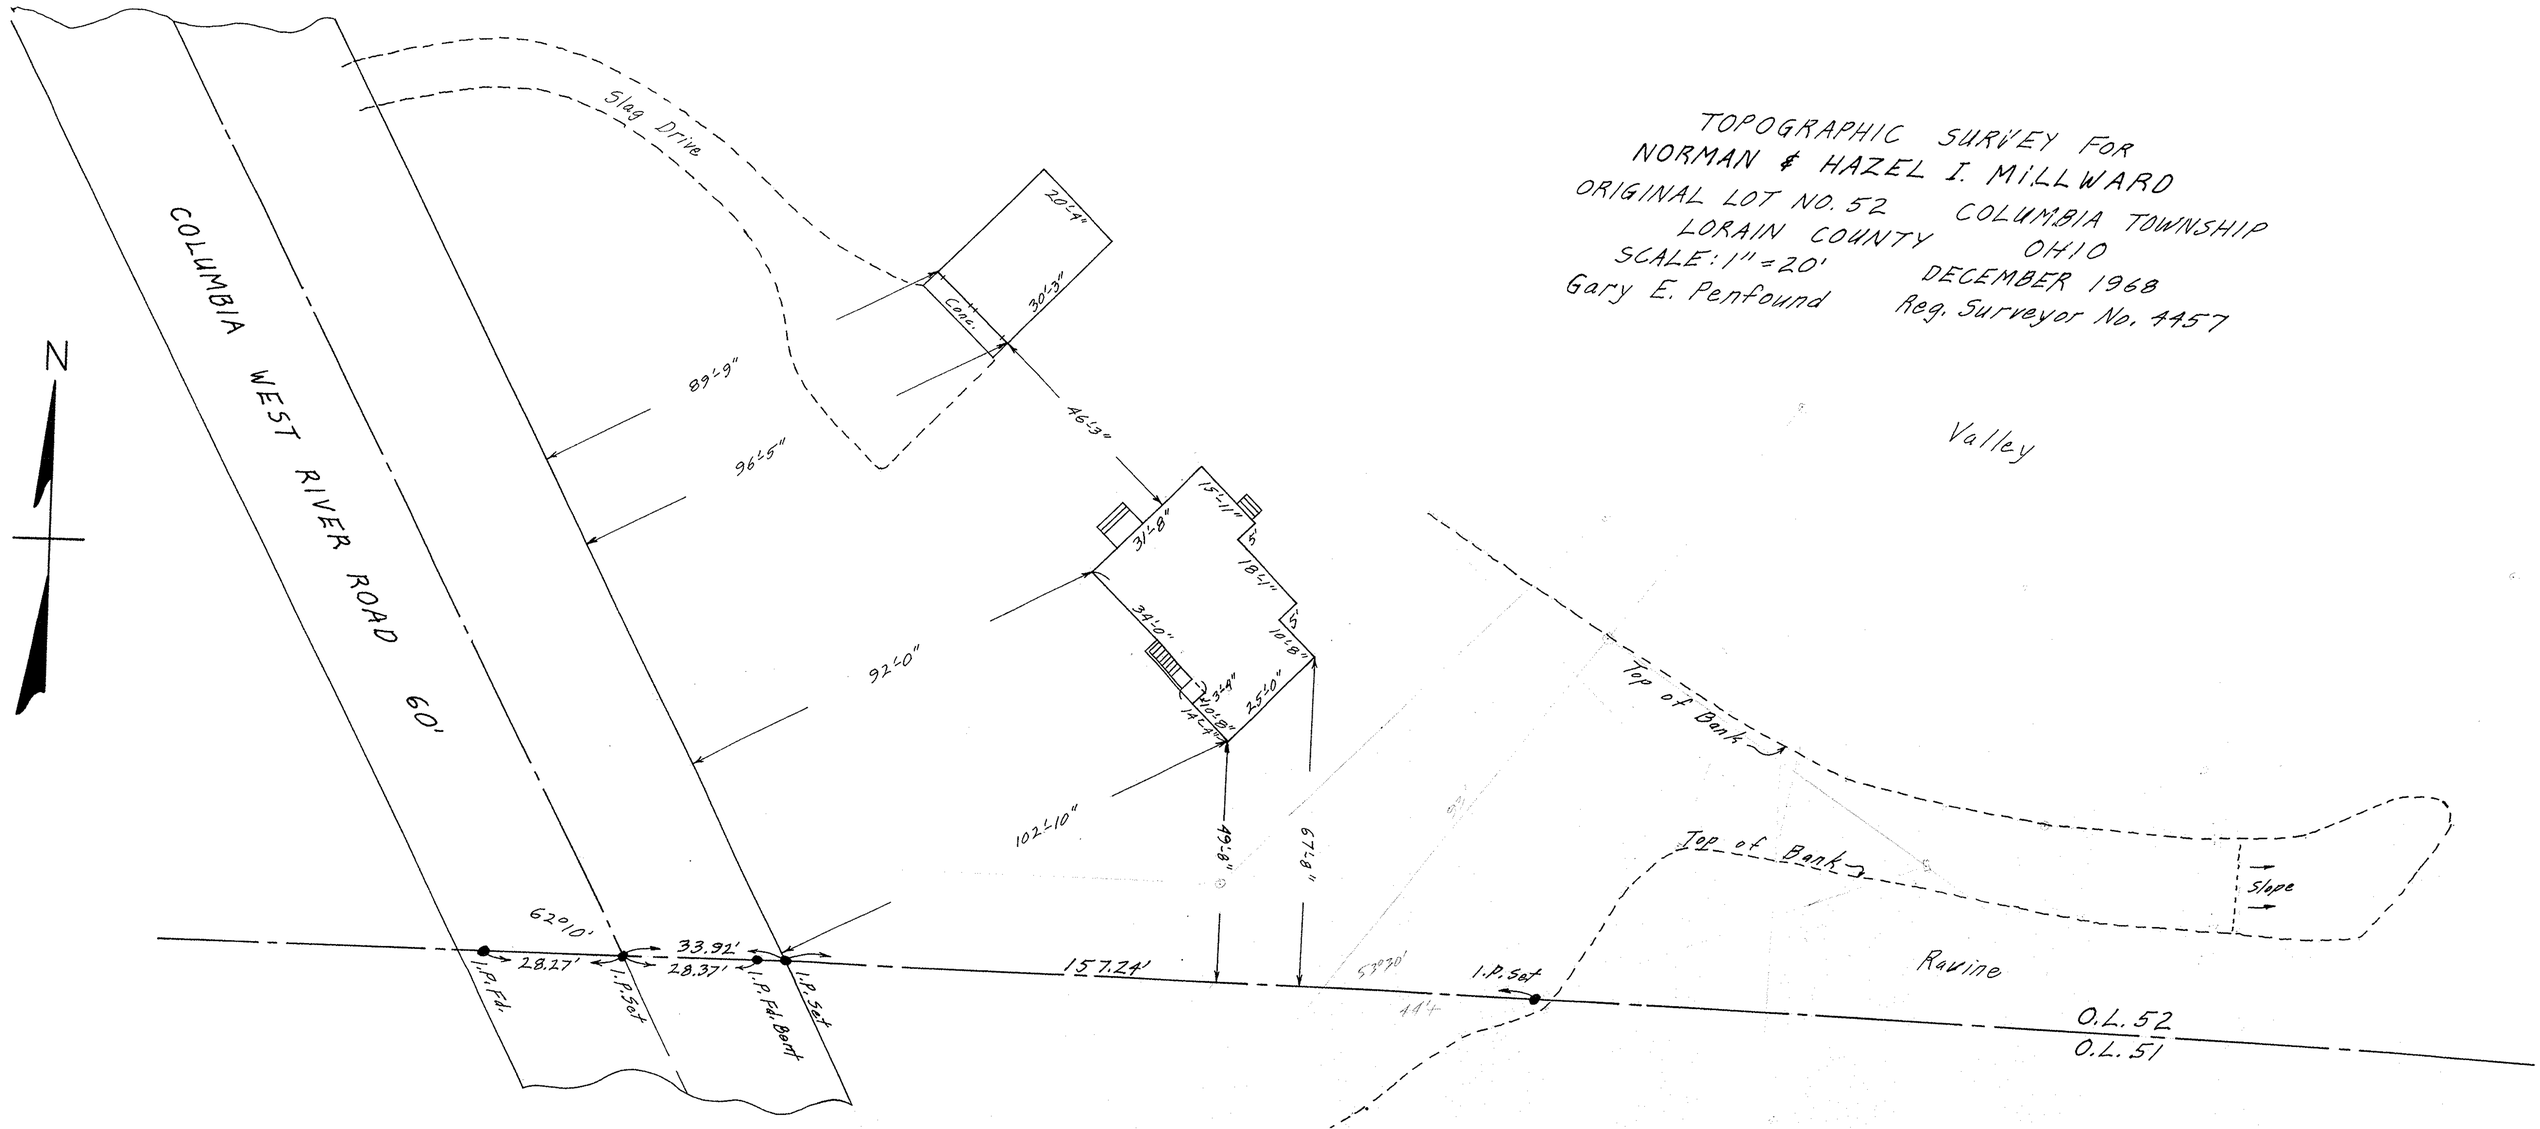TOPOGRAPHIC SURVEY FOR
NORMAN & HAZEL I. MILLWARD
ORIGINAL LOT NO. 52 COLUMBIA TOWNSHIP
LORAIN COUNTY OHIO
SCALE: 1" = 20' DECEMBER 1968
Gary E. Penfound Reg. Surveyor No. 4457