TOPOGRAPHIC SURVEY FOR
NORMAN & HAZEL I. MILLWARD

ORIGINAL LOT NO. 52 COLUMBIA TOWNSHIP
LORAIN COUNTY OHIO
SCALE: 1" = 20' DECEMBER 1968 - FEBRUARY 1969
Gary E. Pentound Reg. Surveyor No. 4957

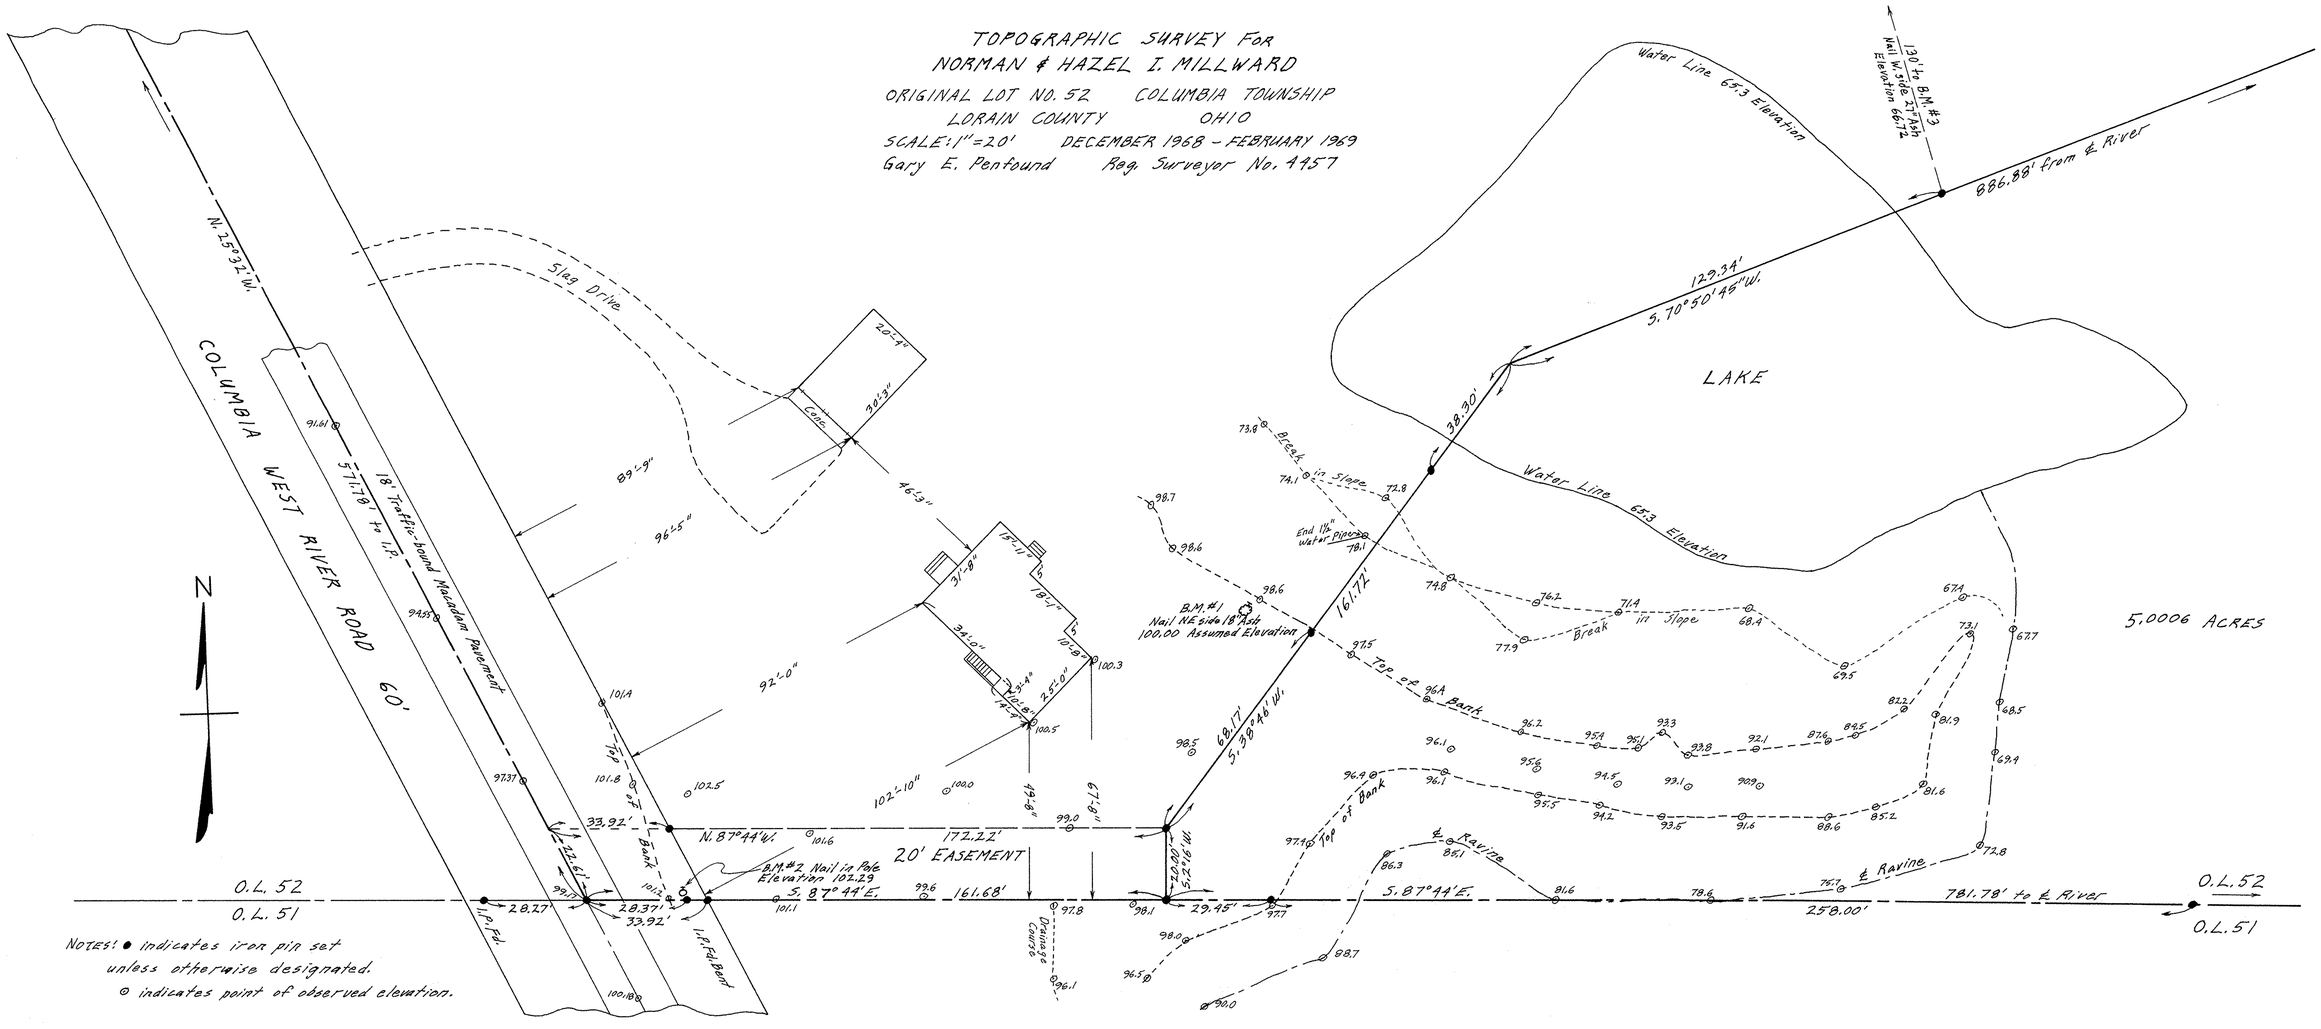

NOTES: ● indicates iron pin set unless otherwise designated.
⊙ indicates point of observed elevation.