ROBSON ROAD SUBDIVISION

PART OF SECTION NO. 6 CARLISLE TOWNSHIP
LORAIN COUNTY OHIO
SCALE: 1" = 50' JULY 1968
GARY E. PENFOUND REGISTERED SURVEYOR NO. 4457

SURVEYOR'S CERTIFICATE:
This is to certify that at the request of the owners I have surveyed and platted ROBSON ROAD SUBDIVISION as shown hereon. Distances are shown in feet and decimal parts thereof. • indicates iron pin monument set unless otherwise designated. Heavy black line indicates outline of Subdivision. This plat embraces 10.1635 Acres of land in Section No. 6 of Carlisle Township, of which 1.8082 Acres lie within the Right-of-Ways of Davis Street and Robson Road as shown and dedicated hereon.
All of which I certify to be correct.

Gary E. Penfound Registered Surveyor No. 4457

Transferred this _____ Day of _____, 19__. _____
Lorain County Auditor

Filed for Record this _____ Day of _____, 19__, at _____
Recorded this _____ Day of _____, 19__, in Plat Book _____ Page _____

_____
Lorain County Recorder

This plat of ROBSON ROAD SUBDIVISION is hereby approved by the Planning Commission of the City of Elyria on this _____ Day of _____, 1968.

President _____
Secretary _____

This plat of ROBSON ROAD SUBDIVISION is hereby approved for the installation of a Rural Residential Bituminous Street according to standards and specifications as established by the Lorain County Engineering Department.

Date: _____ _____ Lorain County Engineer

This plat of ROBSON ROAD SUBDIVISION is hereby accepted by the Board of Trustees of Carlisle Township, conditional with the installation of a Rural Residential Bituminous Street according to standards and specifications of the Lorain County Engineering Department.

_____ _____
_____ _____ Clerk

Date: _____

OWNERS' CERTIFICATE:
This is to certify that the undersigned Dave Davis and M. Evangeline Davis, as owners of the land included in this plat of ROBSON ROAD SUBDIVISION, do hereby accept this plat to be carried and dedicate to Public Use DAVIS STREET, and ROBSON ROAD to a width of 30 feet from centerline, as shown hereon.

State of Ohio
County of Lorain s.s.:
Before me, a Notary Public in and for said County and State, personally appeared the above named Dave Davis and M. Evangeline Davis, who acknowledged the signing of this plat to be their own free act and deed.
In witness whereof I have hereunto set my hand and official seal at _____, Ohio, on this _____ Day of _____, 1968.

_____ Notary Public
My Commission expires _____
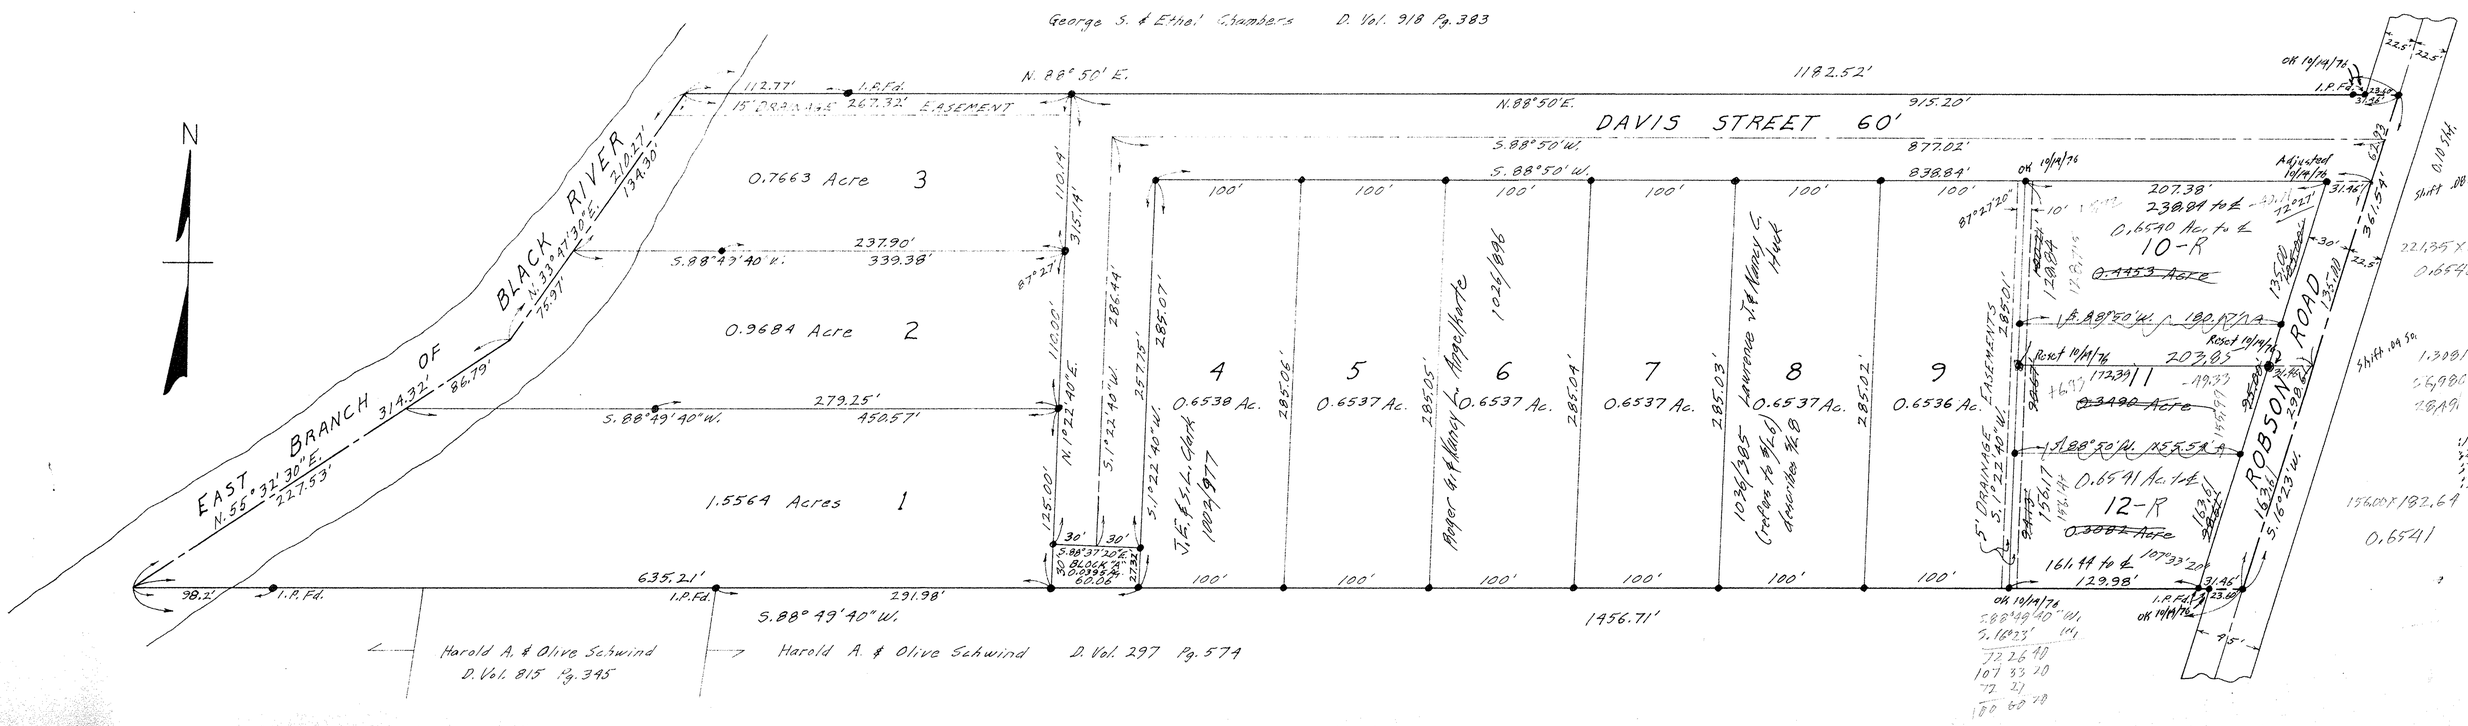
1002/977
1026/896
1036/305