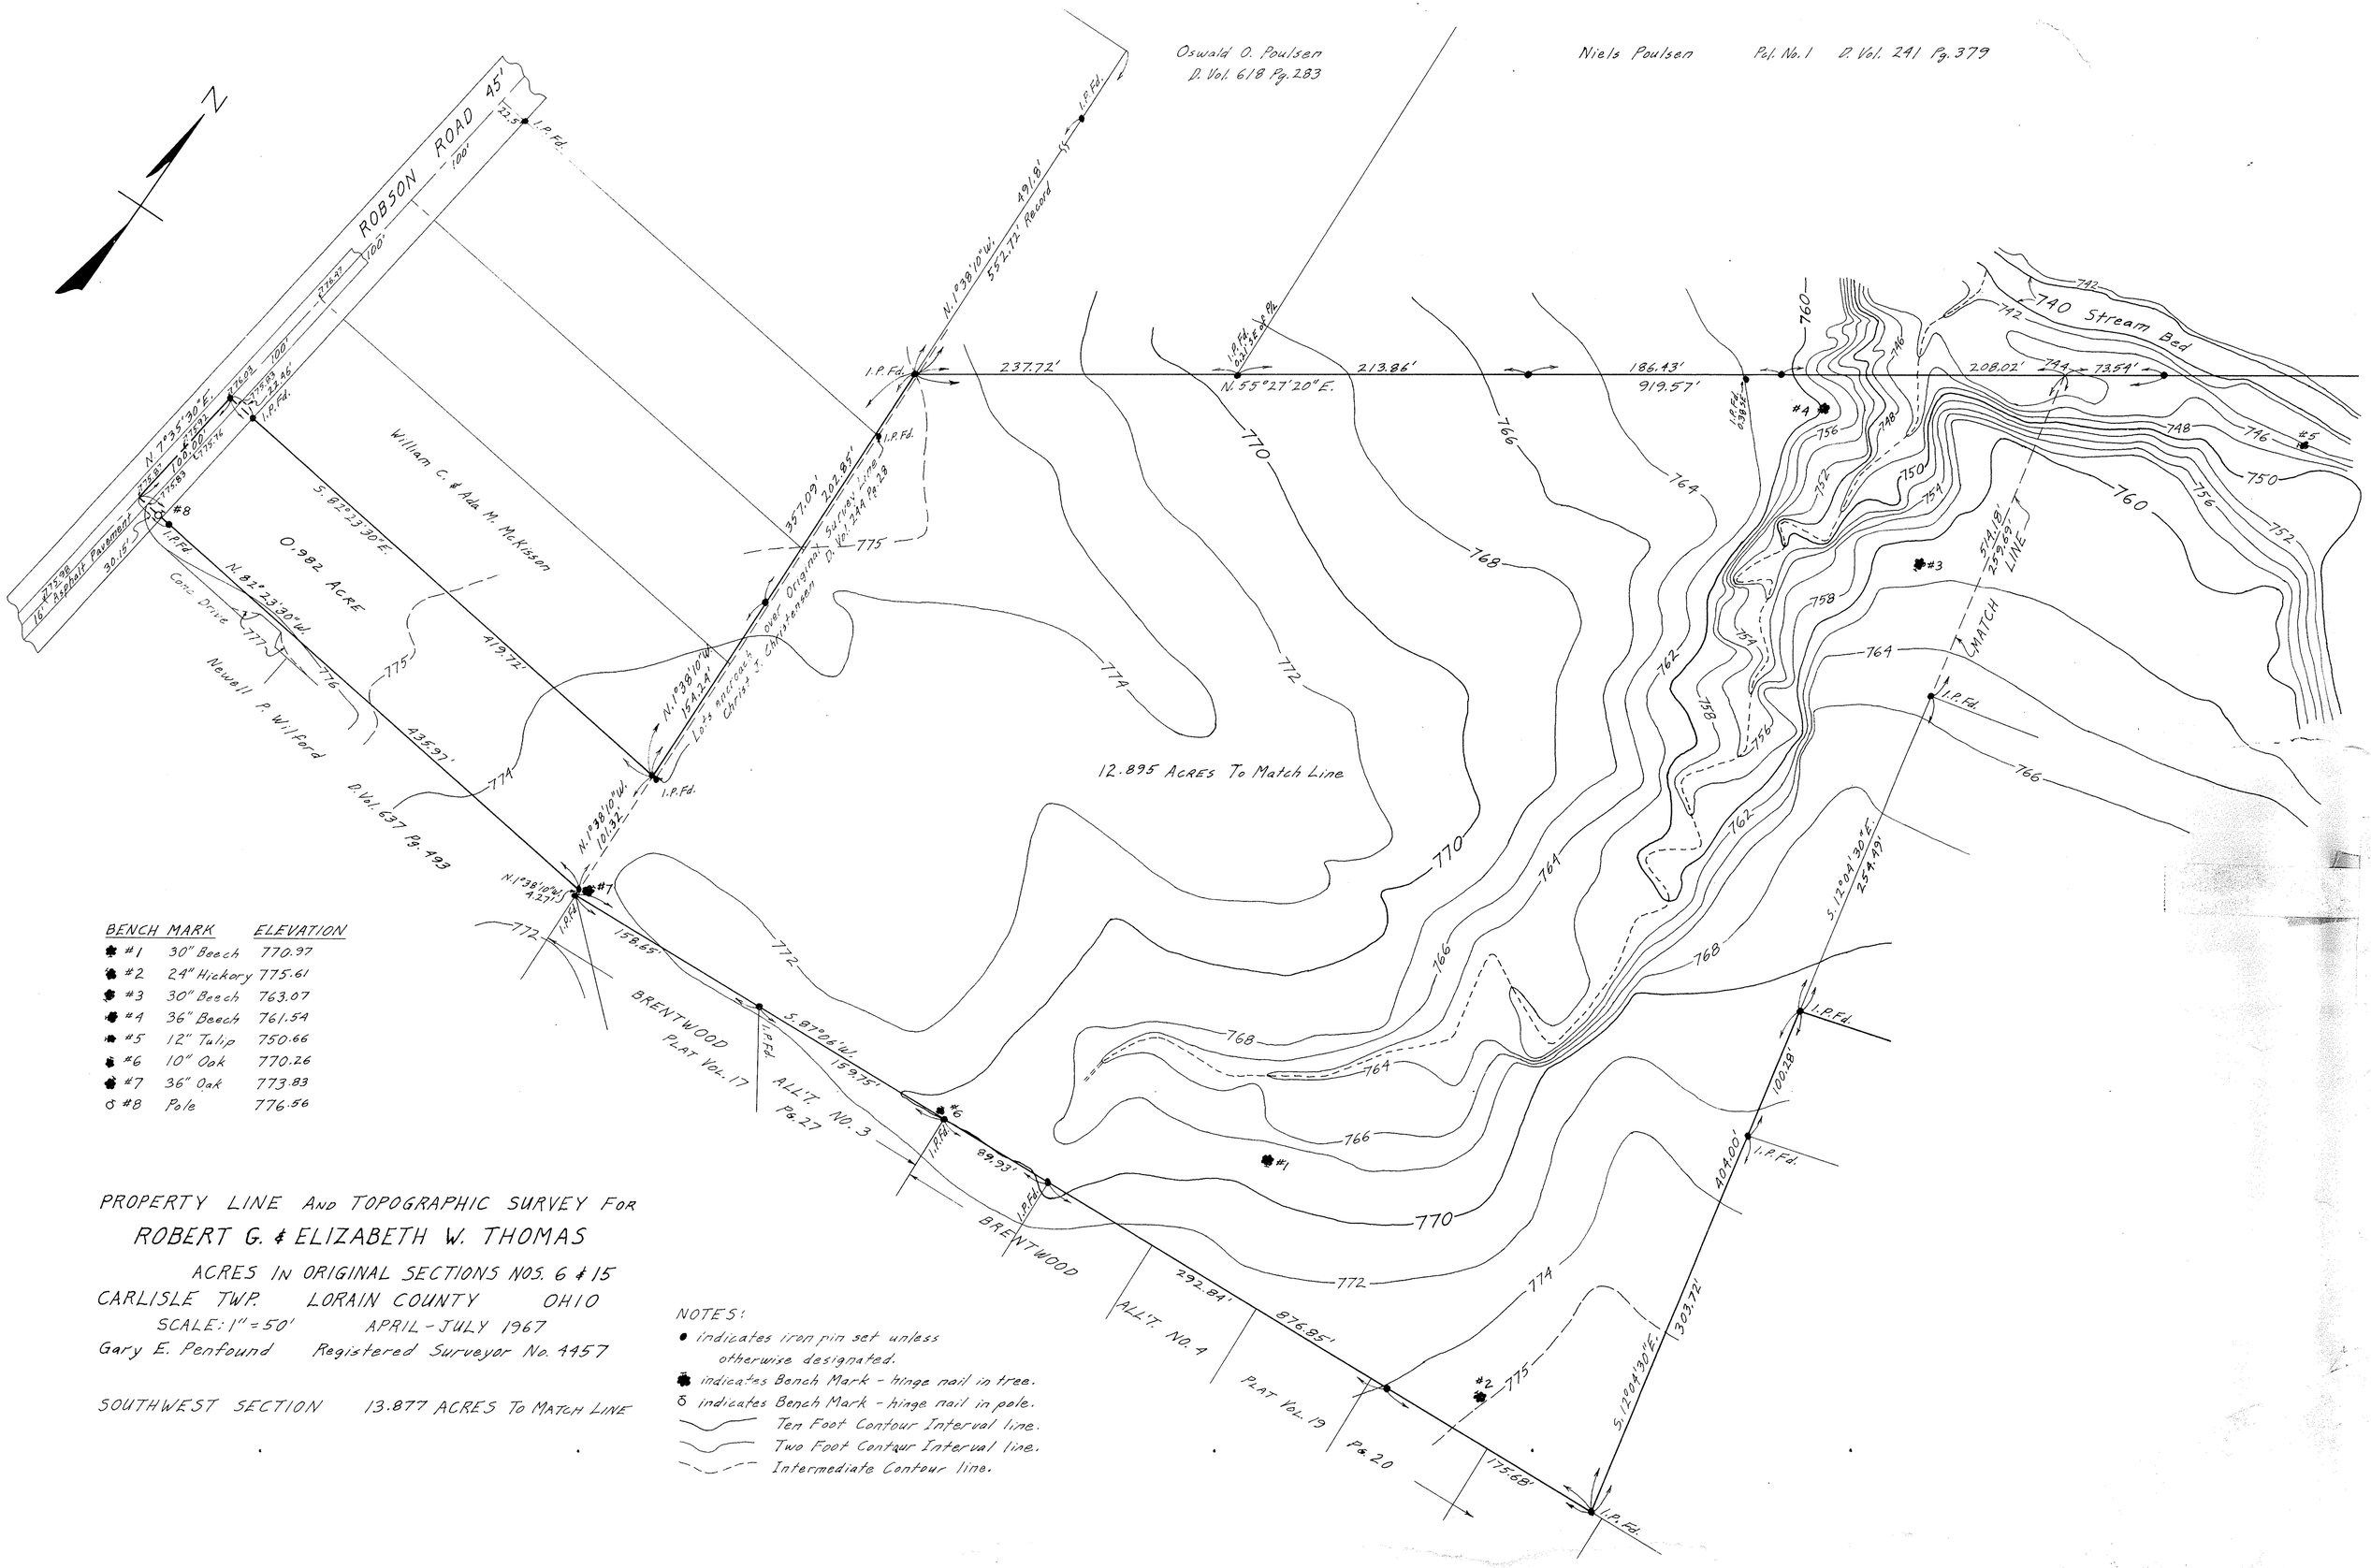

BENCH MARK		ELEVATION
#1	30" Beech	770.97
#2	24" Hickory	775.61
#3	30" Beech	763.07
#4	36" Beech	761.54
#5	12" Tulip	750.66
#6	10" Oak	770.26
#7	36" Oak	773.83
#8	Pole	776.56

PROPERTY LINE AND TOPOGRAPHIC SURVEY FOR

ROBERT G. & ELIZABETH W. THOMAS

ACRES IN ORIGINAL SECTIONS NOS. 6 & 15

CARLISLE TWP. LORAIN COUNTY OHIO

SCALE: 1" = 50' APRIL - JULY 1967

Gary E. Penfound Registered Surveyor No. 4457

SOUTHWEST SECTION 13.877 ACRES TO MATCH LINE

NOTES:

- ● indicates iron pin set unless otherwise designated.
- ✱ indicates Bench Mark - hinge nail in tree.
- ♂ indicates Bench Mark - hinge nail in pole.
- Ten Foot Contour Interval line.
- Two Foot Contour Interval line.
- Intermediate Contour line.