

SCHWARTZ ROAD  
Now 60' by Court Order

SCHWARTZ ROAD 60' by Court Order

Cont. Part, -  
Could not set RRS

Notes: 0 indicates iron pin found or set  
previous surveys.  
• indicates iron pin set unless  
otherwise  
designated.



PLAT OF SURVEYS FOR  
THE ESTATE OF MARY A. KLINGSHIRN  
ORIGINAL SECTION NO. 26 - AVON TWP. & CITY  
LORAIN COUNTY OHIO  
SCALE: 1" = 100'  
JULY - 1975  
Gary E. Penfound Reg. Surveyor No. 4457


LEAR - NAGLE ROAD 60'

SECTION 23  
SECTION 26

About 50.188 ACRES  
Remaining in Estate

GRAPE VINEYARD  
10.0556 ACRES

See Field Book 29-19-10

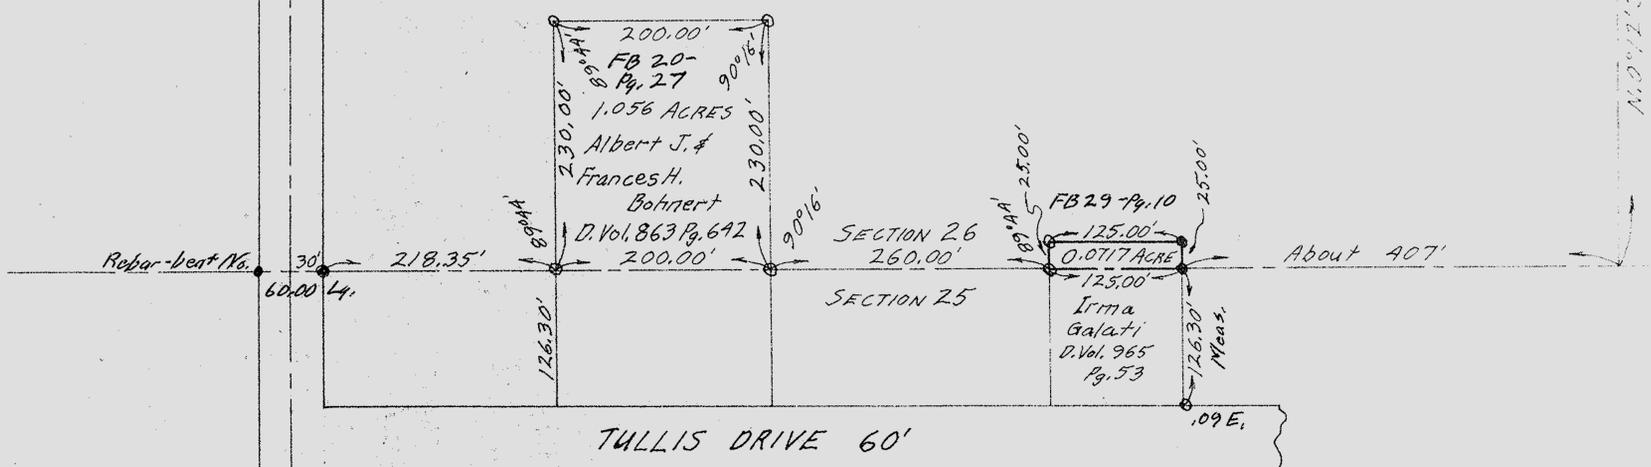

NOTE: Bearings used on TULLIS DRIVE Surveys do not correspond with SCHWARTZ ROAD.