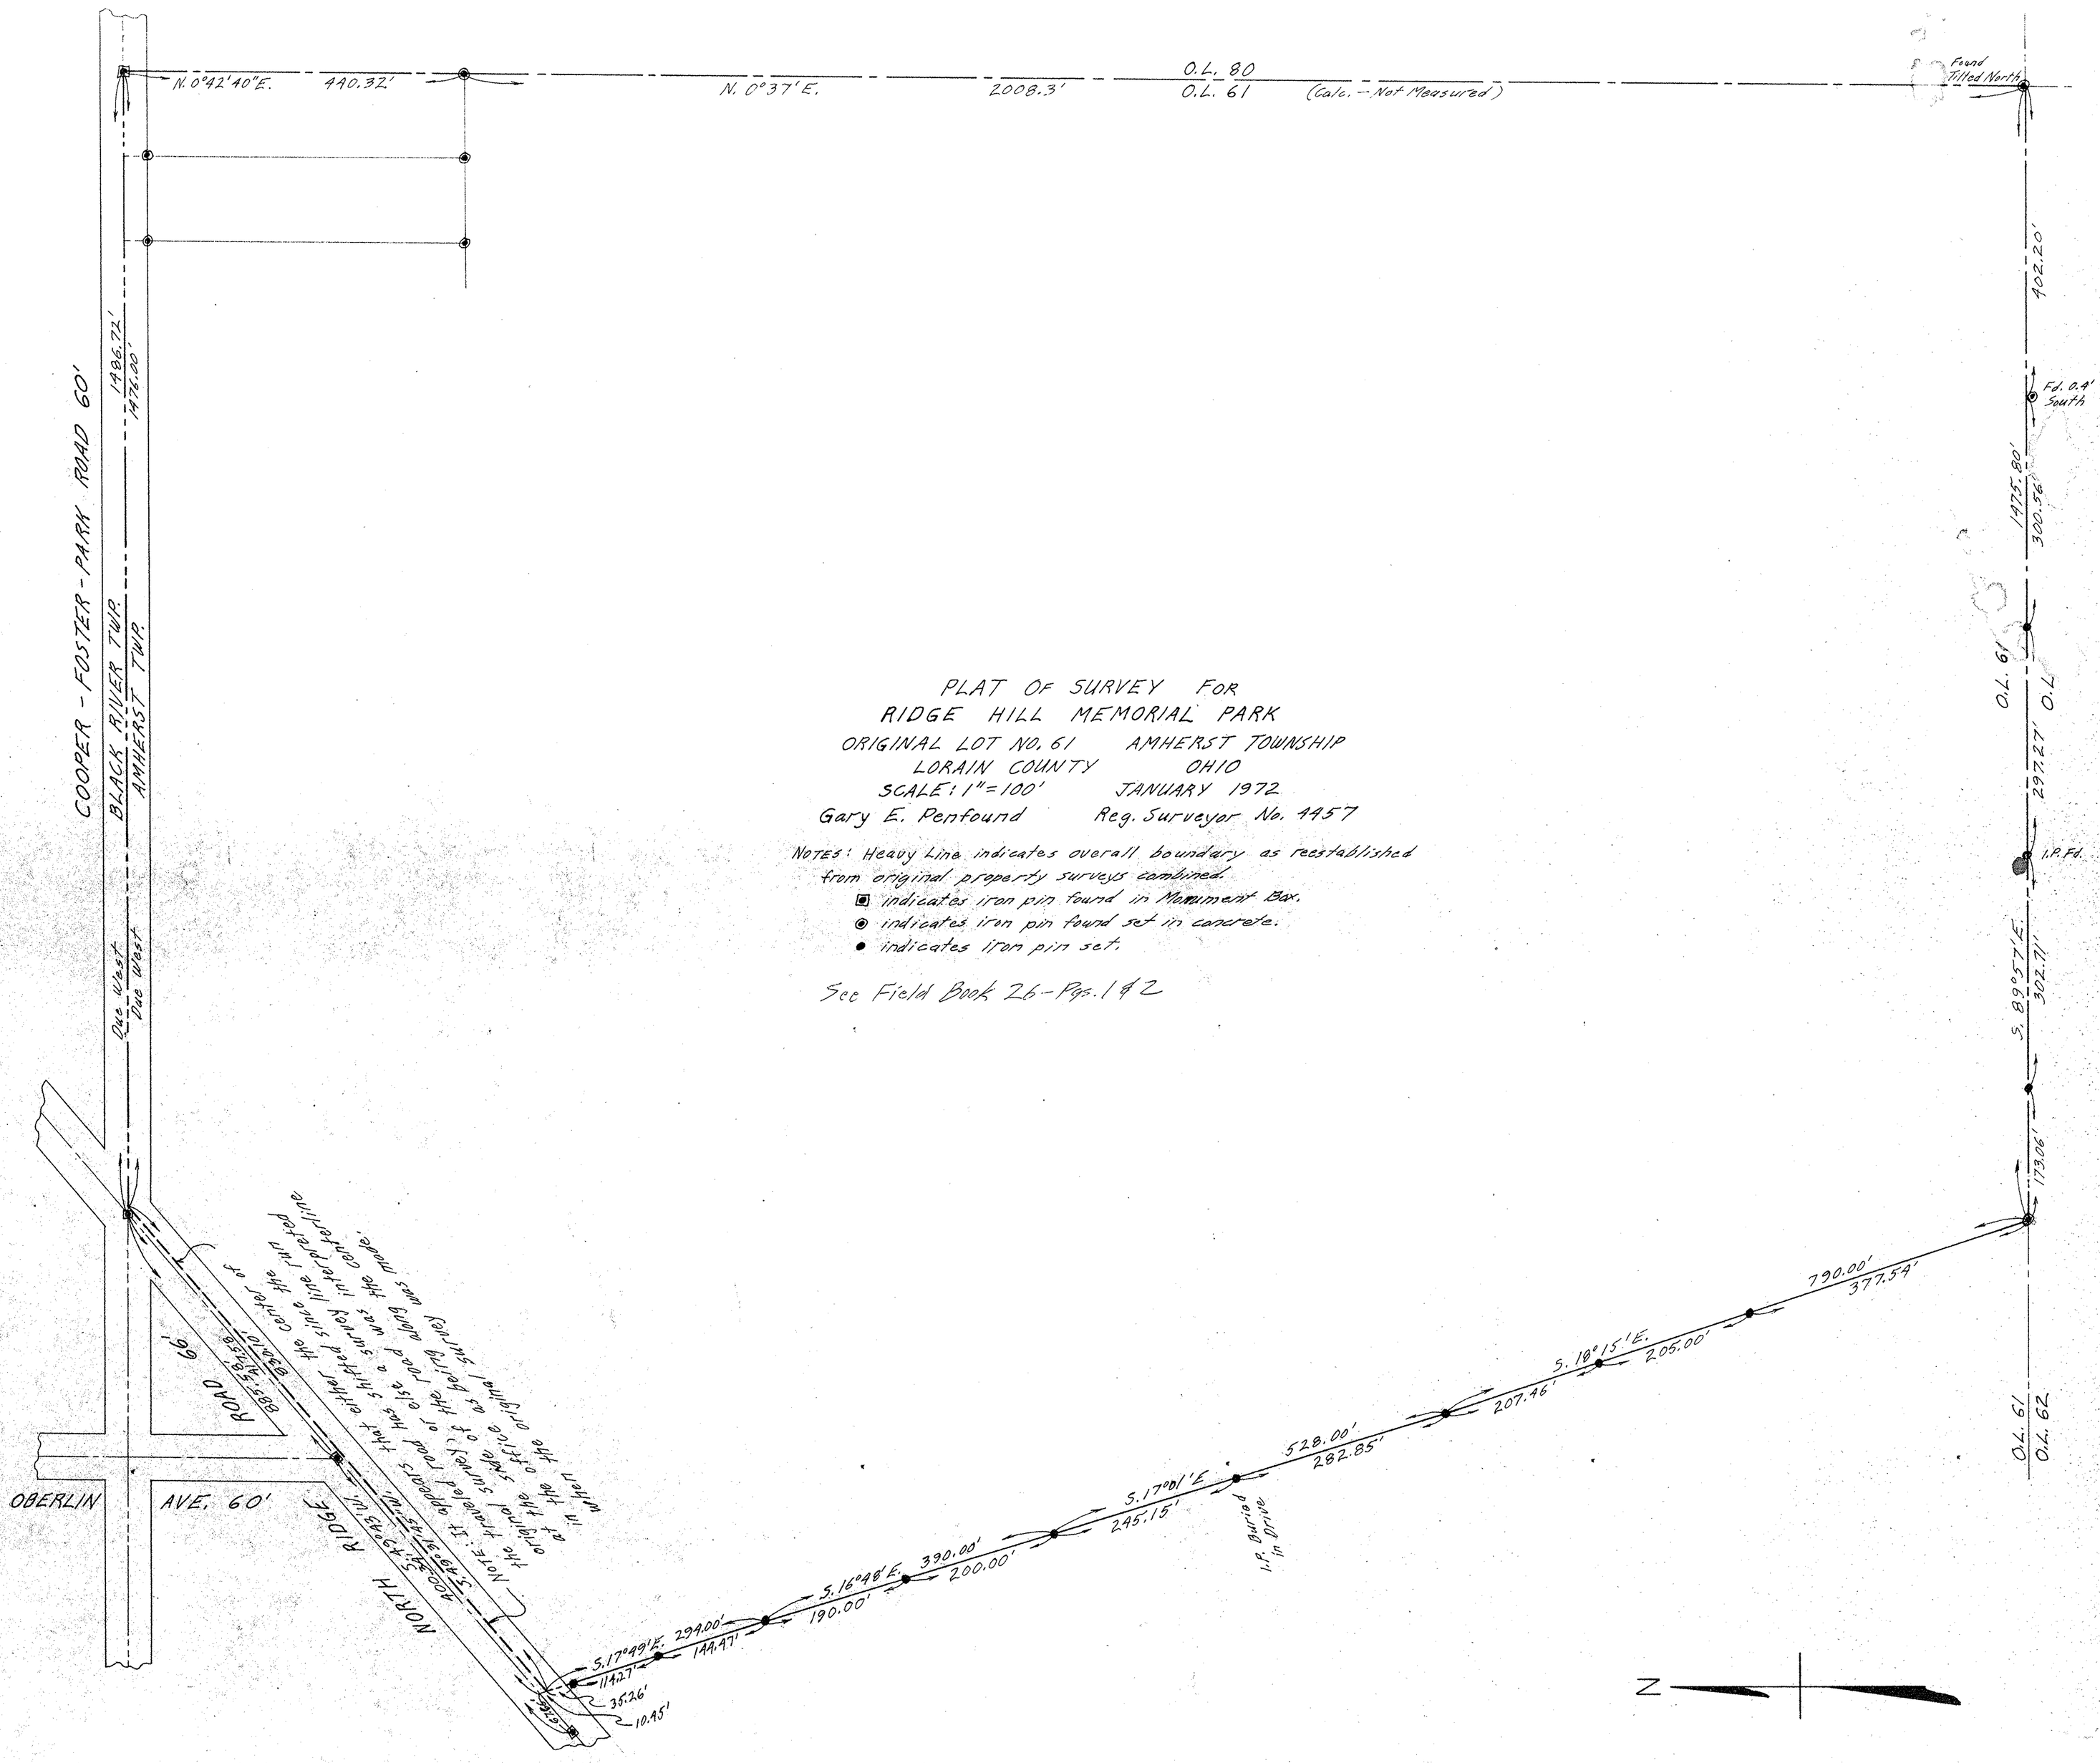

PLAT OF SURVEY FOR
RIDGE HILL MEMORIAL PARK
ORIGINAL LOT NO. 61 AMHERST TOWNSHIP
LORAIN COUNTY OHIO
SCALE: 1" = 100' JANUARY 1972
Gary E. Penfound Reg. Surveyor No. 4457

NOTES: Heavy Line indicates overall boundary as reestablished from original property surveys combined.
- ▣ indicates iron pin found in Monument Box.
- ◉ indicates iron pin found set in concrete.
- ● indicates iron pin set.

See Field Book 26 - Pgs. 1 & 2

