℄ CURVE DATA

P.C. = 24+41.71
P.T. = 24+91.65
Δ = 6°21' = 6.35000°
D = 12°42'50" = 12.71404°
R = 450.65'
T = 25.00'
L = 49.94'
Chd = 49.92'
Bearing = S. 84°29'30"E

P.T. = 25+94.27
Δ = 6°45' = 6.75000°
D = 13°30'58" = 13.51603°
R = 423.91'
T = 25.00'
L = 49.94'
Chd = 49.92'
Bearing = S. 84°41'30"E.

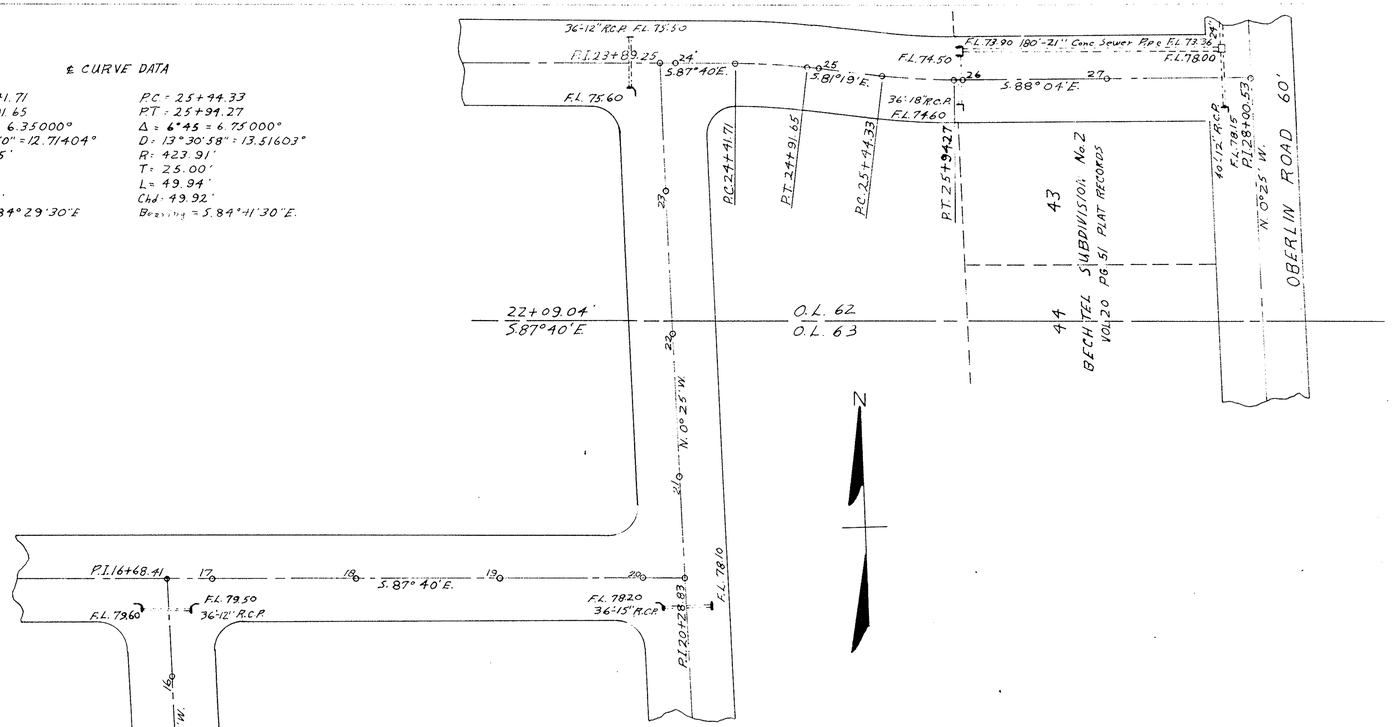

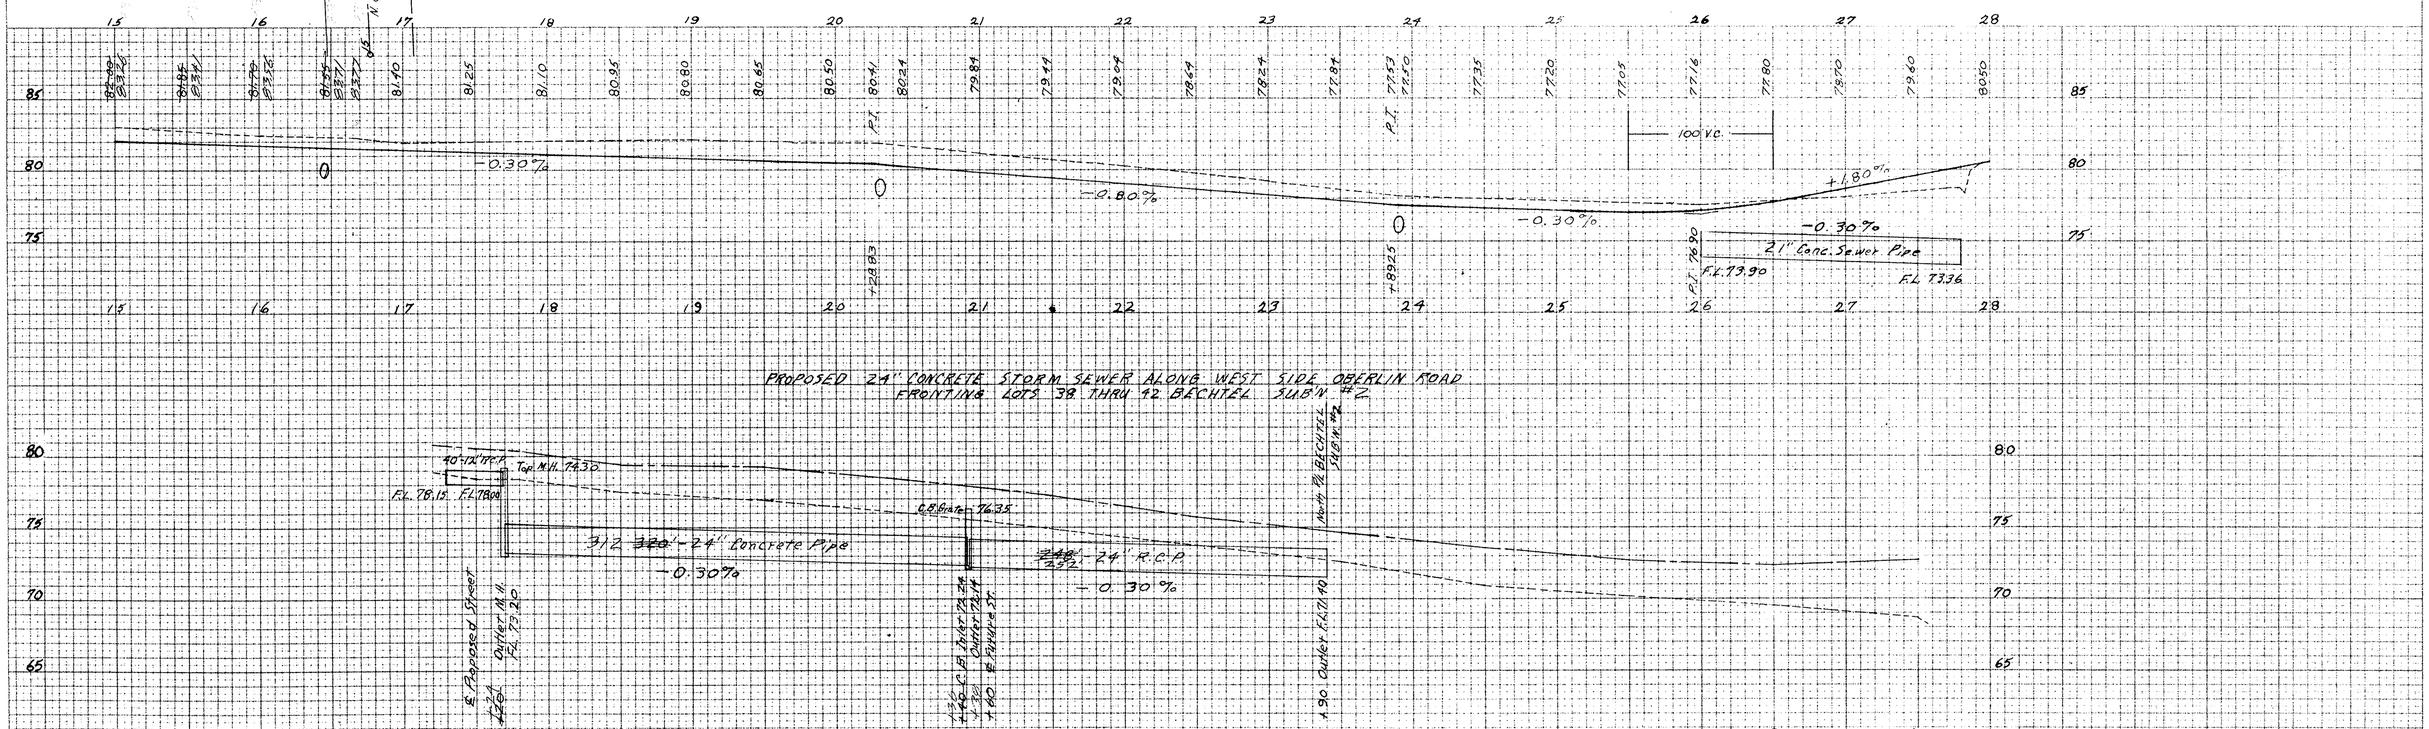

PLATE 4 PLAN & CROSS SECTION