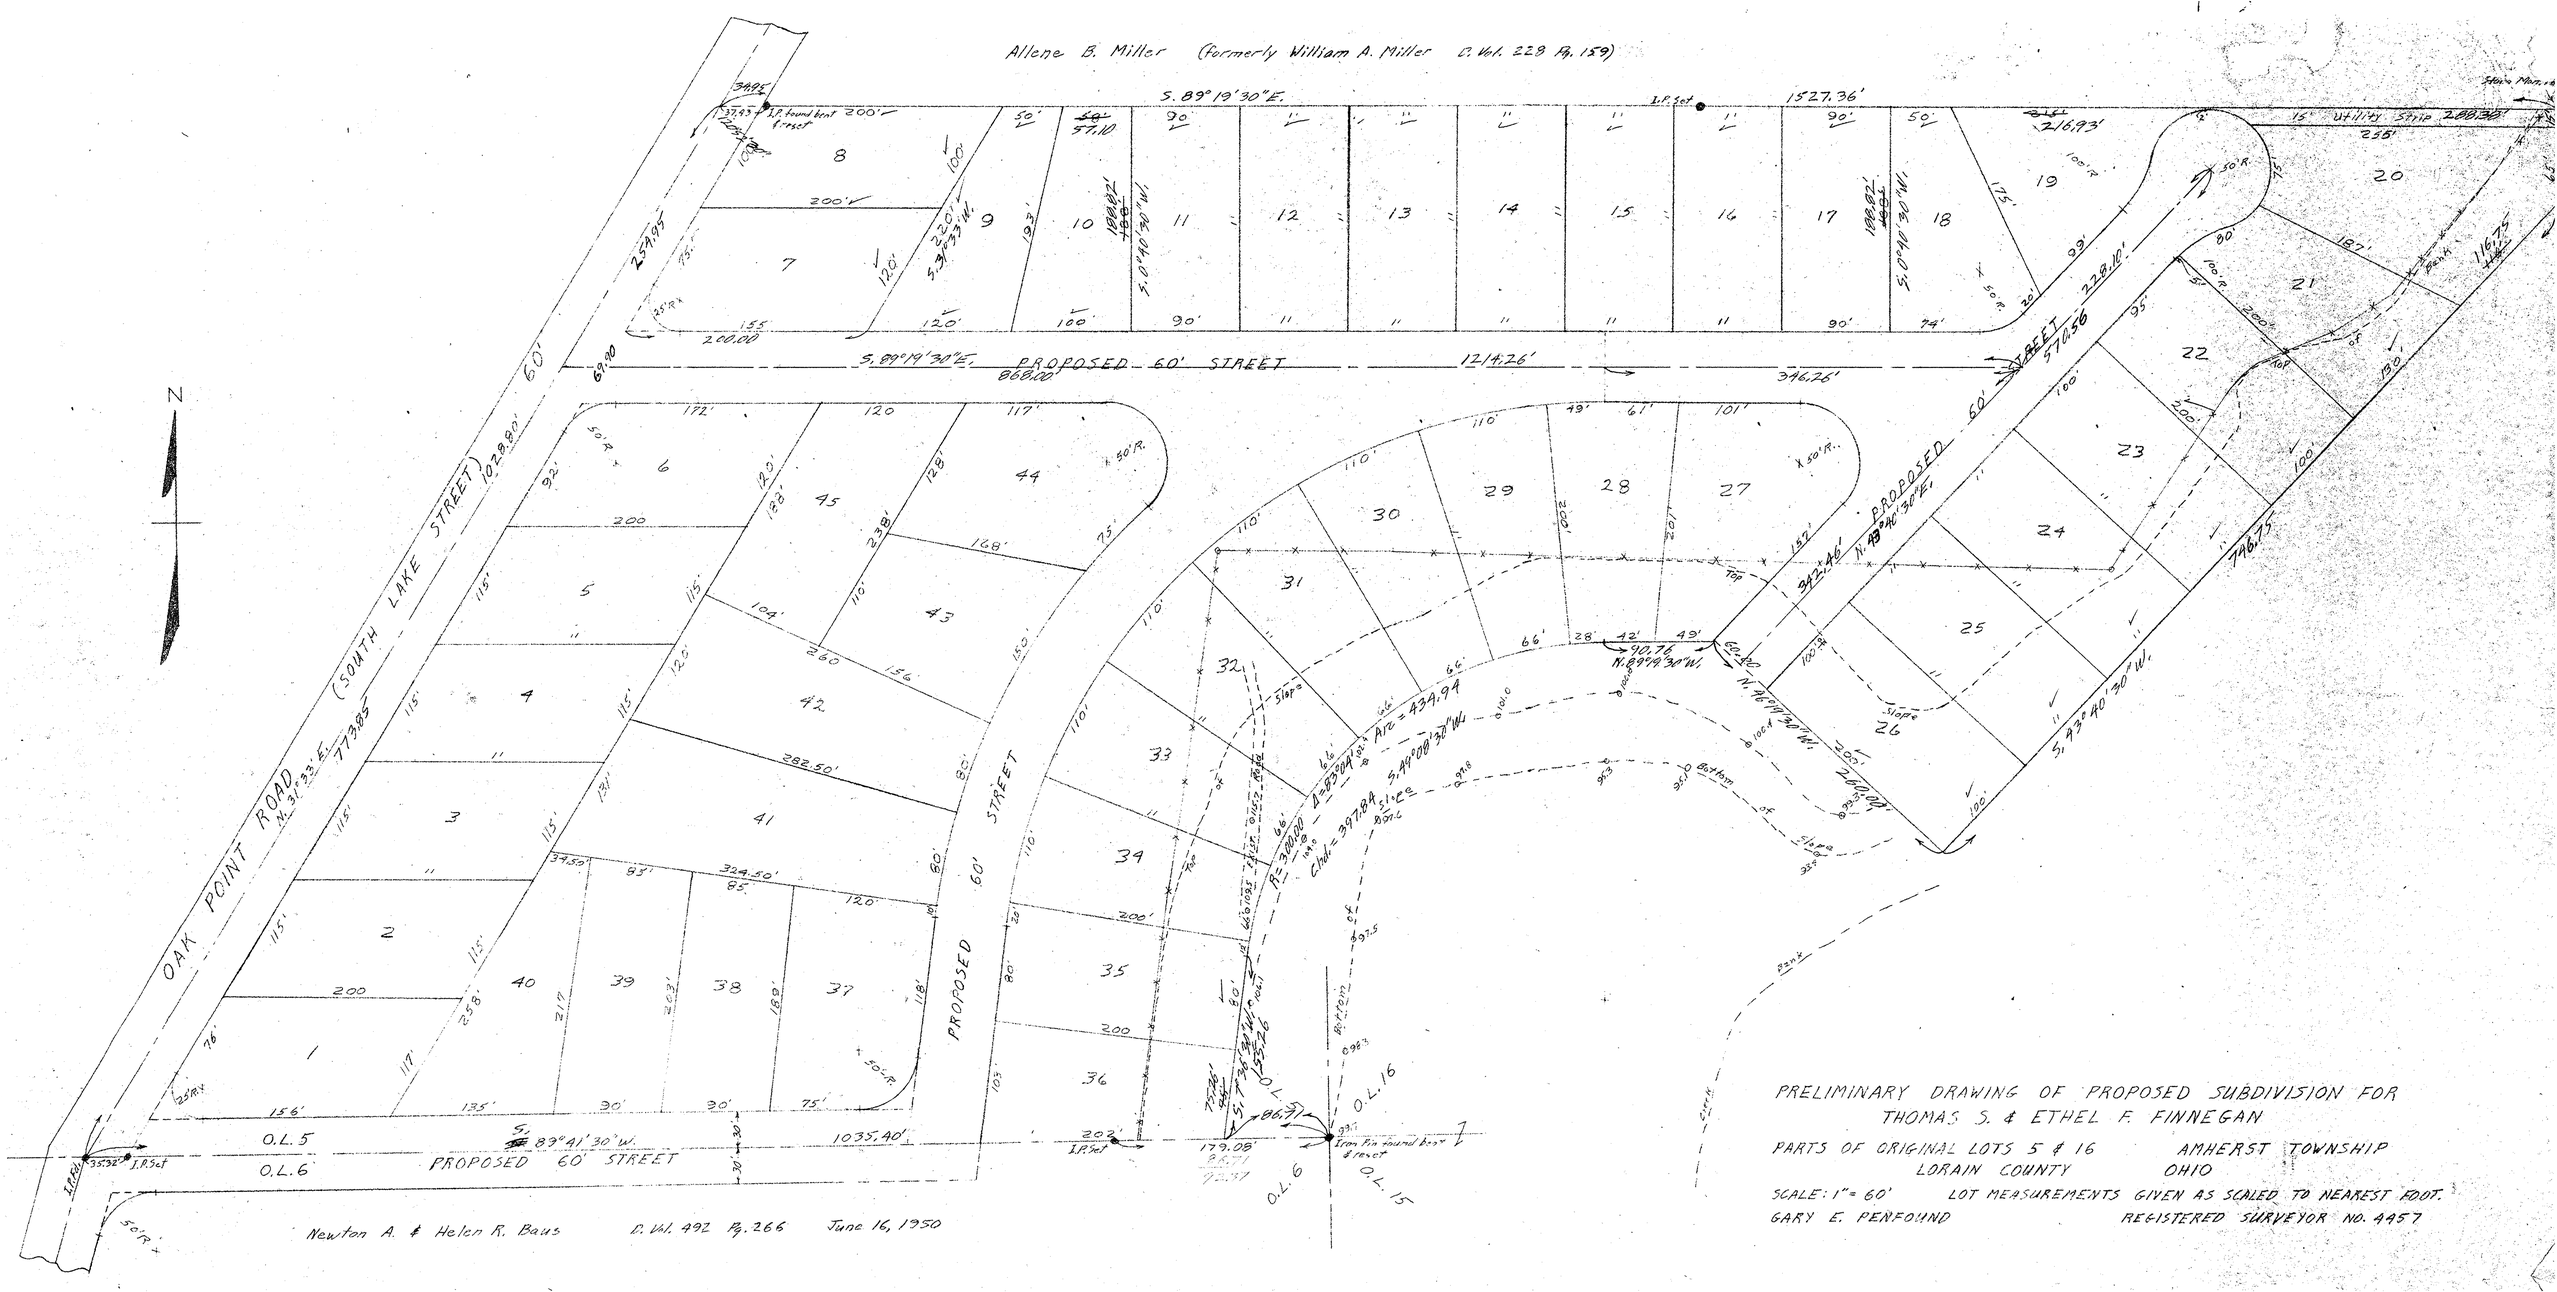

PRELIMINARY DRAWING OF PROPOSED SUBDIVISION FOR
THOMAS S. & ETHEL F. FINNEGAN

PARTS OF ORIGINAL LOTS 5 & 16 AMHERST TOWNSHIP
LORAIN COUNTY OHIO

SCALE: 1" = 60' LOT MEASUREMENTS GIVEN AS SCALED TO NEAREST FOOT.

GARY E. PENFOUND REGISTERED SURVEYOR NO. 4957