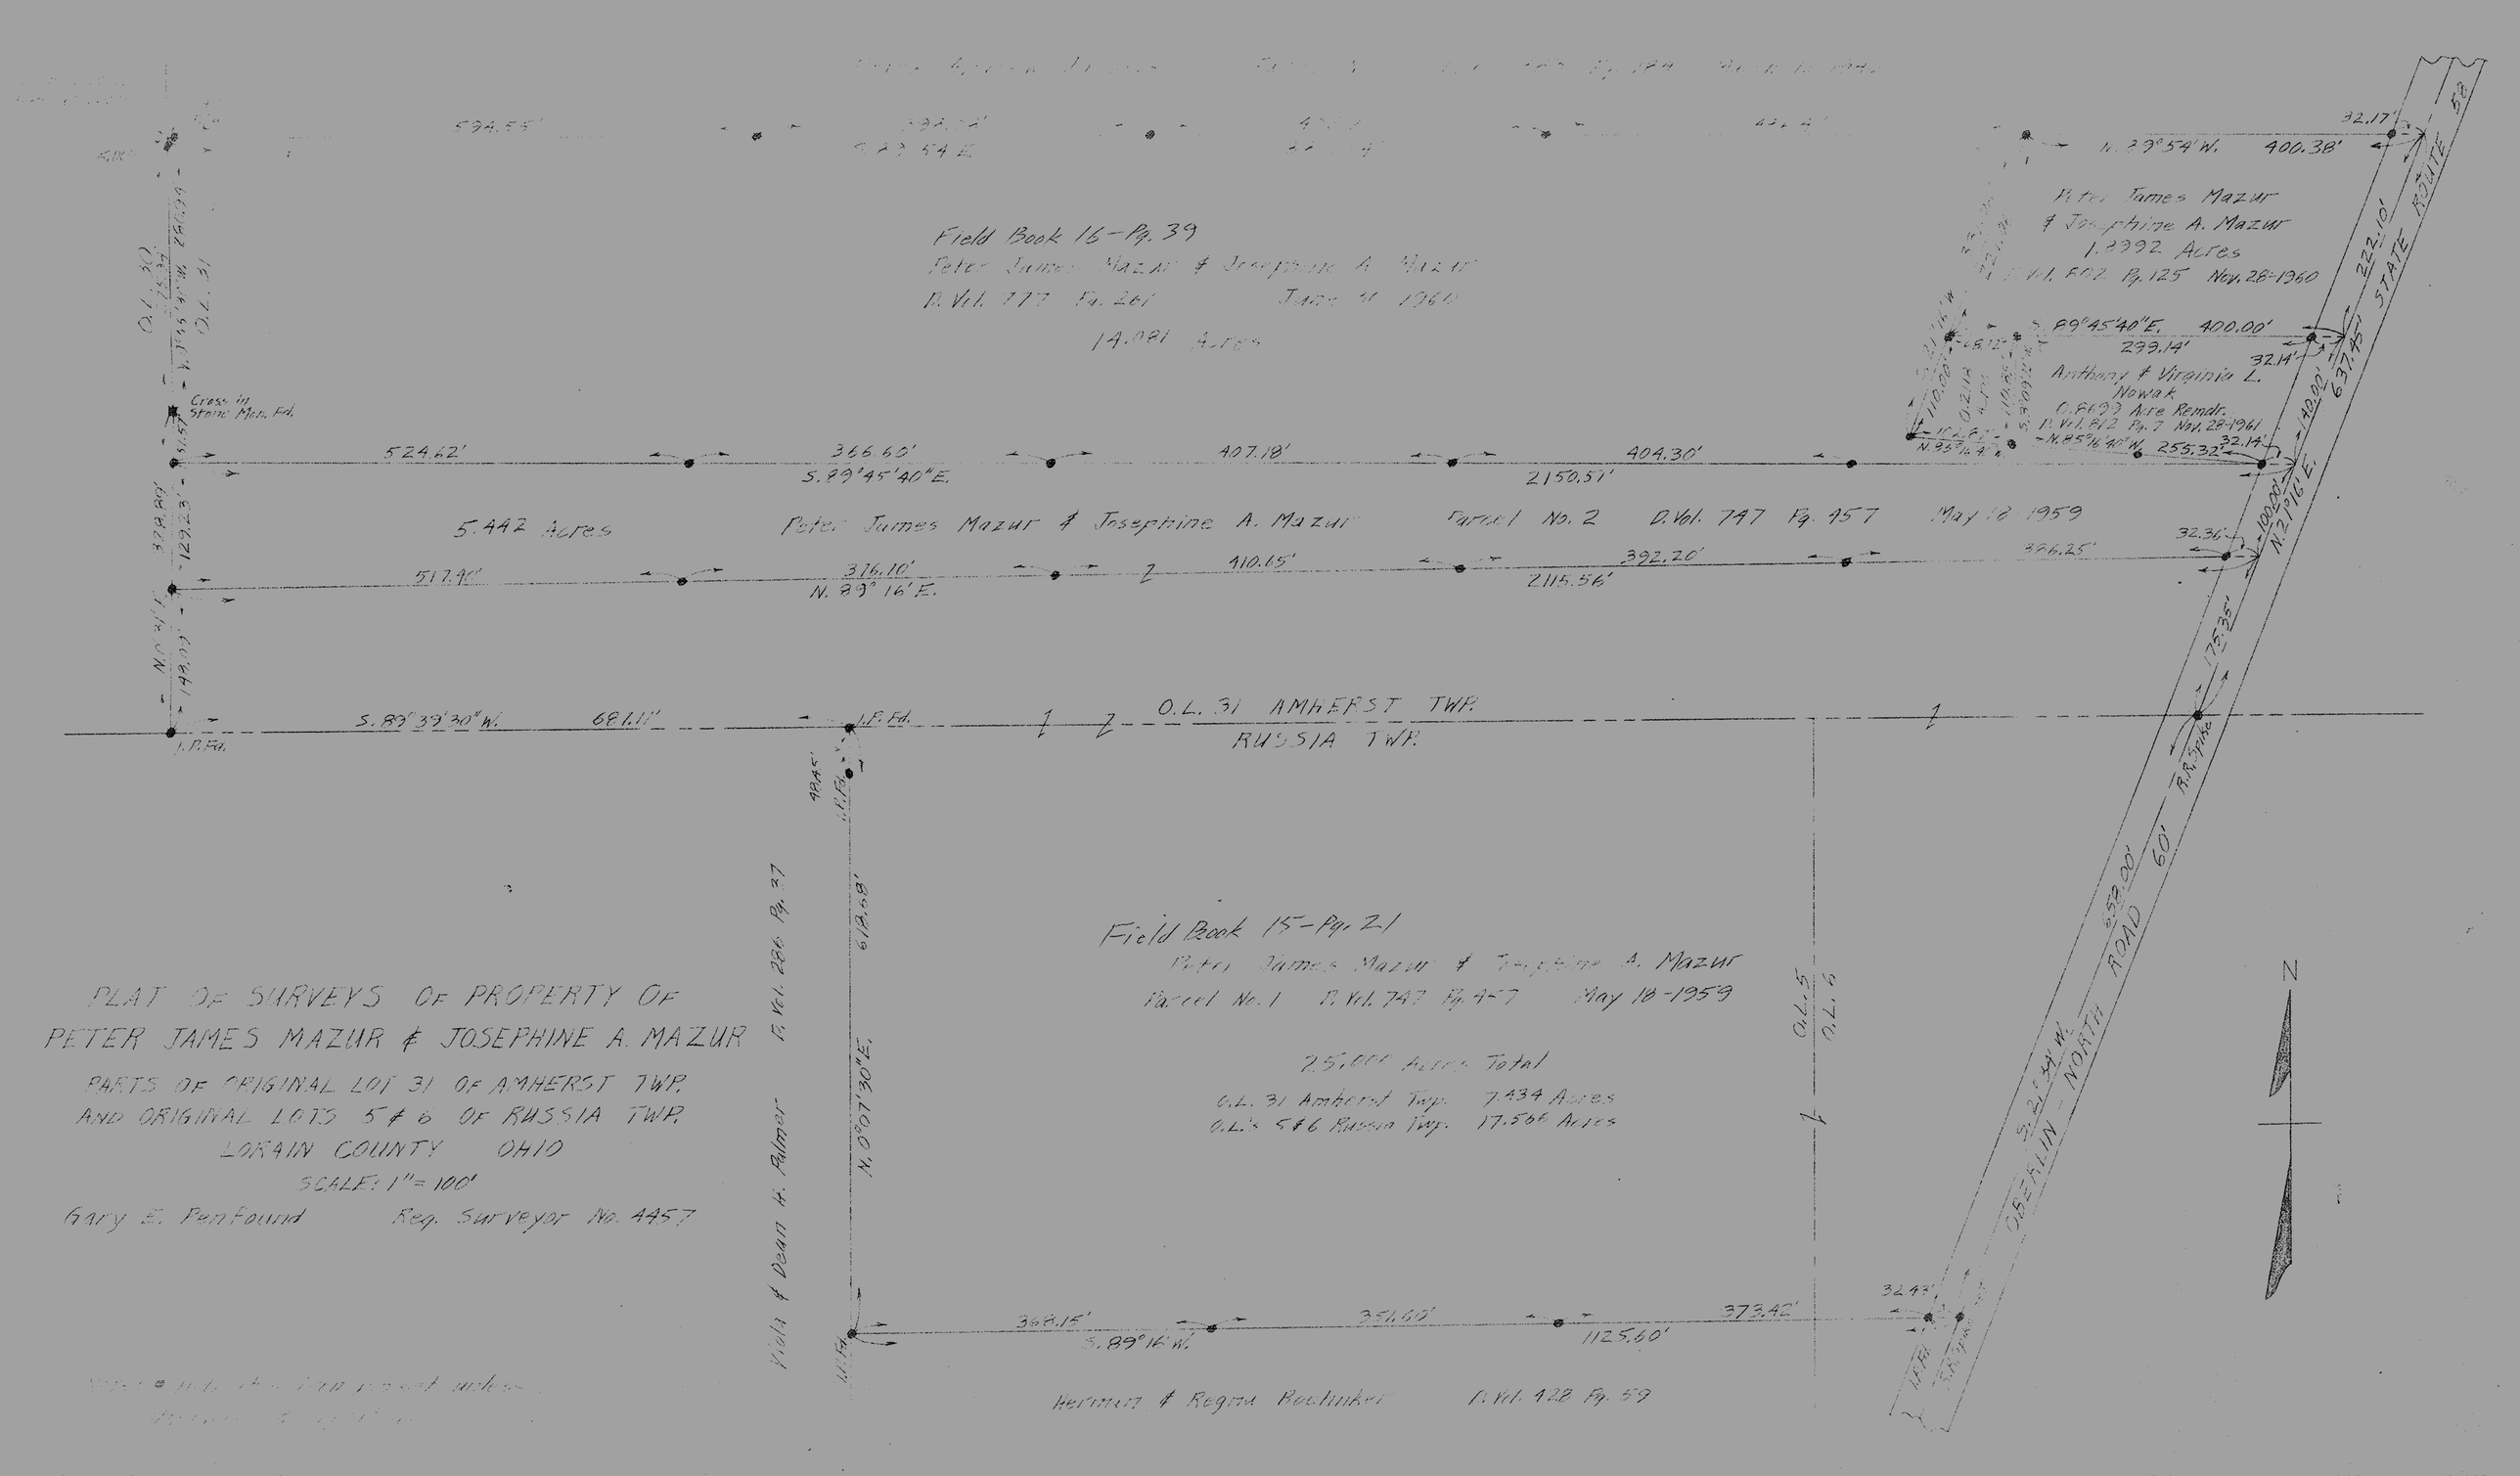
PLAT OF SURVEYS OF PROPERTY OF
PETER JAMES MAZUR & JOSEPHINE A. MAZUR
PARTS OF ORIGINAL LOT 31 OF AMHERST TWP.
AND ORIGINAL LOTS 5 & 6 OF RUSSIA TWP.
LORAIN COUNTY OHIO
SCALE: 1" = 100'
Gary E. Penfound Reg. Surveyor No. 4457
Field Book 16 - Pg. 39
Peter James Mazur & Josephine A. Mazur
D. Vol. 777 Pg. 261 June 11 1960
14.021 Acres
Field Book 15 - Pg. 21
Peter James Mazur & Josephine A. Mazur
Parcel No. 1 D. Vol. 747 Pg. 457 May 18 - 1959
25.000 Acres Total
O.L. 31 Amherst Twp. 7.434 Acres
O.L.'s 5 & 6 Russia Twp. 17.566 Acres
5.442 Acres Peter James Mazur & Josephine A. Mazur Parcel No. 2 D. Vol. 747 Pg. 457 May 18 1959
Peter James Mazur & Josephine A. Mazur
1.2992 Acres
D. Vol. 802 Pg. 125 Nov. 28-1960
Anthony & Virginia L. Nowak
0.8693 Acre Remdr.
D. Vol. 812 Pg. 7 Nov. 28-1961
Wolf & Dean H. Palmer D. Vol. 286 Pg. 37
Hermann & Regina Roehniker D. Vol. 128 Pg. 59
O.L. 31 AMHERST TWP.
RUSSIA TWP.
OBERLIN - NORTH ROAD 60'
STATE ROUTE 58
N.