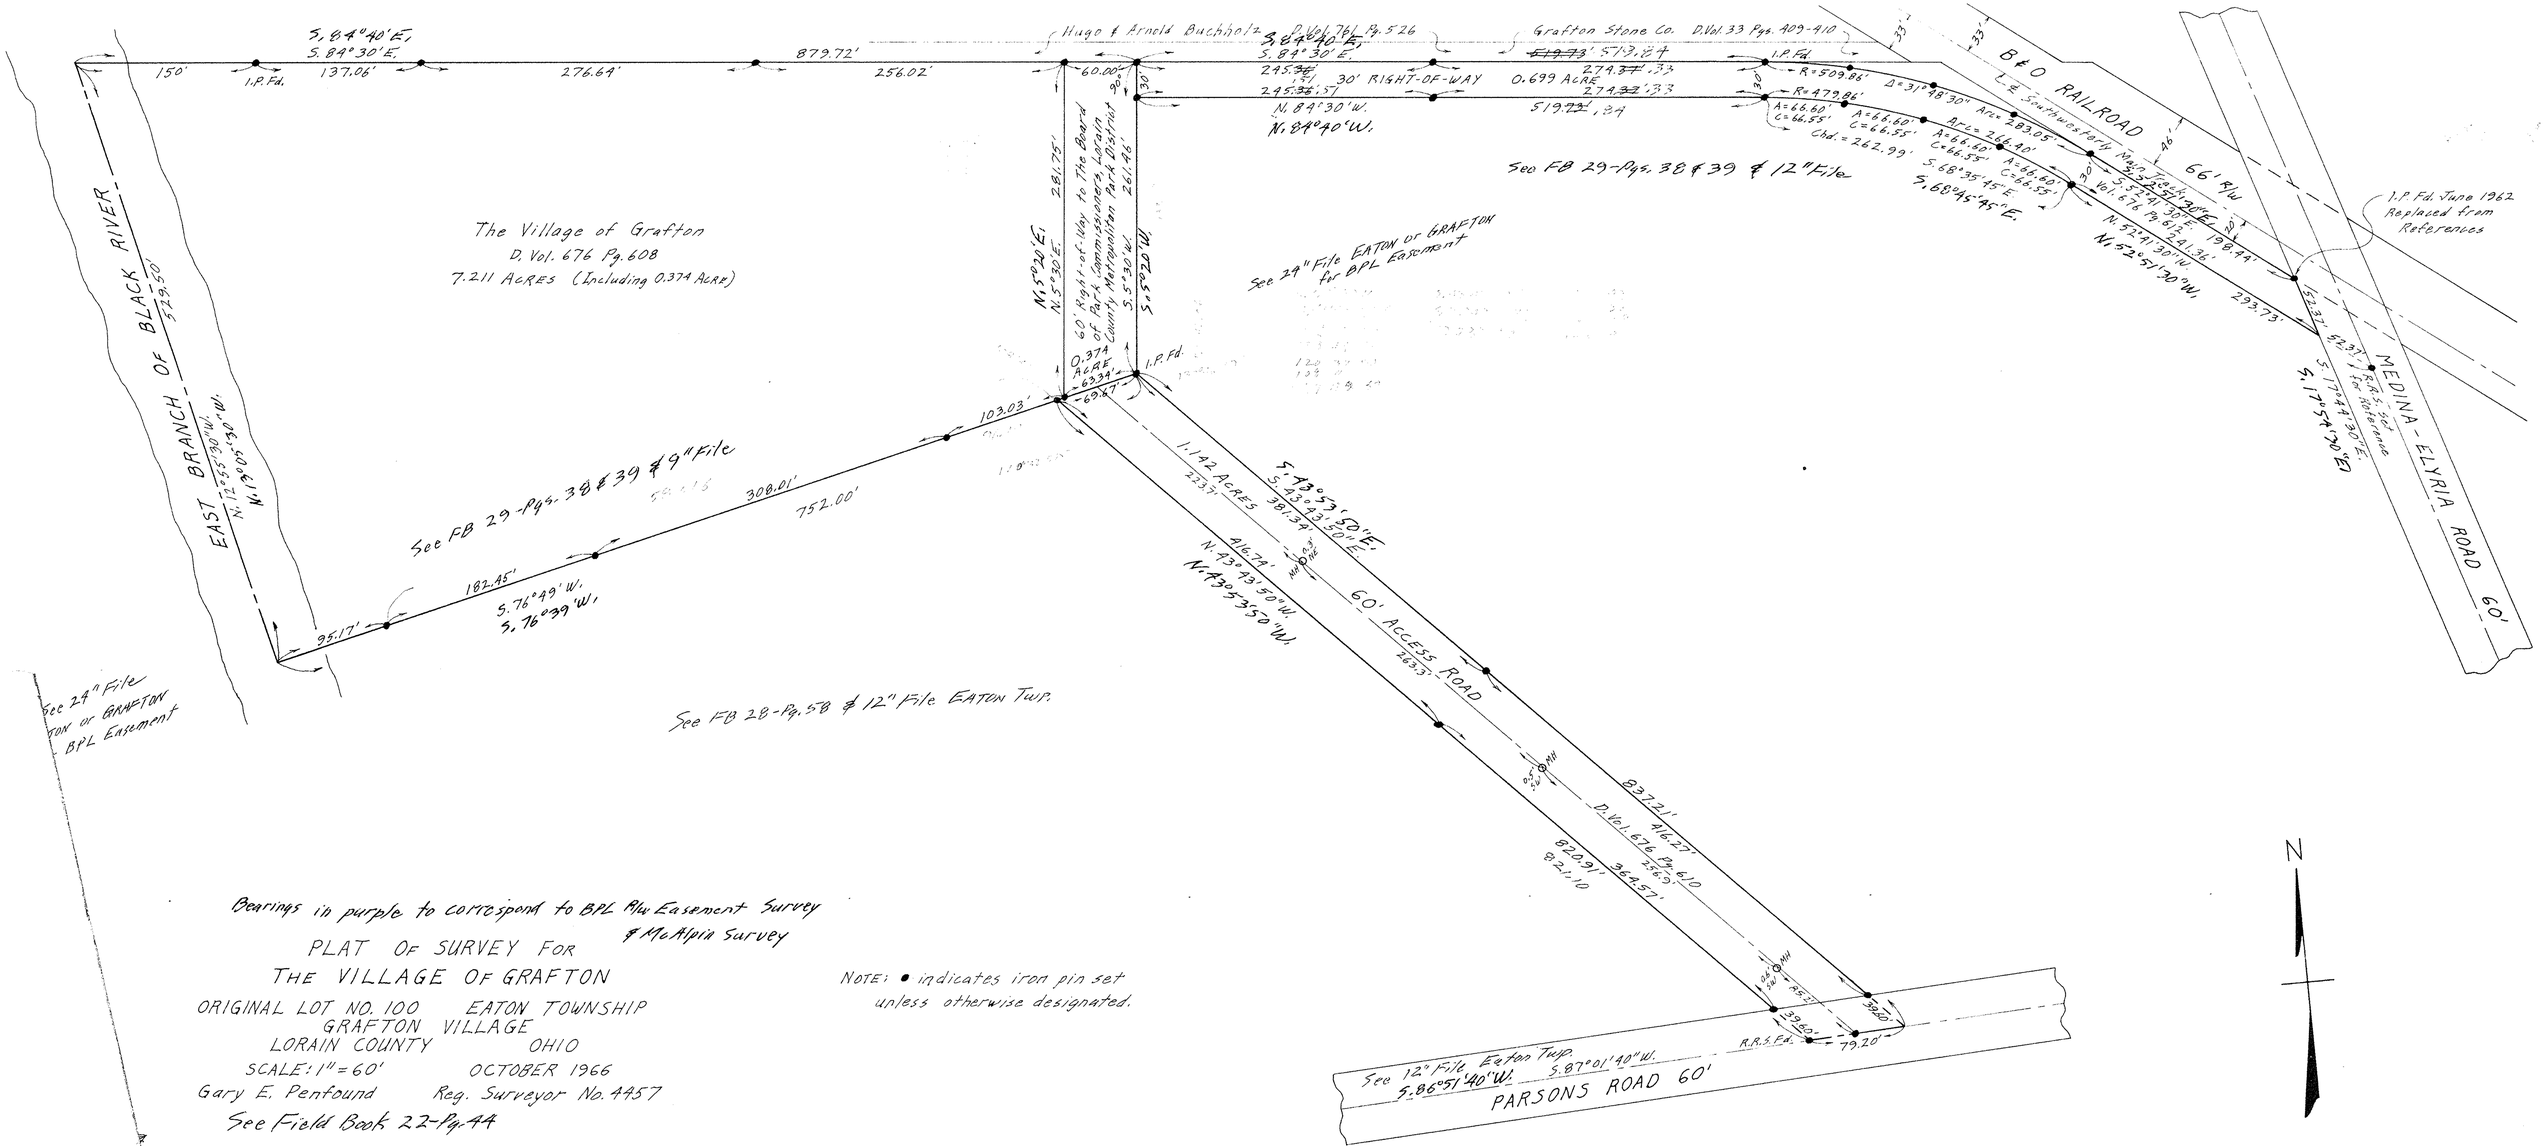

Bearings in purple to correspond to BPL R/W Easement Survey & McAlpin Survey

PLAT OF SURVEY FOR
THE VILLAGE OF GRAFTON

ORIGINAL LOT NO. 100 EATON TOWNSHIP
GRAFTON VILLAGE
LORAIN COUNTY OHIO

SCALE: 1" = 60' OCTOBER 1966

Gary E. Penfound Reg. Surveyor No. 4457

See Field Book 22-Pg. 44

NOTE: ● indicates iron pin set unless otherwise designated.