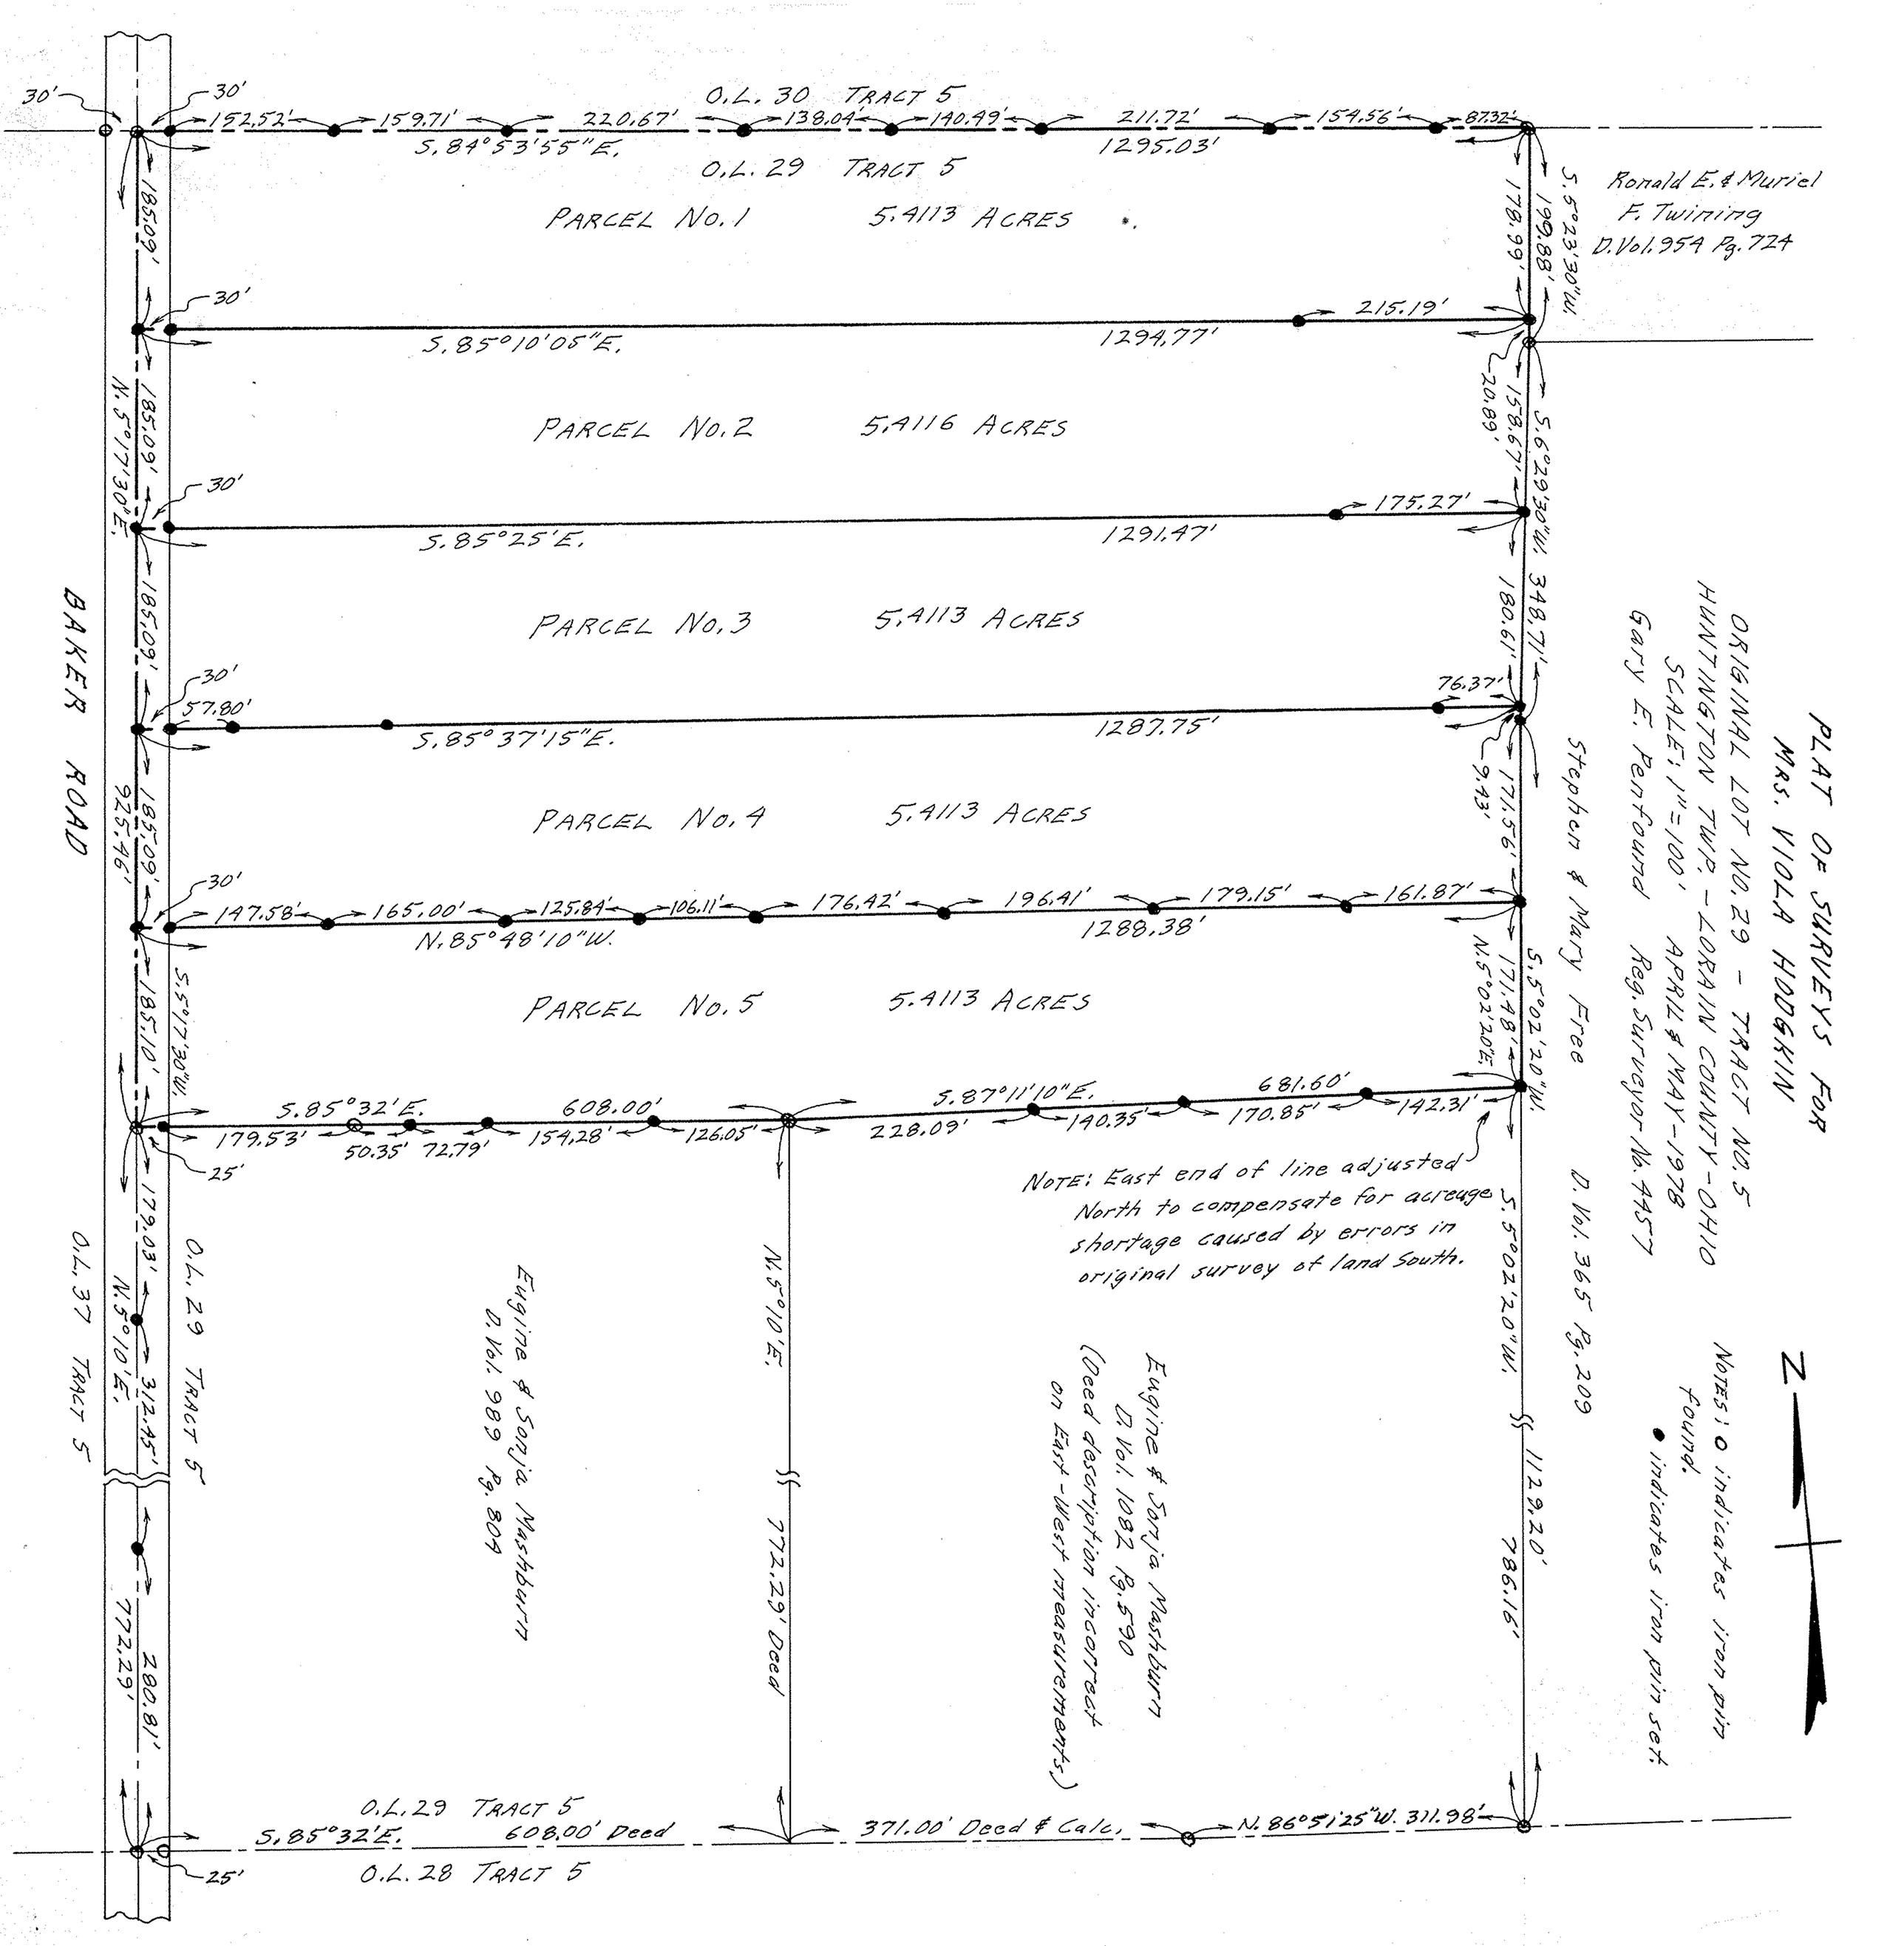
PLAT OF SURVEYS FOR
MRS. VIOLA HODGKIN
ORIGINAL LOT NO. 29 - TRACT NO. 5
HUNTINGTON TWP. - LORAIN COUNTY - OHIO
SCALE: 1" = 100' APRIL & MAY - 1978
Gary E. Penfound Reg. Surveyor No. 4457
Stephen & Mary Free
D. Vol. 365 Pg. 209
Ronald E. & Muriel F. Twining
D. Vol. 954 Pg. 724
Eugine & Sonja Mashburn
D. Vol. 989 Pg. 804
Eugine & Sonja Mashburn
D. Vol. 1082 Pg. 590
(Deed description incorrect on East-West measurements)
NOTE: East end of line adjusted North to compensate for acreage shortage caused by errors in original survey of land South.
NOTES: o indicates iron pin found.
• indicates iron pin set.
N
O.L. 30 TRACT 5
O.L. 29 TRACT 5
PARCEL No. 1 5.4113 ACRES
PARCEL No. 2 5.4116 ACRES
PARCEL No. 3 5.4113 ACRES
PARCEL No. 4 5.4113 ACRES
PARCEL No. 5 5.4113 ACRES
BAKER ROAD
O.L. 37 TRACT 5
O.L. 29 TRACT 5
O.L. 28 TRACT 5
S. 84°53'55"E.
S. 85°10'05"E.
S. 85°25'E.
S. 85°37'15"E.
N. 85°48'10"W.
S. 85°32'E.
S. 87°11'10"E.
S. 5°23'30"W.
S. 6°29'30"W.
S. 5°02'20"W.
N. 5°02'20"E.
N. 5°17'30"E.
S. 5°17'30"W.
N. 5°10'E.
N. 86°51'25"W.
30'
25'
152.52'
159.71'
220.67'
138.04'
140.49'
211.72'
154.56'
87.32'
1295.03'
185.09'
178.99'
199.88'
215.19'
1294.77'
20.89'
158.67'
175.27'
1291.47'
180.61'
348.71'
57.80'
76.37'
1287.75'
9.43'
171.56'
925.46'
147.58'
165.00'
125.84'
106.11'
176.42'
196.41'
179.15'
161.87'
1288.38'
171.48'
185.10'
179.53'
50.35'
72.79'
154.28'
608.00'
126.05'
228.09'
140.35'
170.85'
681.60'
142.31'
179.03'
312.45'
772.29'
280.81'
772.29' Deed
1129.20'
786.16'
608.00' Deed
371.00' Deed & Calc.
311.98'