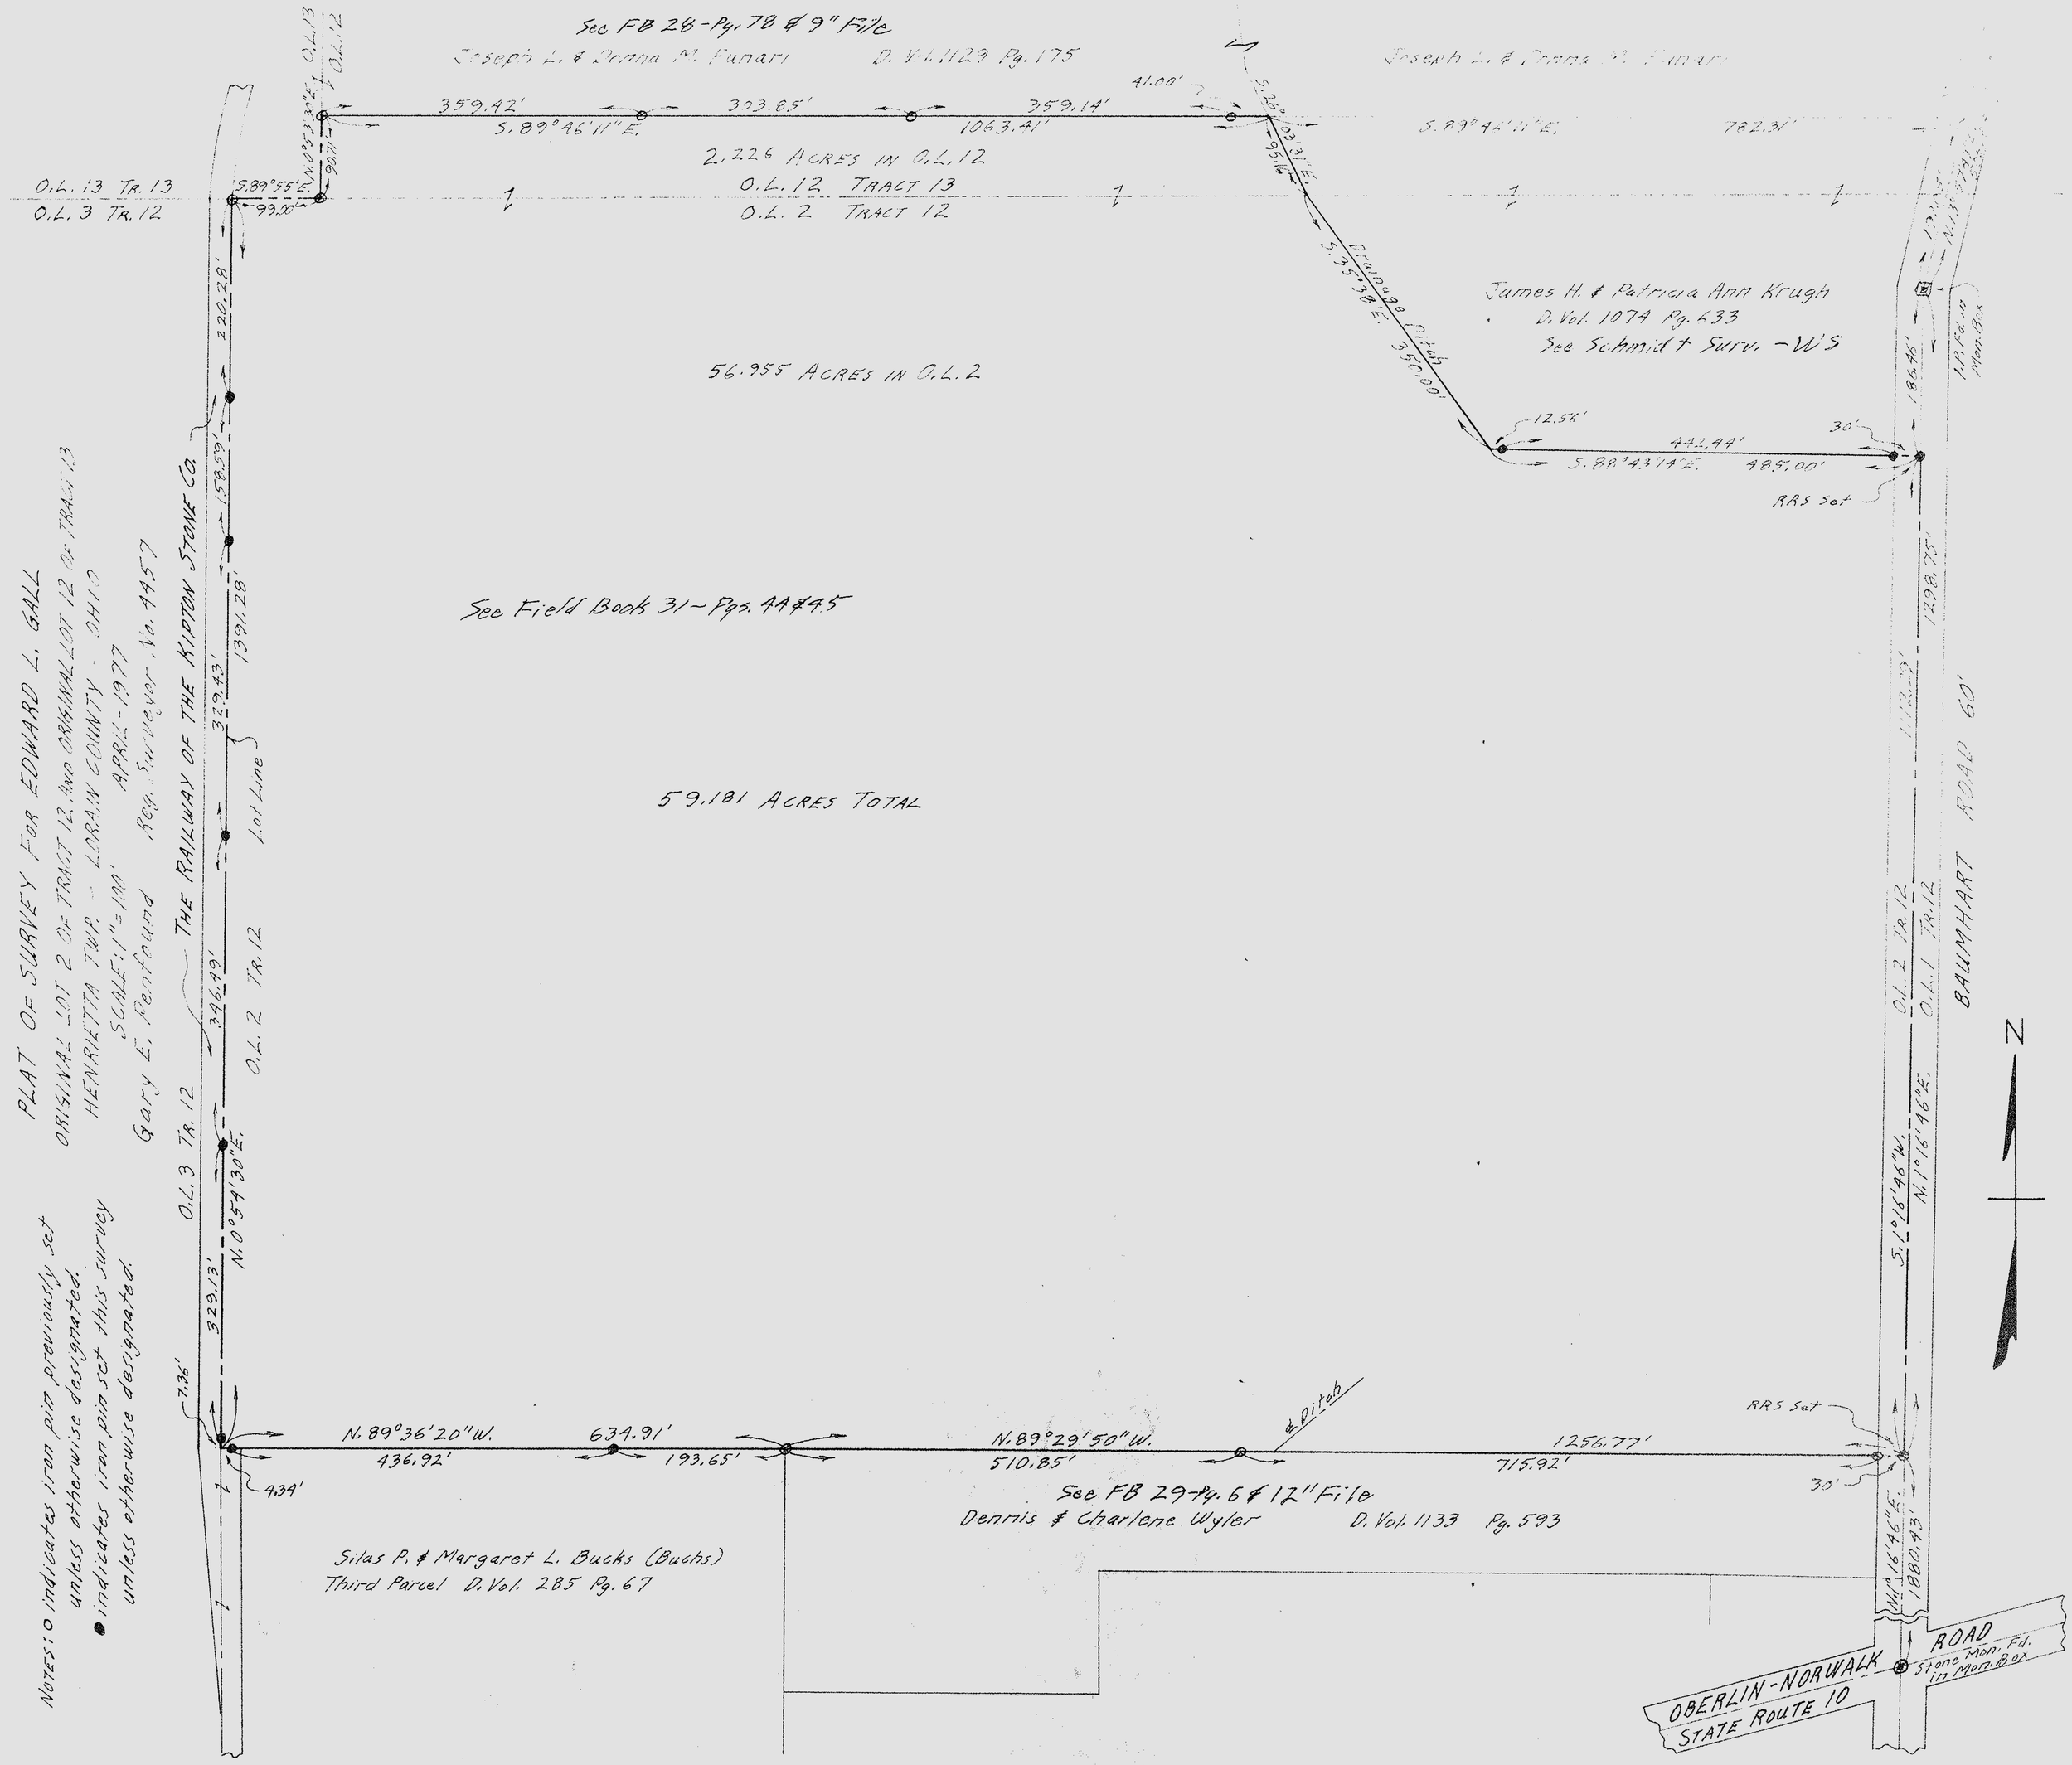
PLAT OF SURVEY FOR EDWARD L. GALL
ORIGINAL LOT 2 OF TRACT 12, AND ORIGINAL LOT 12 OF TRACT 13
HENRIETTA TWP. - LORAIN COUNTY, OHIO
SCALE: 1" = 100'
APRIL - 1977
Gary E. Renfroe Reg. Surveyor No. 4457
Found
THE RAILWAY OF THE KIPTON STONE CO.
See Field Book 31 - Pgs. 44 & 45
59.181 ACRES TOTAL
56.955 ACRES IN O.L. 2
2.226 ACRES IN O.L. 12
O.L. 12 TRACT 13
O.L. 2 TRACT 12
O.L. 13 TR. 13
O.L. 3 TR. 12
See FB 28 - Pg. 78 & 9" File
Joseph L. & Donna M. Funari D. Vol. 1129 Pg. 175
Joseph L. & Donna M. Funari
James H. & Patricia Ann Krugh
D. Vol. 1074 Pg. 633
See Schmidt + Surv. - W'S
Drainage Ditch
See Field Book 29 - Pg. 6 & 12" File
Dennis & Charlene Wyler D. Vol. 1133 Pg. 593
Silas P. & Margaret L. Bucks (Bucks)
Third Parcel D. Vol. 285 Pg. 67
Lot Line
RRS Set
Stone Mon. Fd. in Mon. Box
OBERLIN-NORWALK ROAD
STATE ROUTE 10
BAUMHART ROAD 60'
N
Notes: o indicates iron pin previously set unless otherwise designated.
● indicates iron pin set this survey unless otherwise designated.