PLAT OF SURVEY FOR

BROTHERTON DISPOSAL

PREMISES KNOWN AS

THE FORD ROAD DUMP

ORIGINAL LOTS NOS. 20 & 21

BRACE TRACT ELYRIA TWP.

ELYRIA CITY

LORAIN COUNTY OHIO

SCALE: 1"=100' 1964 - 1965

Gary E. Penfound

Reg. Surveyor No. 4457
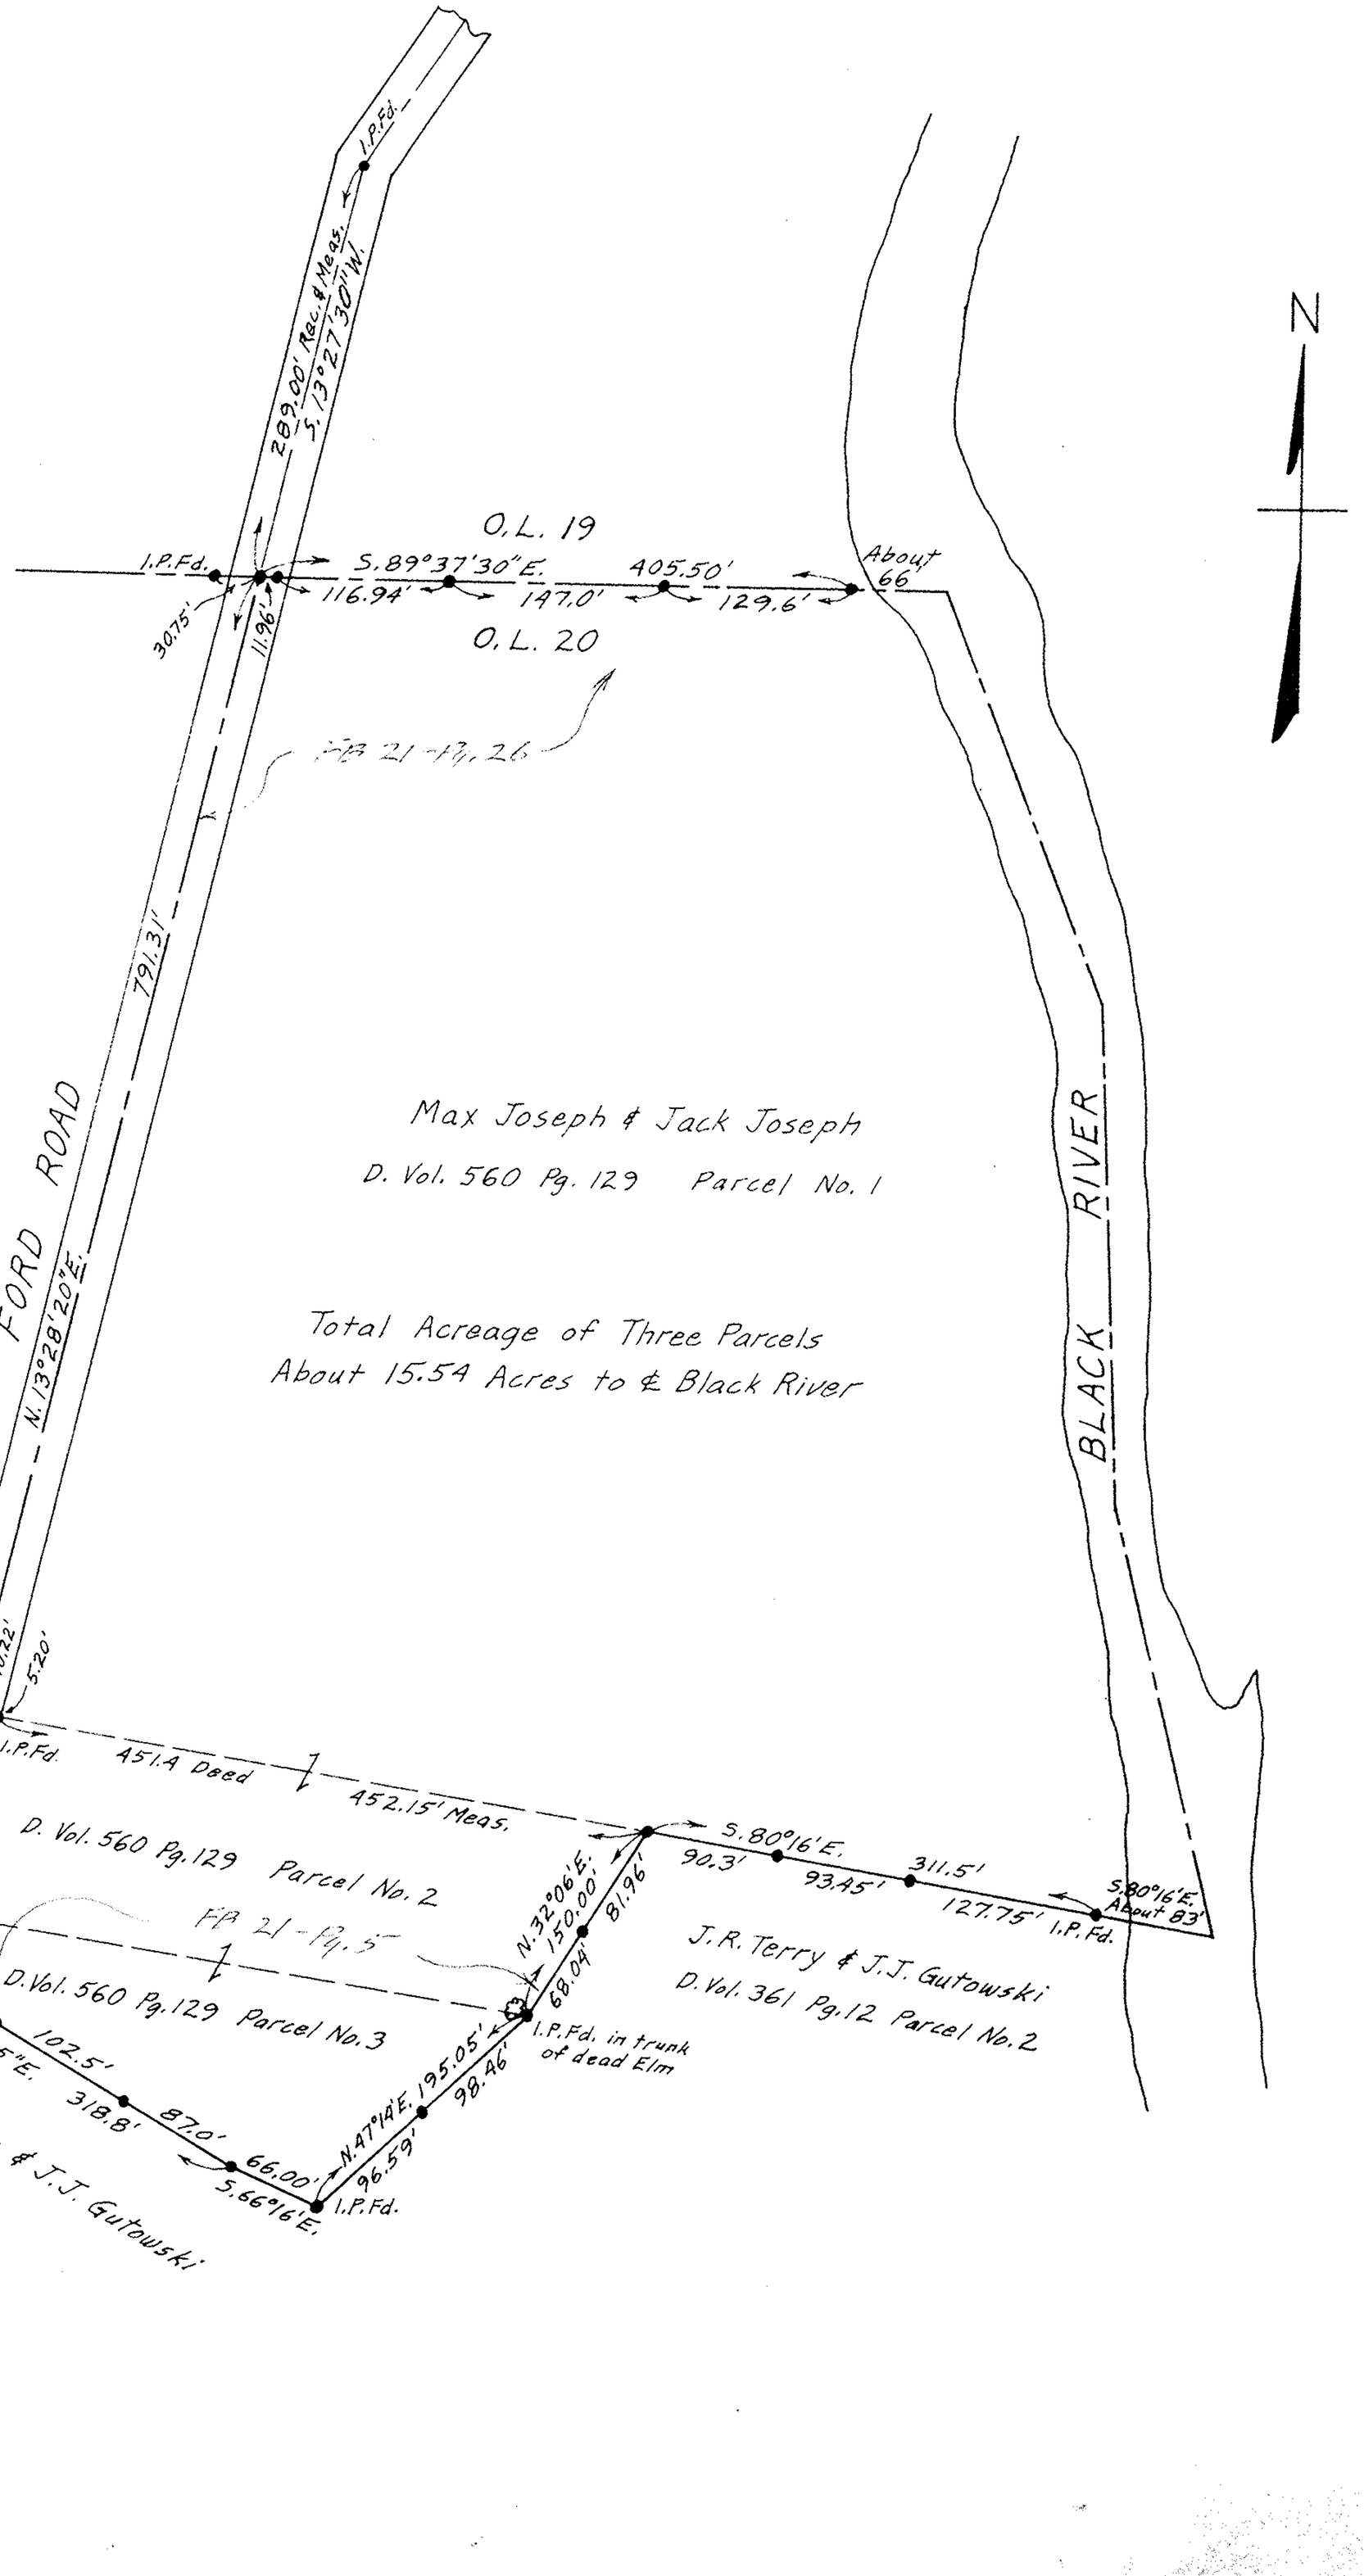
NOTE: ● indicates iron pin set unless otherwise designated.