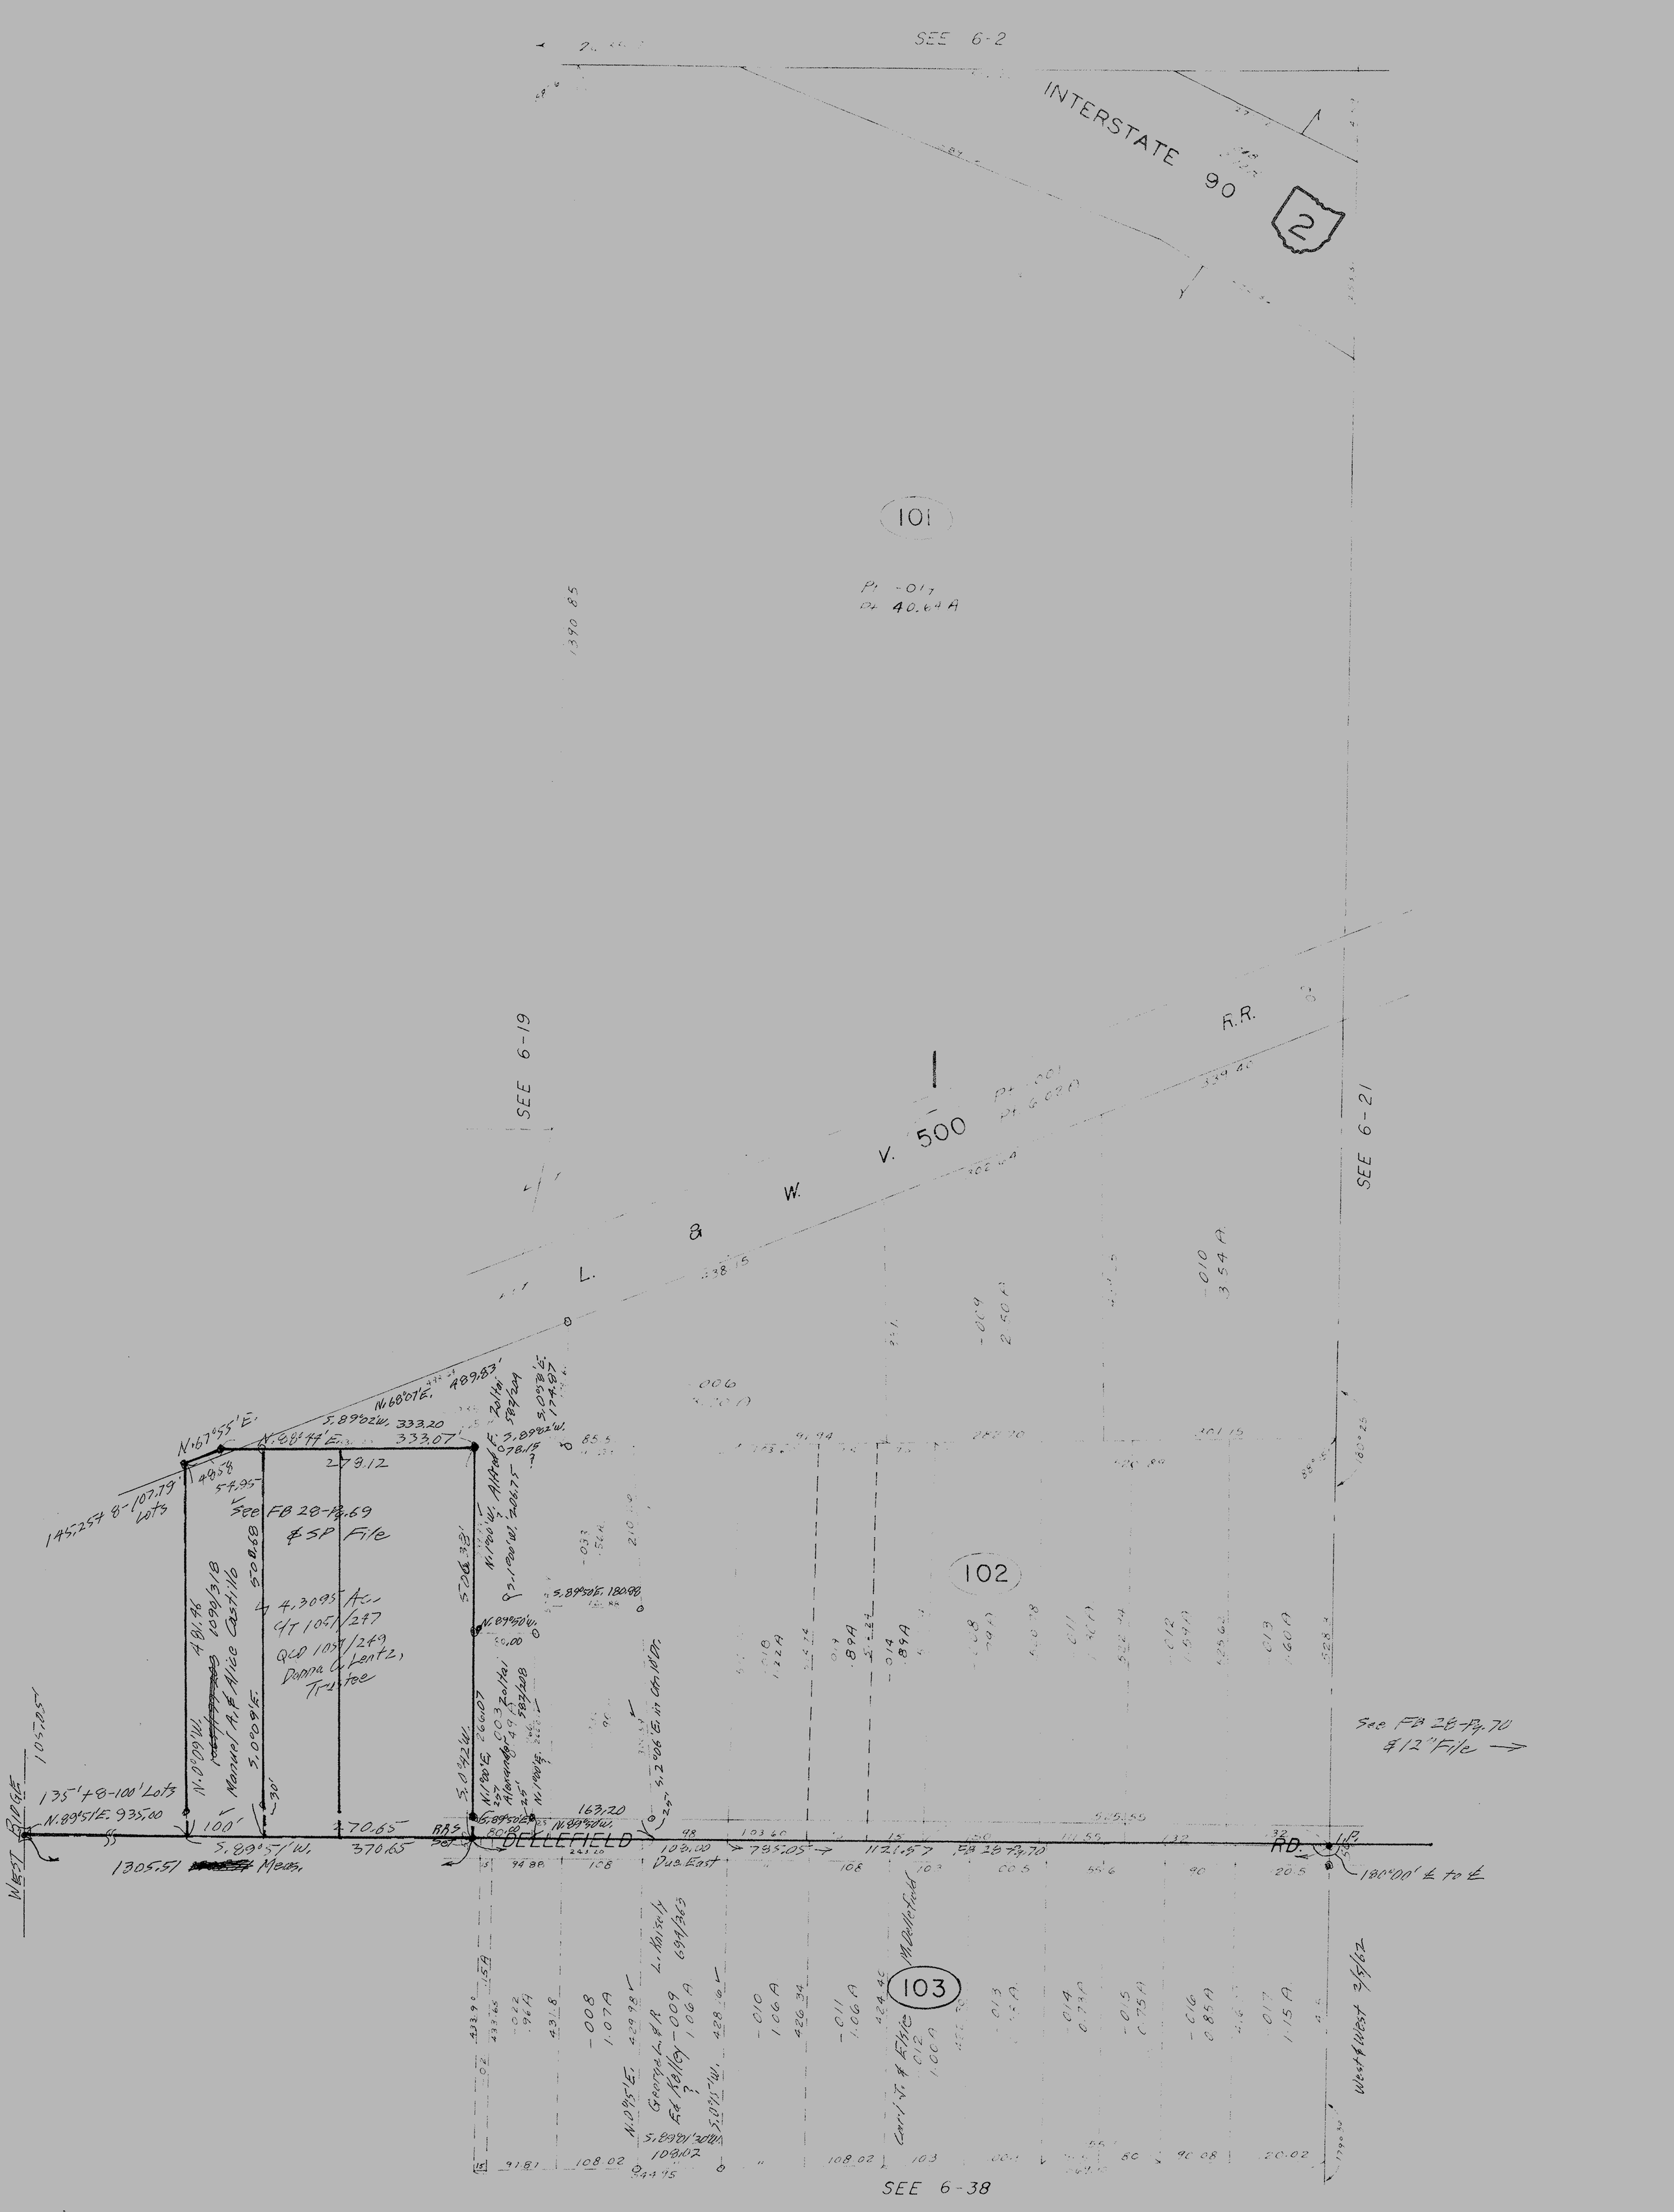

ELYRIA TWP.

SCALE: 1" = 100'

BRACE TRACT

PT. E. 1/2 LOT 1

1090/318