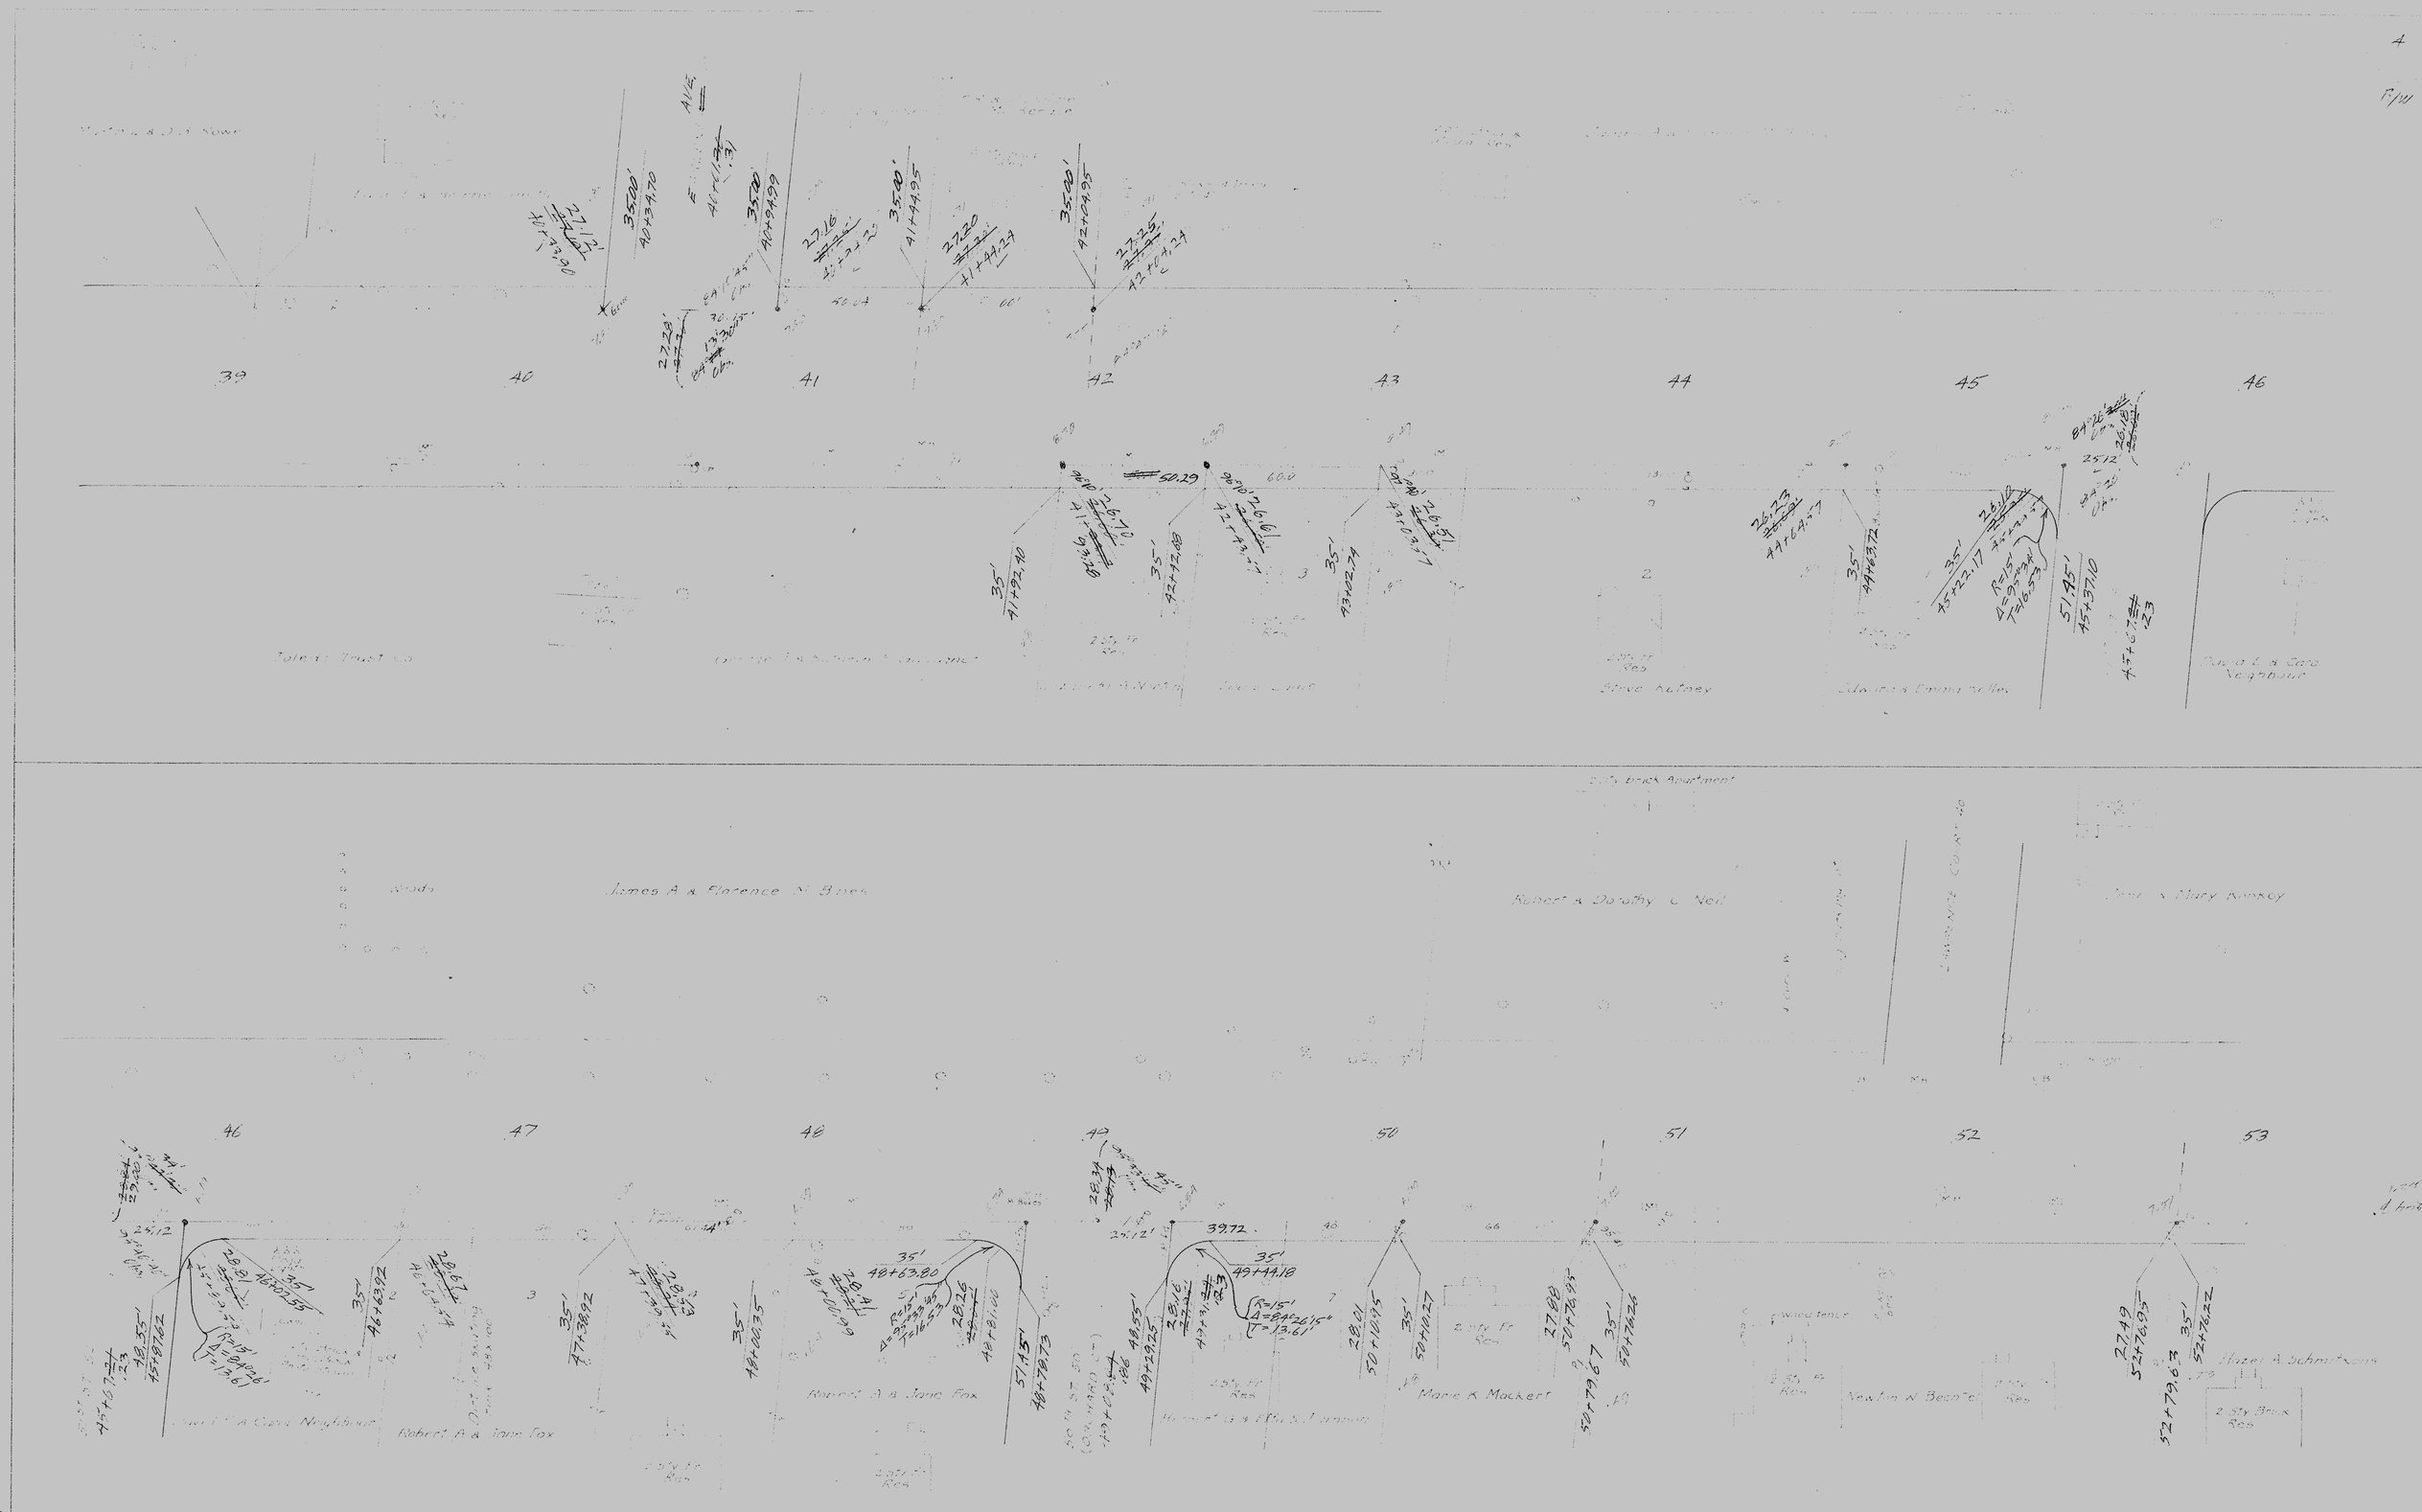
39
40
41
42
43
44
45
46
Toledo Trust Co
Steve Petosky
Clarence & Florence Emmanuelle
Douglas & Carol Neighbour
46
47
48
49
50
51
52
53
James A & Florence M Brock
Robert & Dorothy C Neil
Joan & Mary Ronkoy
Robert A & Jane Fox
Marie K Mackert
Newton W Beaton
Hazel A Schmitkons