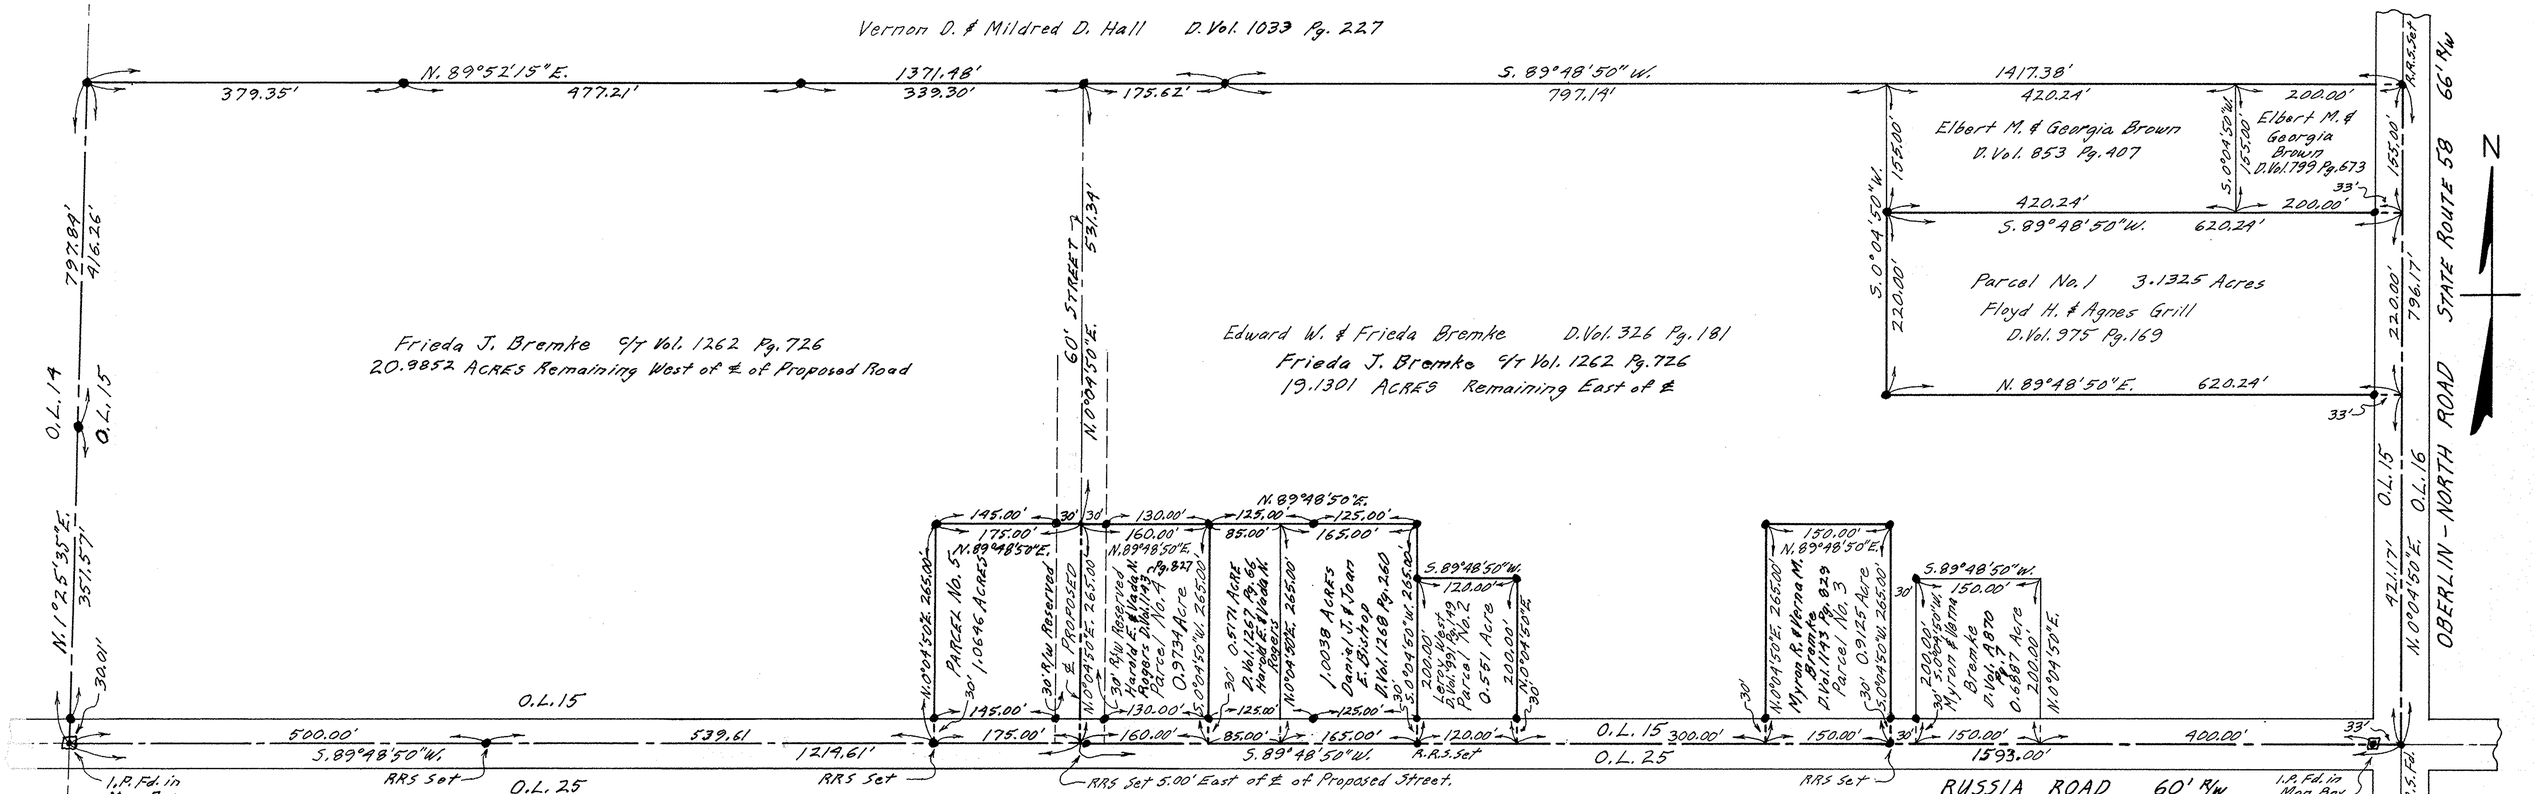

PARCEL NO. 5 AND REMAINING ACREAGE SURVEYED OCTOBER OF 1980 FOR FRIEDA J. BREMKE

NOTE: • indicates iron pin set unless otherwise designated.

Gary E. Penfound
Reg. Surveyor No. 4457

PLAT OF SURVEYS FOR
EDWARD W. BREMKE AND MYRON BREMKE
ORIGINAL LOT 15 RUSSIA TOWNSHIP
LORAIN COUNTY OHIO
SCALE: 1" = 100' OCT. 28-NOV. 4, 1968

PARCELS NOS. 3 AND 4 SURVEYED JANUARY-1975.