DETAIL SHEET OF PART OF
ORIG. LOT 110 - SHEFFIELD TWP.
LORAIN COUNTY - OHIO
DETAIL SCALE: 1"=30'
JUNE 11-1965 3:30 P.M.
Gary E. Penfound REG. SURVEYOR
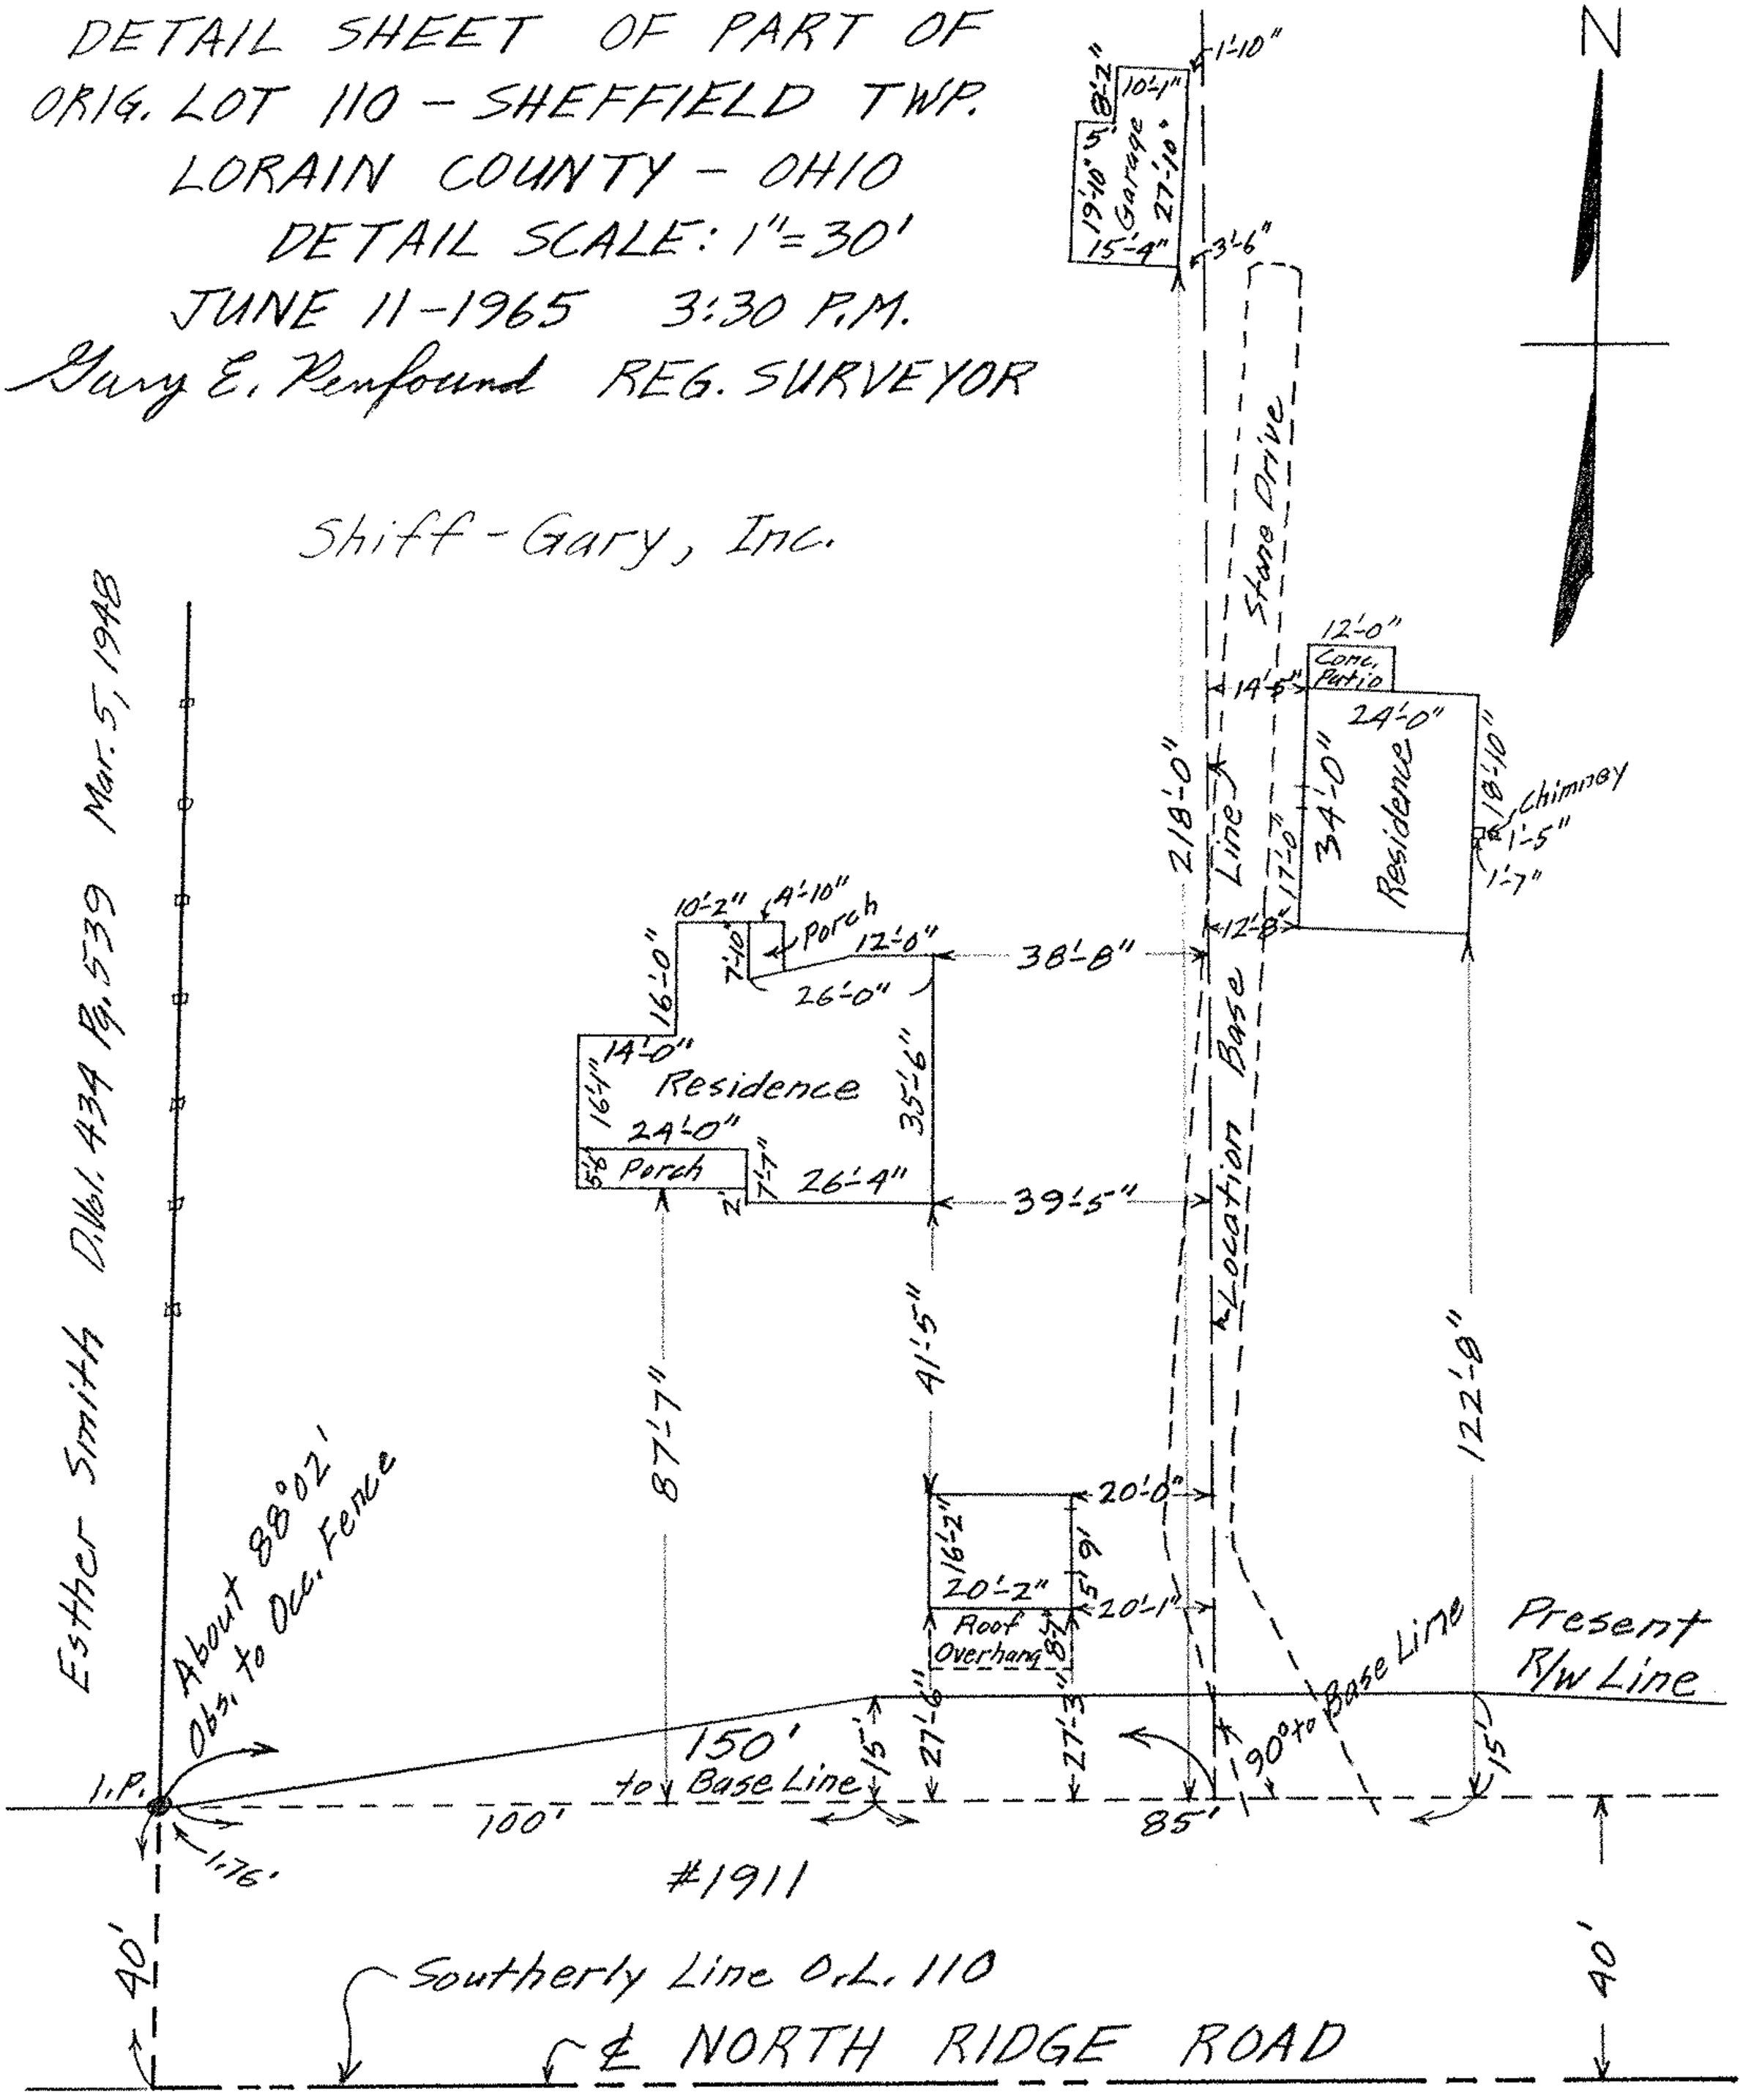
Shiff-Gary, Inc.