DETAIL SHEET OF PART OF
ORIG. LOT 110 - SHEFFIELD TWP.
LORAIN COUNTY - OHIO
DETAIL SCALE: 1"=30'
JUNE 11 - 1965 3:30 P.M.
Harry E. Rainford REG. SURVEYOR
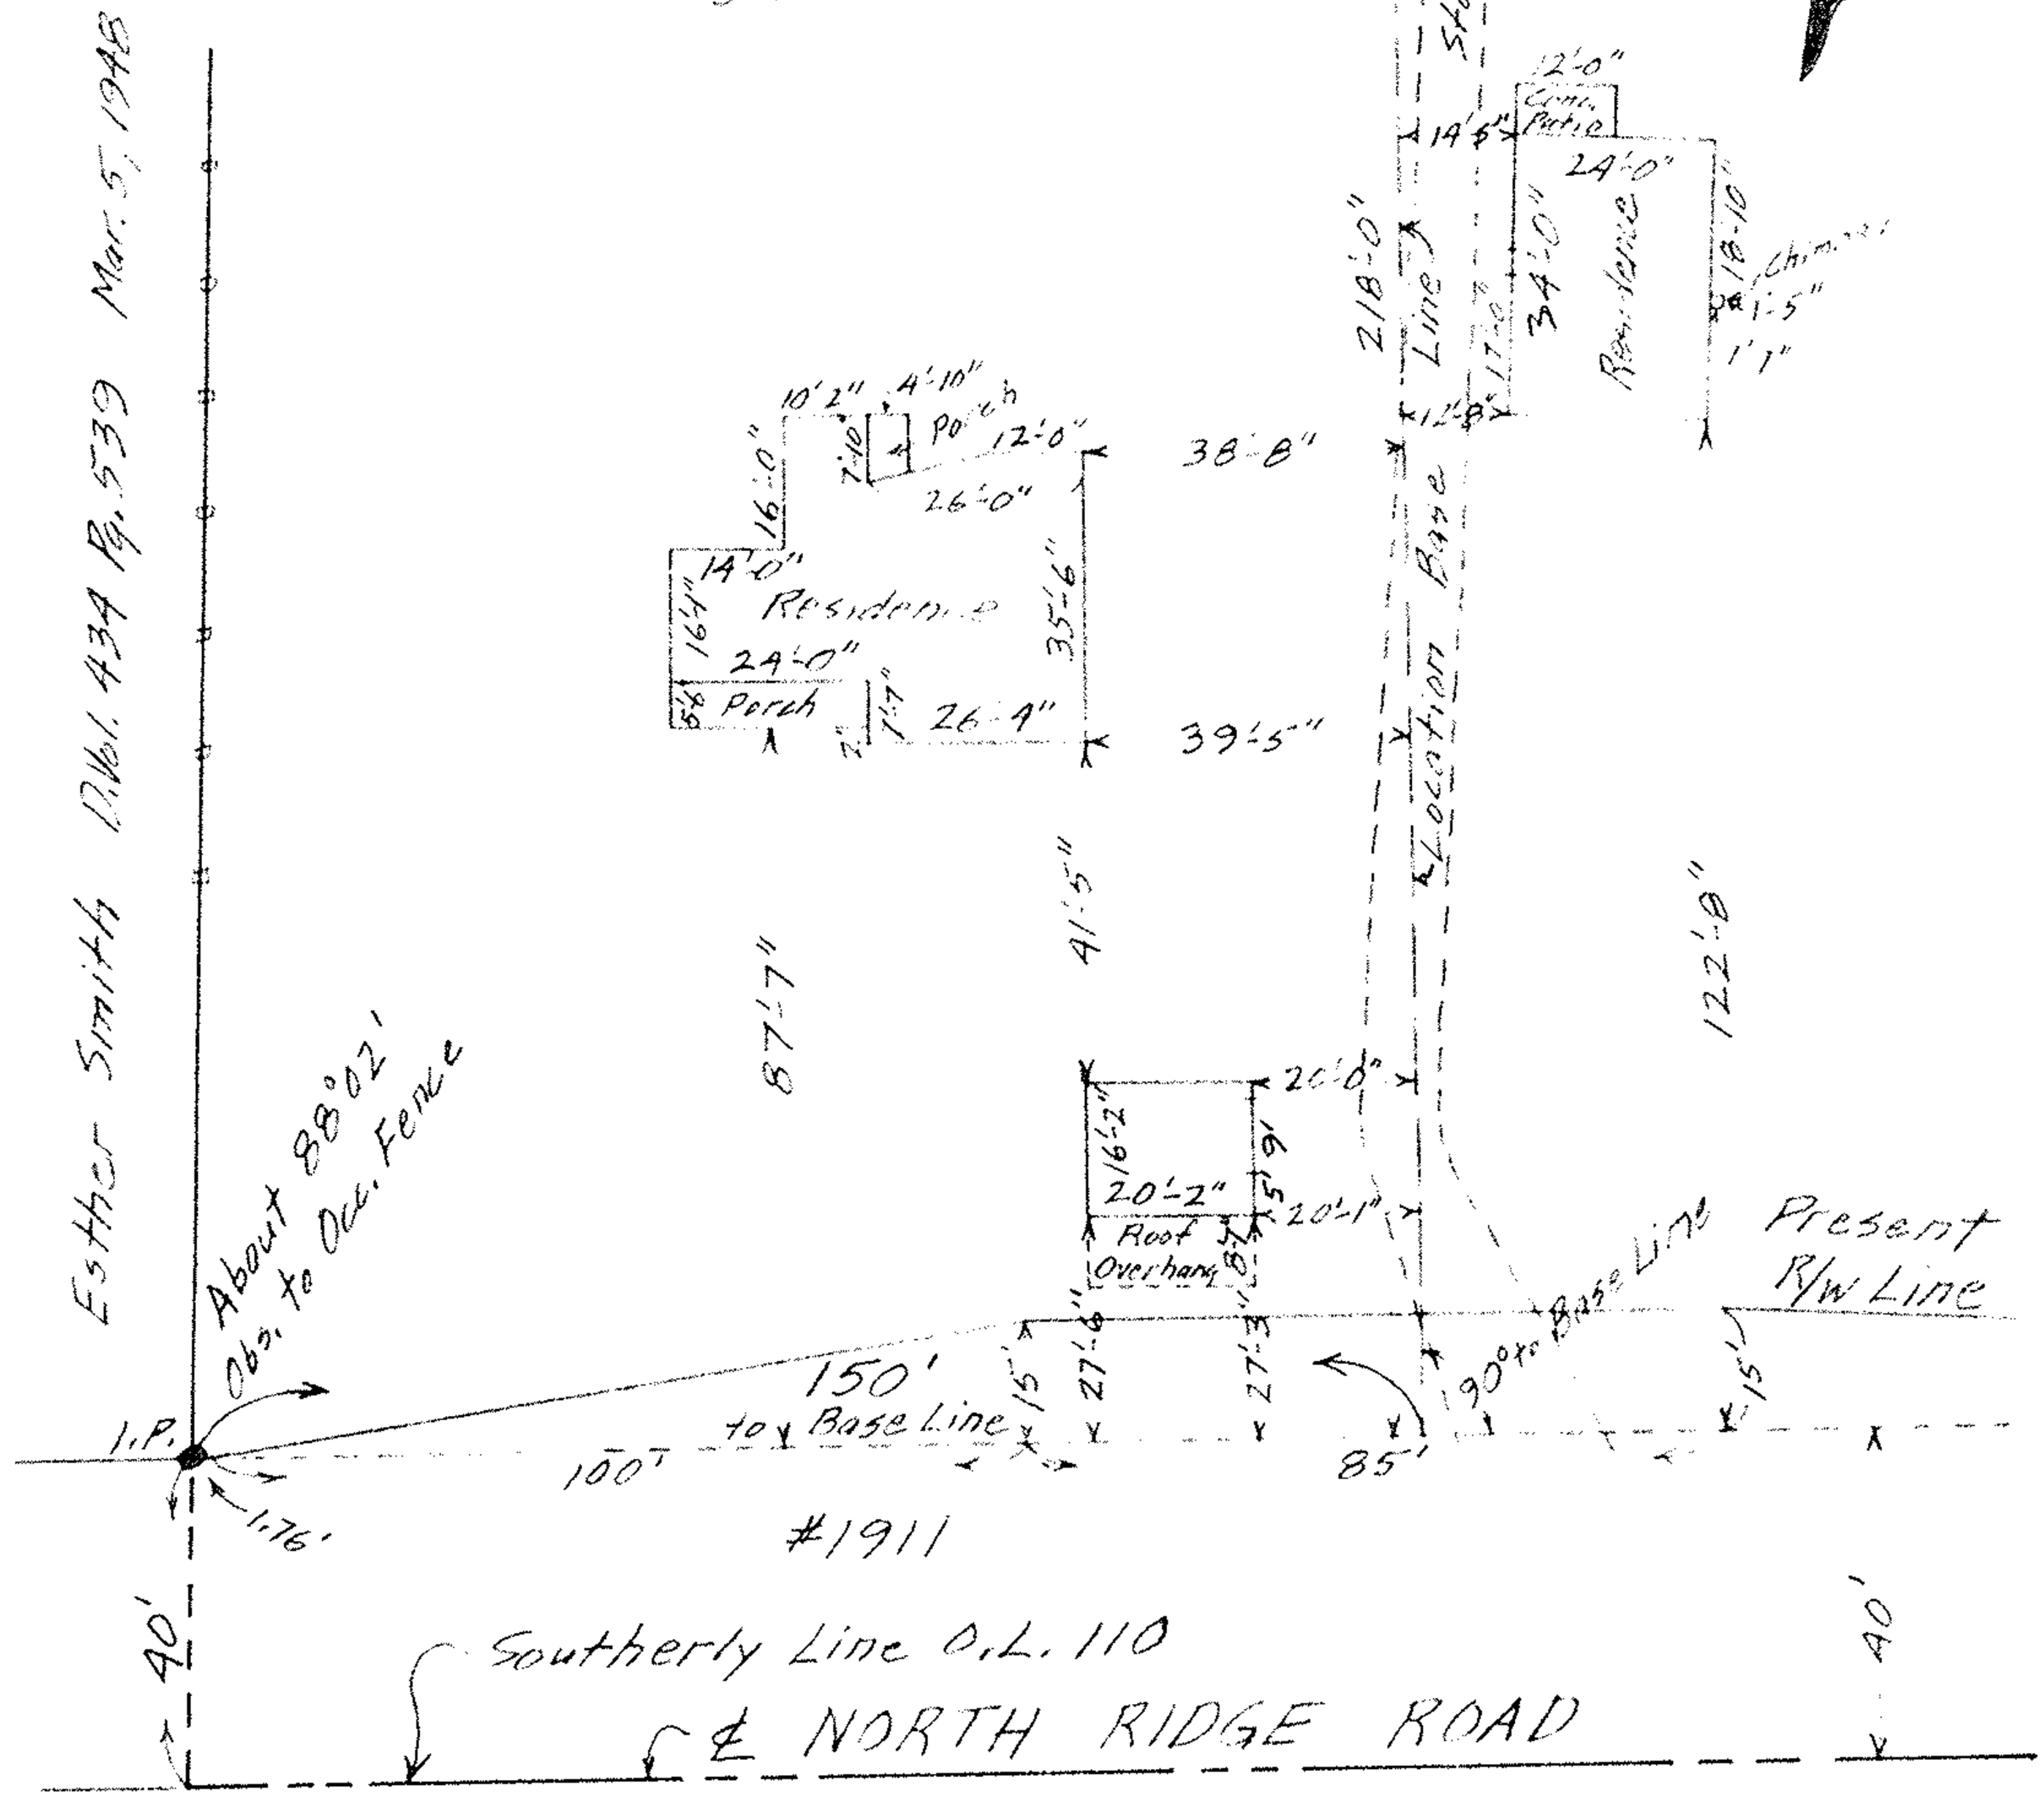
Shaff - Gary, Inc.