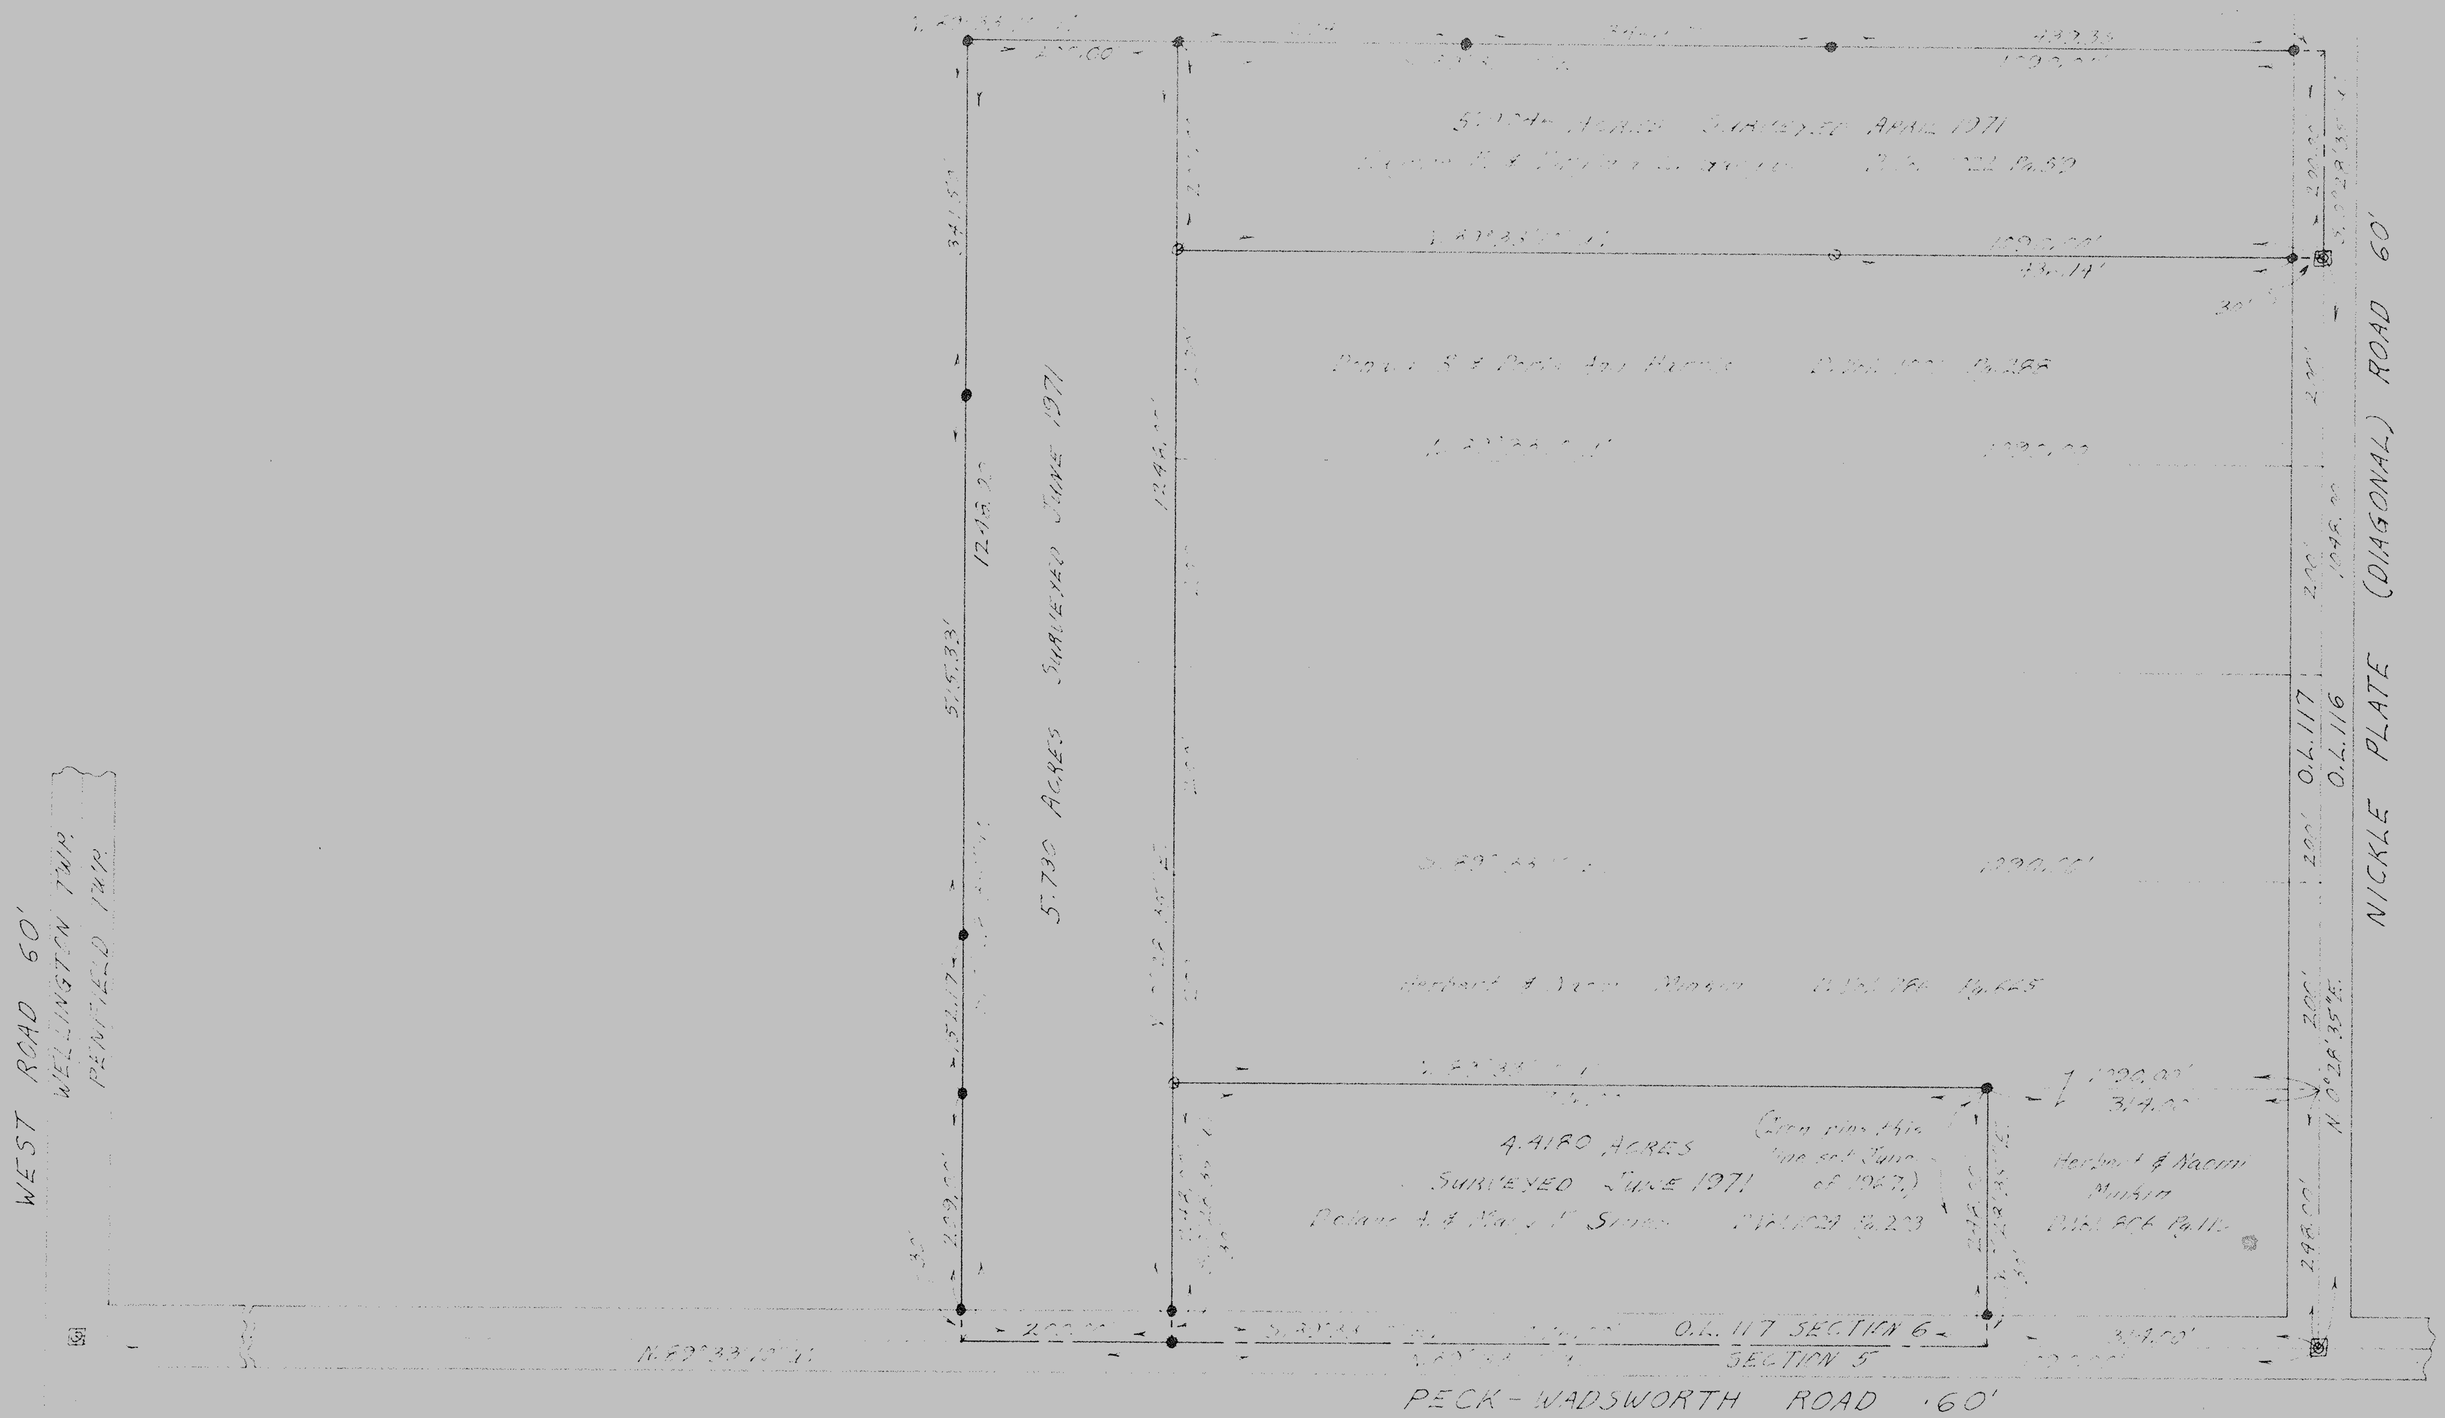

Notes: ● indicates iron pin set.
○ indicates iron pin found.
◎ indicates iron pipe found in monument box.

PLAT OF SURVEYED FOR
MYRON E. & ELINOR A. KOLBE
ORIGINAL LOT NO. 117 SECTION NO. 6
PENFIELD TWP. LORAIN COUNTY OHIO
SCALE 1" = 200'
Gary E. Pendland Reg. Surveyor No. 4457

N