NOTES: ● indicates iron pin set.
○ indicates railroad spike set

Gary E. Penfound
Reg. Surveyor No. 4457

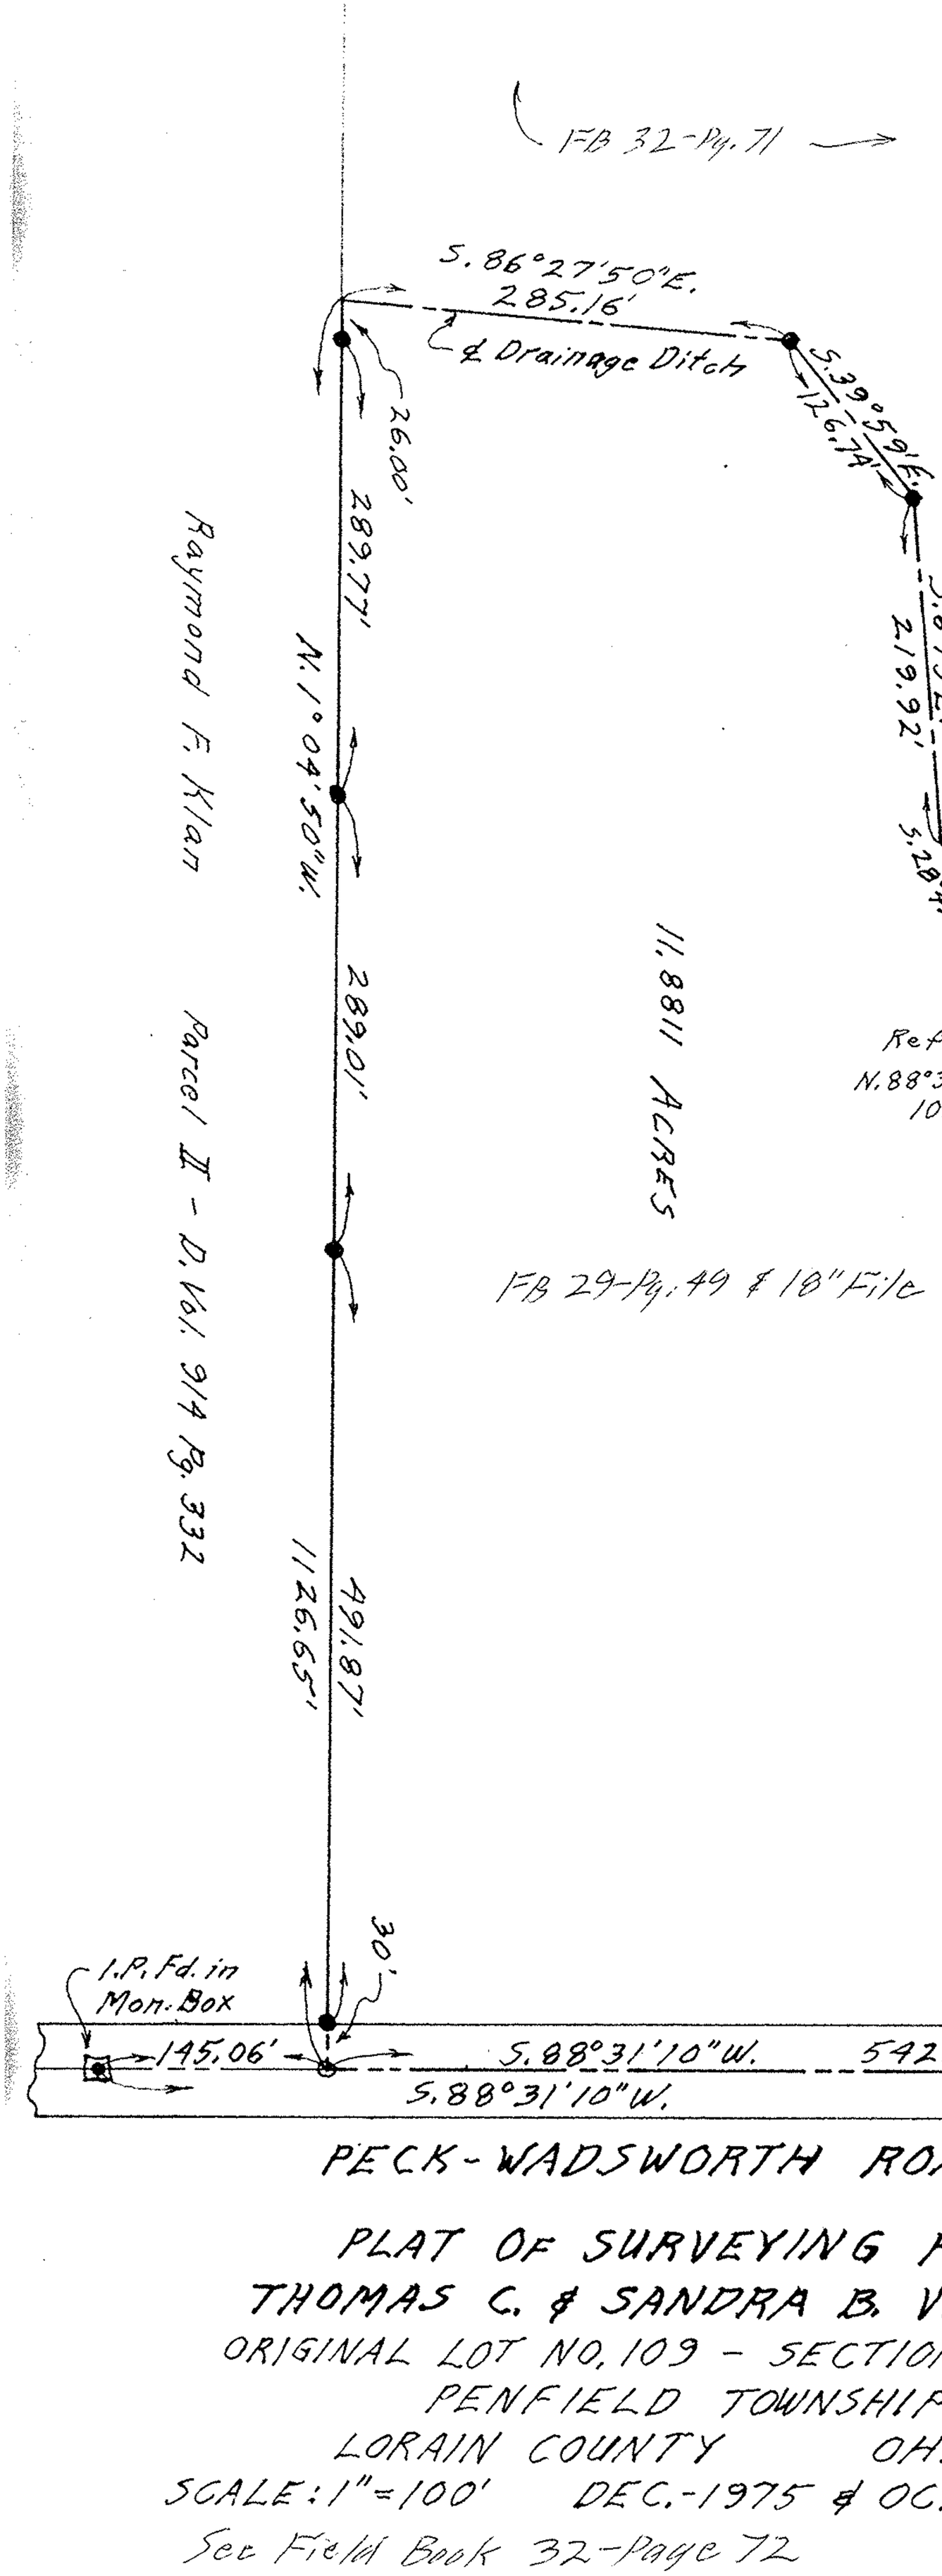

11.8811 ACRES

FB 29-Pg. 49 & 18" File

FB 32-Pg. 71

PECK-WADSWORTH ROAD 60'

PLAT OF SURVEYING FOR
THOMAS C. & SANDRA B. VIETS

ORIGINAL LOT NO. 109 - SECTION NO. 6
PENFIELD TOWNSHIP
LORAIN COUNTY OHIO
SCALE: 1" = 100' DEC.-1975 & OCT.-1979
See Field Book 32-Page 72