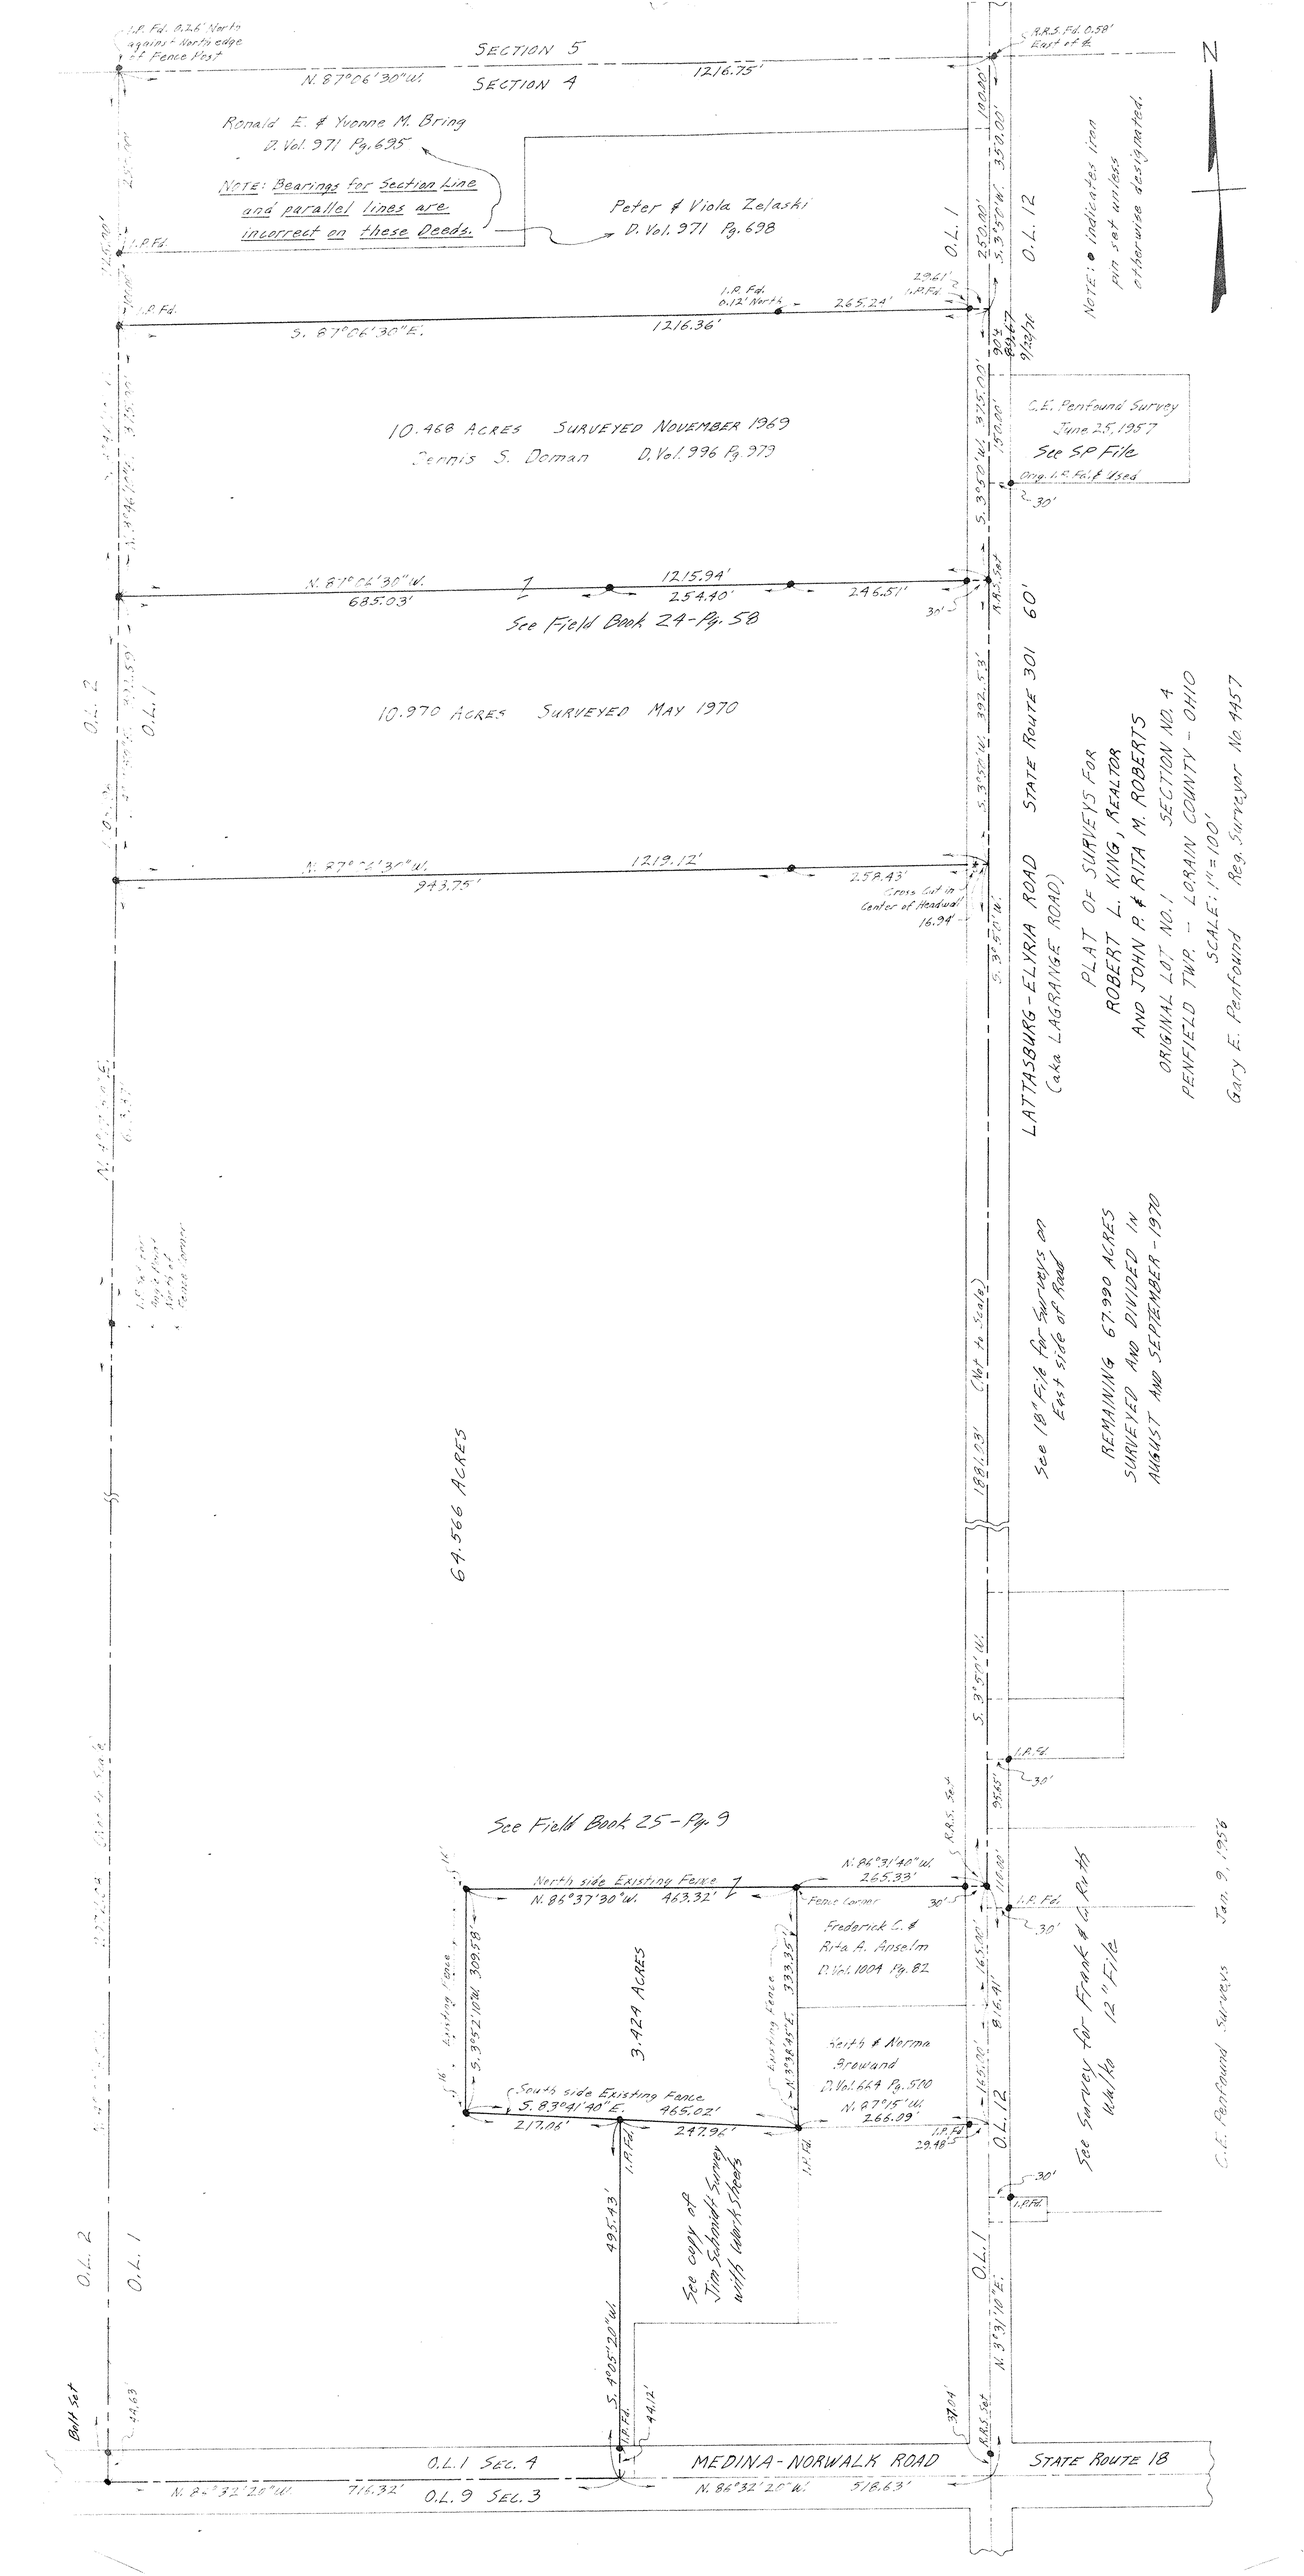
SECTION 5
SECTION 4
N. 87°06'30" W.
1216.75'
Ronald E. & Yvonne M. Bring
D. Vol. 971 Pg. 635
NOTE: Bearings for Section Line and parallel lines are incorrect on these Deeds.
Peter & Viola Zelaski
D. Vol. 971 Pg. 698
S. 87°06'30" E.
1216.36'
10.468 ACRES SURVEYED NOVEMBER 1969
Dennis S. Doman D. Vol. 996 Pg. 373
N. 87°06'30" W.
685.03'
1215.94'
254.40'
246.51'
See Field Book 24-Pg. 58
10.970 ACRES SURVEYED MAY 1970
N. 87°06'30" W.
943.75'
1213.12'
64.566 ACRES
See Field Book 25-Pg. 9
North side Existing Fence
N. 86°37'30" W. 463.32'
N. 86°31'40" W.
265.33'
Fence Corner
Frederick C. & Rita A. Anselm
D. Vol. 1004 Pg. 82
3.424 ACRES
South side Existing Fence
S. 83°41'40" E. 465.02'
217.06'
247.92'
Keith & Norma Brewand
D. Vol. 664 Pg. 510
N. 87°15' W.
266.09'
See copy of Jim Schmidt's Survey with Land Stakes
O.L. 1
O.L. 2
O.L. 12
O.L. 1 SEC. 4
O.L. 9 SEC. 3
MEDINA-NORWALK ROAD
STATE ROUTE 18
STATE ROUTE 301
LATTASBURG-ELYRIA ROAD
(aka LAGRANGE ROAD)
PLAT OF SURVEYS FOR
ROBERT L. KING, REALTOR
AND JOHN P. & RITA M. ROBERTS
ORIGINAL LOT NO. 1 SECTION NO. 4
PENFIELD TWP. - LORAIN COUNTY - OHIO
SCALE: 1" = 100'
Gary E. Penfound Reg. Surveyor No 4457
Note: ● indicates iron pin set unless otherwise designated.
C.E. Penfound Survey June 25, 1957
See SP File
Orig. I.P. Fd. & Used
See 18" File for Surveys on East side of Road
REMAINING 67.990 ACRES
SURVEYED AND DIVIDED IN
AUGUST AND SEPTEMBER - 1970
See Survey for Frank & L. Roberts
W.O. No 12" File
C.E. Penfound Surveys Jan. 9, 1958
N. 2°32'20" W.
716.32'
N. 86°32'20" W.
518.63'
N. 3°31'10" E.
S. 4°05'20" W.
493.43'
44.12'
I.P. Fd.
R.R.S. Set
Bolt Set